Section 6 Township 3 North Range 2 West of 4th P. M.

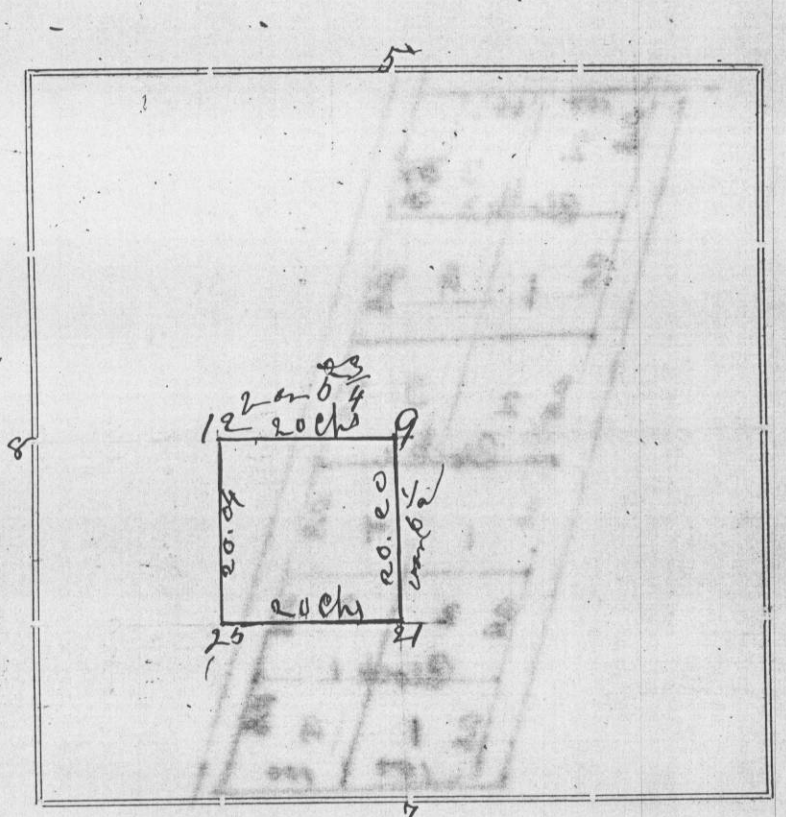

Corners	Bearing Trees	In. Dia.	Courses they Bear	Links Distant	REMARKS
9	Rd Stone at corner				Intersection of line 5 to 7 with 8 to 12 prolonged
12	"Located" by J. C. Scott in 1881				on page 98 this volume
21	" " " "				Equidistant from 9 & 7
25	" "Located" by Scott in 1881				See page 98 this volume

CERTIFICATE OF SURVEY.

STATE OF WISCONSIN, GRANT COUNTY, } ss.

I, Charles Sampson, County Surveyor in and for the County and State aforesaid, do hereby certify that I have executed the Survey represented by the foregoing Plat and annexed Field Notes of Survey, in accordance with the State Laws and Instructions of the Commissioner of the General Land Office. Scale, 80 chains to 4 inches. The figures in red ink are the lengths of the lines as stated in the Field Notes of the Government Survey.

Declination of the Magnetic Meridian from the True Meridian 5½ East. The variation of needle adopted in establishing corners is 6½ East.

WITNESS my hand this 30th day of December A. D. 1904

_____ } Chainmen.

C. C. Sampson Surveyor.