Section 6 Township 3 North Range 4 West of 4th P. M.

300

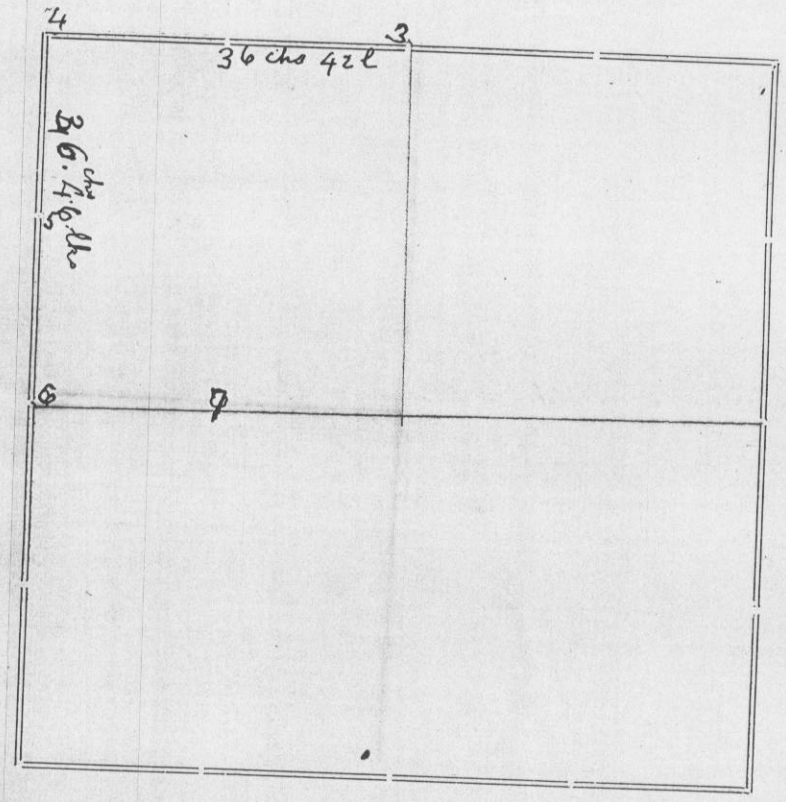

For J. H. Mills

Corners	Bearing Trees	In. Dia.	Courses they Bear	Links Distant	REMARKS
4					Gov cor Bearings plain
3					Gov ¼ cor
6	To cor of House Ver 34 SE			284	Gov. cor Bearings OK
5	Stake by Rock				
7					post

STATE OF WISCONSIN, GRANT COUNTY, } ss.

CERTIFICATE OF SURVEY.

I, Arthur A. Appleby, County Surveyor in and for the County and State aforesaid, do hereby certify that I have executed the Survey represented by the foregoing Plat and annexed Field Notes of Survey, in accordance with the State Laws and Instructions of the Commissioner of the General Land Office. Scale, 80 chains to 4 inches. The figures in red ink are the lengths of the lines as stated in the Field Notes of the Government Survey.

Declination of the Magnetic Meridian from the True Meridian ..... East. The variation of needle adopted in establishing corners is ..... East.

WITNESS my hand this 20th day of Oct A. D. 1905

Herman Elscamp
Wm Oakleaf } CHAINMEN.

A. W. Appleby SURVEYOR.