Section 27 Township 4 North Range 3 West of 4th P. M.

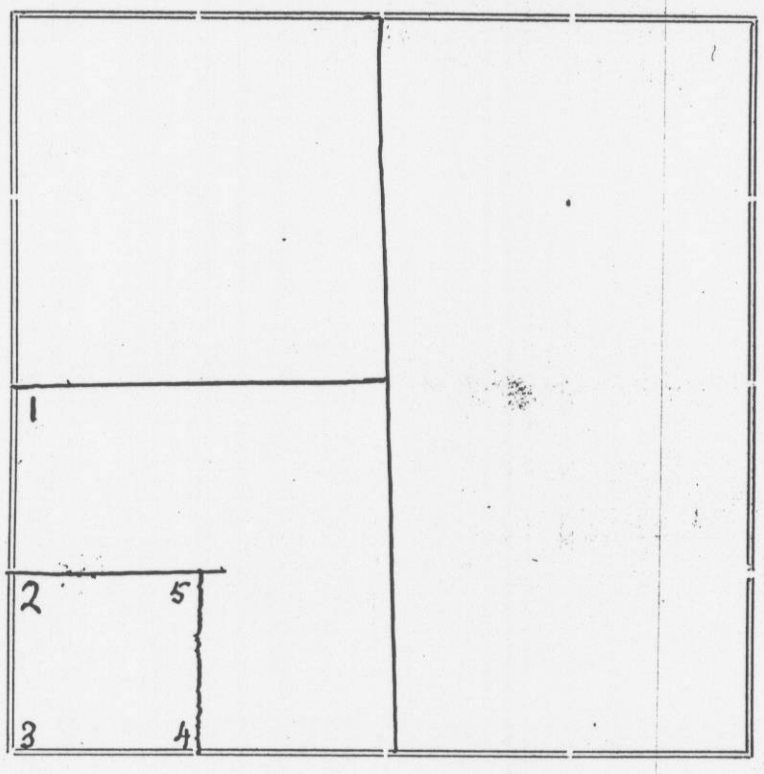

For C. A. Case

Corners	Bearing Trees	In. Dia.	Courses they Bear	Links Distant	REMARKS
					1 Stone in center of Highway
					2 " " " " "
					3 " " " " "
					4 Stone in Road
					5 Stake in Diam 4 in

CERTIFICATE OF SURVEY.

STATE OF WISCONSIN, } ss.
GRANT COUNTY, }

I, A. W. Appleby, County Surveyor in and for the County and State aforesaid, do hereby certify that I have executed the Survey represented by the foregoing Plat and annexed Field Notes of Survey, in accordance with the State Laws and Instructions of the Commissioner of the General Land Office. Scale, 80 chains to 4 inches. The figures in red ink are the lengths of the lines as stated in the Field Notes of the Government Survey.

Declination of the Magnetic Meridian from the True Meridian 6 ½ 7 East. The variation of needle adopted in establishing corners is 6 ½ 7 East.

WITNESS my hand this 4th day of April A. D. 1906

W. R. Kerr
Jo. Hartman } CHAINMEN.

Arthur W. Appleby SURVEYOR.