Section 28 Township _____ North Range _____ West of 4th P. M.

308

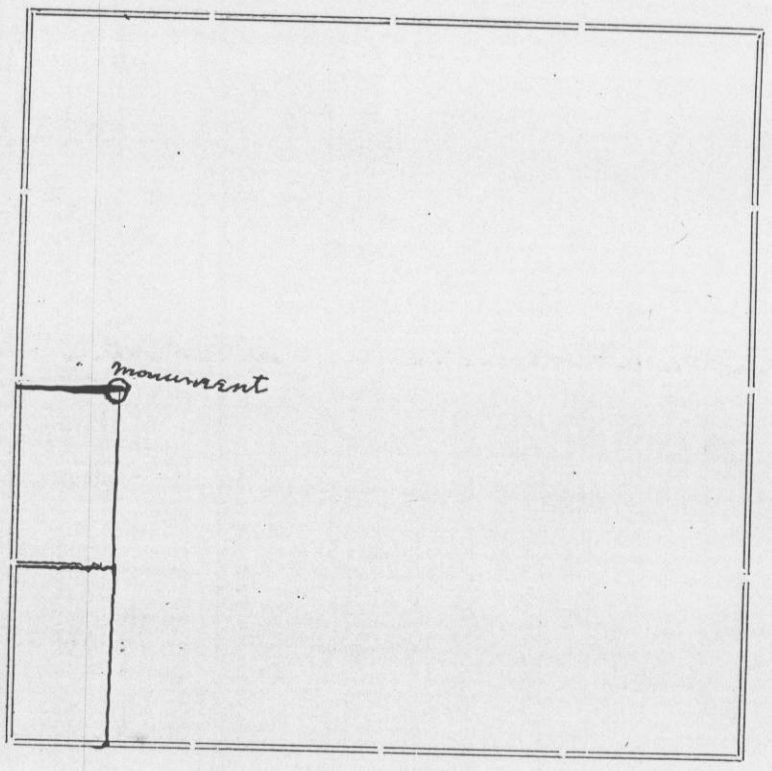

Corners	Bearing Trees Sled Shoe	In. Dia.	Courses they Bear	Links Distant	REMARKS
Brarng a Sled Shoe South	to the beginning point of Mt Hope is drove down 31 West 67½ L				Cor to Village of Mt Hope is Iron Sled Shoe With Stone Burried on top of Sled Shoe with top of stone above the ground it brong the N E¼ of S W ¼ of Sec 28 in Village of Mt Hope

CERTIFICATE OF SURVEY.

STATE OF WISCONSIN, GRANT COUNTY, } ss.

I, A. N. Appleby, County Surveyor in and for the County and State aforesaid, do hereby certify that I have executed the Survey represented by the foregoing Plat and annexed Field Notes of Survey, in accordance with the State Laws and Instructions of the Commissioner of the General Land Office. Scale, 80 chains to 4 inches. The figures in red ink are the lengths of the lines as stated in the Field Notes of the Government Survey.

Declination of the Magnetic Meridian from the True Meridian _____ East. The variation of needle adopted in establishing corners is _____ East.

WITNESS my hand this _____ day of _____ A. D. 18_____

_____ } CHAINMEN.

_____ SURVEYOR.