M. Section 27 Township 8 North Range 3 West of 4th P. M.

 

For Amral Gustbell

Corners	Bearing Trees	In. Dia.	Courses they Bear	Links Distant	REMARKS
					The South ½ of Lot no 2 of Block 41 of
					the City of Boscobel was Surveyed by me on
					the 18th of April 1911 And Ironsdrove down
					at all corners and also notches in cement walk on
					East end of same said ½ lot.

CERTIFICATE OF SURVEY.

STATE OF WISCONSIN, } ss.
GRANT COUNTY, }

I, A. W. Appleby, County Surveyor in and for the County and State aforesaid, do hereby certify that I have executed the Survey represented by the foregoing Plat and annexed Field Notes of Survey, in accordance with the State Laws and Instructions of the Commissioner of the General Land Office. Scale, 80 chains to 4 inches. The figures in red ink are the lengths of the lines as stated in the Field Notes of the Government Survey.

Declination of the Magnetic Meridian from the True Meridian ..... East. The variation of needle adopted in establishing corners is 0½ East.

WITNESS my hand this 28 day of April A. D. 1911

..... } CHAINMEN.
..... }

A. W. Appleby SURVEYOR.