


23 24  
26 25

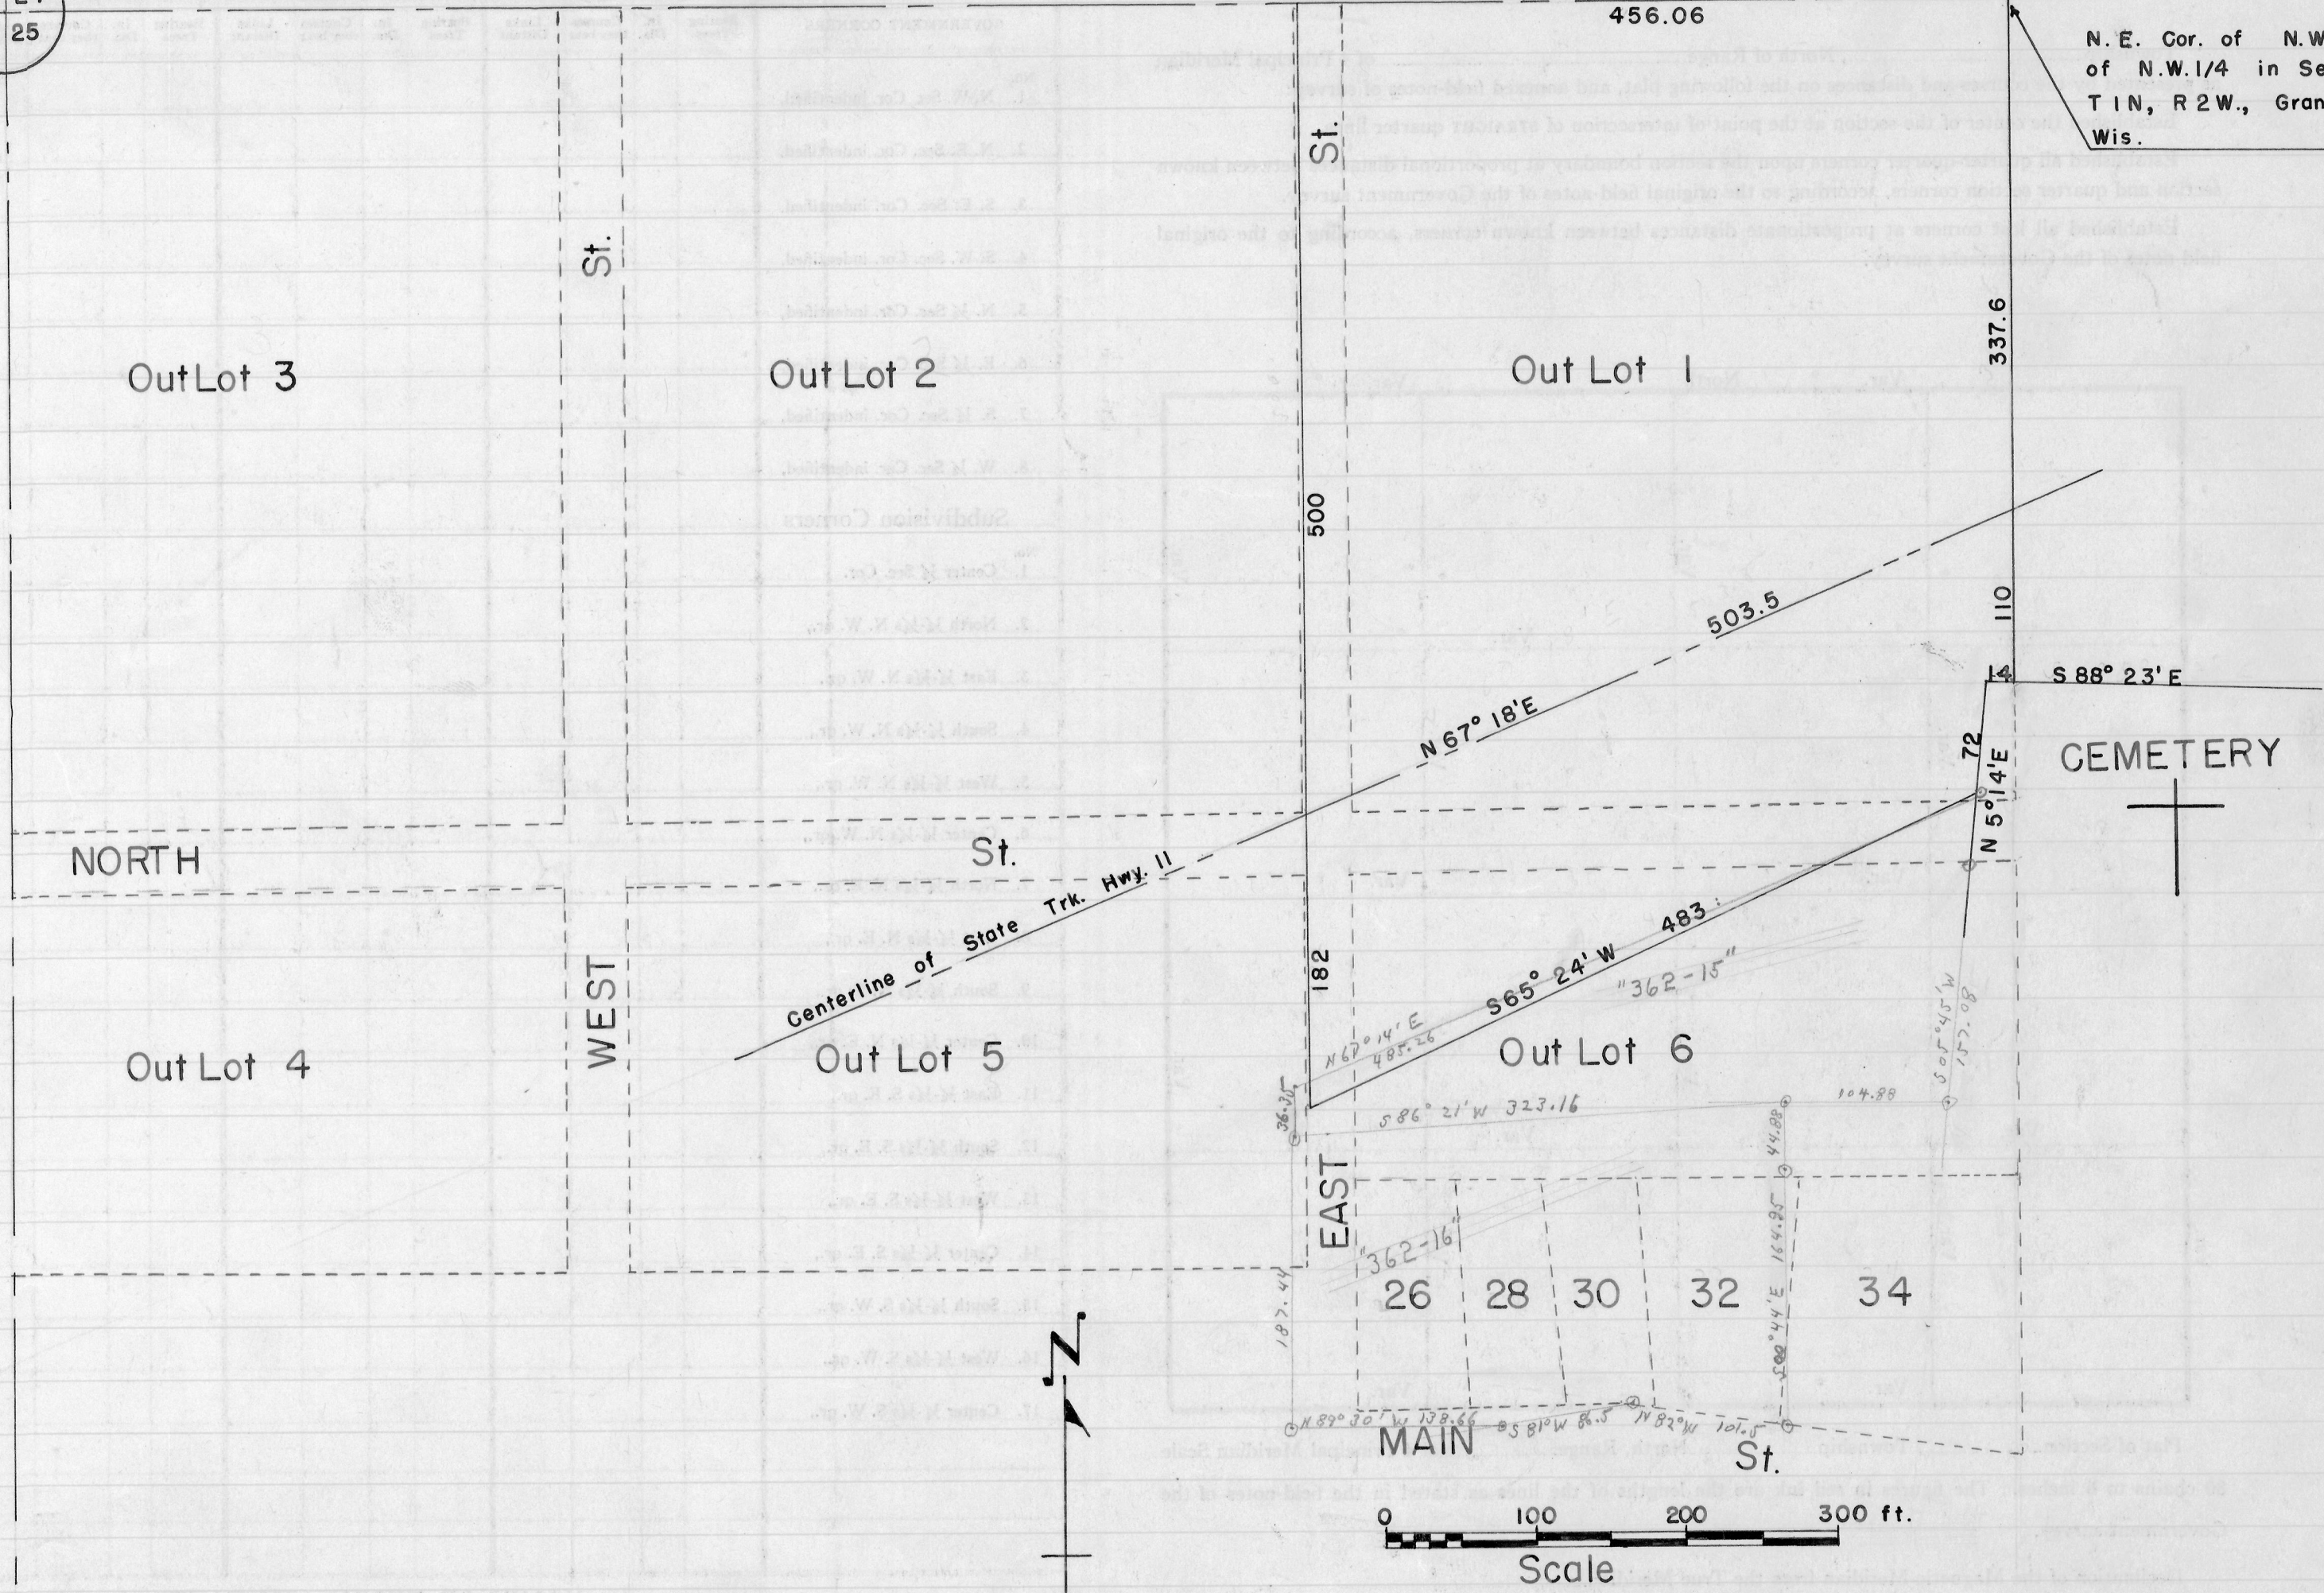

N. E. Cor. of N.W. 1/4  
of N.W. 1/4 in Sec. 25,  
T1N, R2W., Grant Co.,  
Wis.

S 88° 23' E

CEMETERY

72  
N 5° 14' E

N 67° 18' E

503.5

S 65° 24' W 483

"362-15"

N 67° 14' E 485.26

S 86° 21' W 323.16

"362-16"

26 28 30 32 34

MAIN St.

0 100 200 300 ft.

Scale

Plat of Village of Fairplay, Grant Co., Wis.