11-8-2

RICHLAND-GRANT TELEPHONE CO-OPERATIVE, INC.
SURVEY

Legal Description:
The South 40 feet of the West 39 feet of Lot 1; Also the South 9 feet of the East 61 feet of Lot 1 in Block 2; Also the North 20 feet of Lot 7 in Block 1, all in Homewood's Addtion to the Village of Blue River, Grant County, Wisconsin.

State of Wisconsin)
County of Grant) ss

I, Maurice P. Cook by direction of Homer D. Ralph, Jr., surveyor for Grant County, Wisconsin hereby certify that I have surveyed the above described property and that the map below is a true and correct representation of said survey.

Maurice P. Cook
Maurice P. Cook
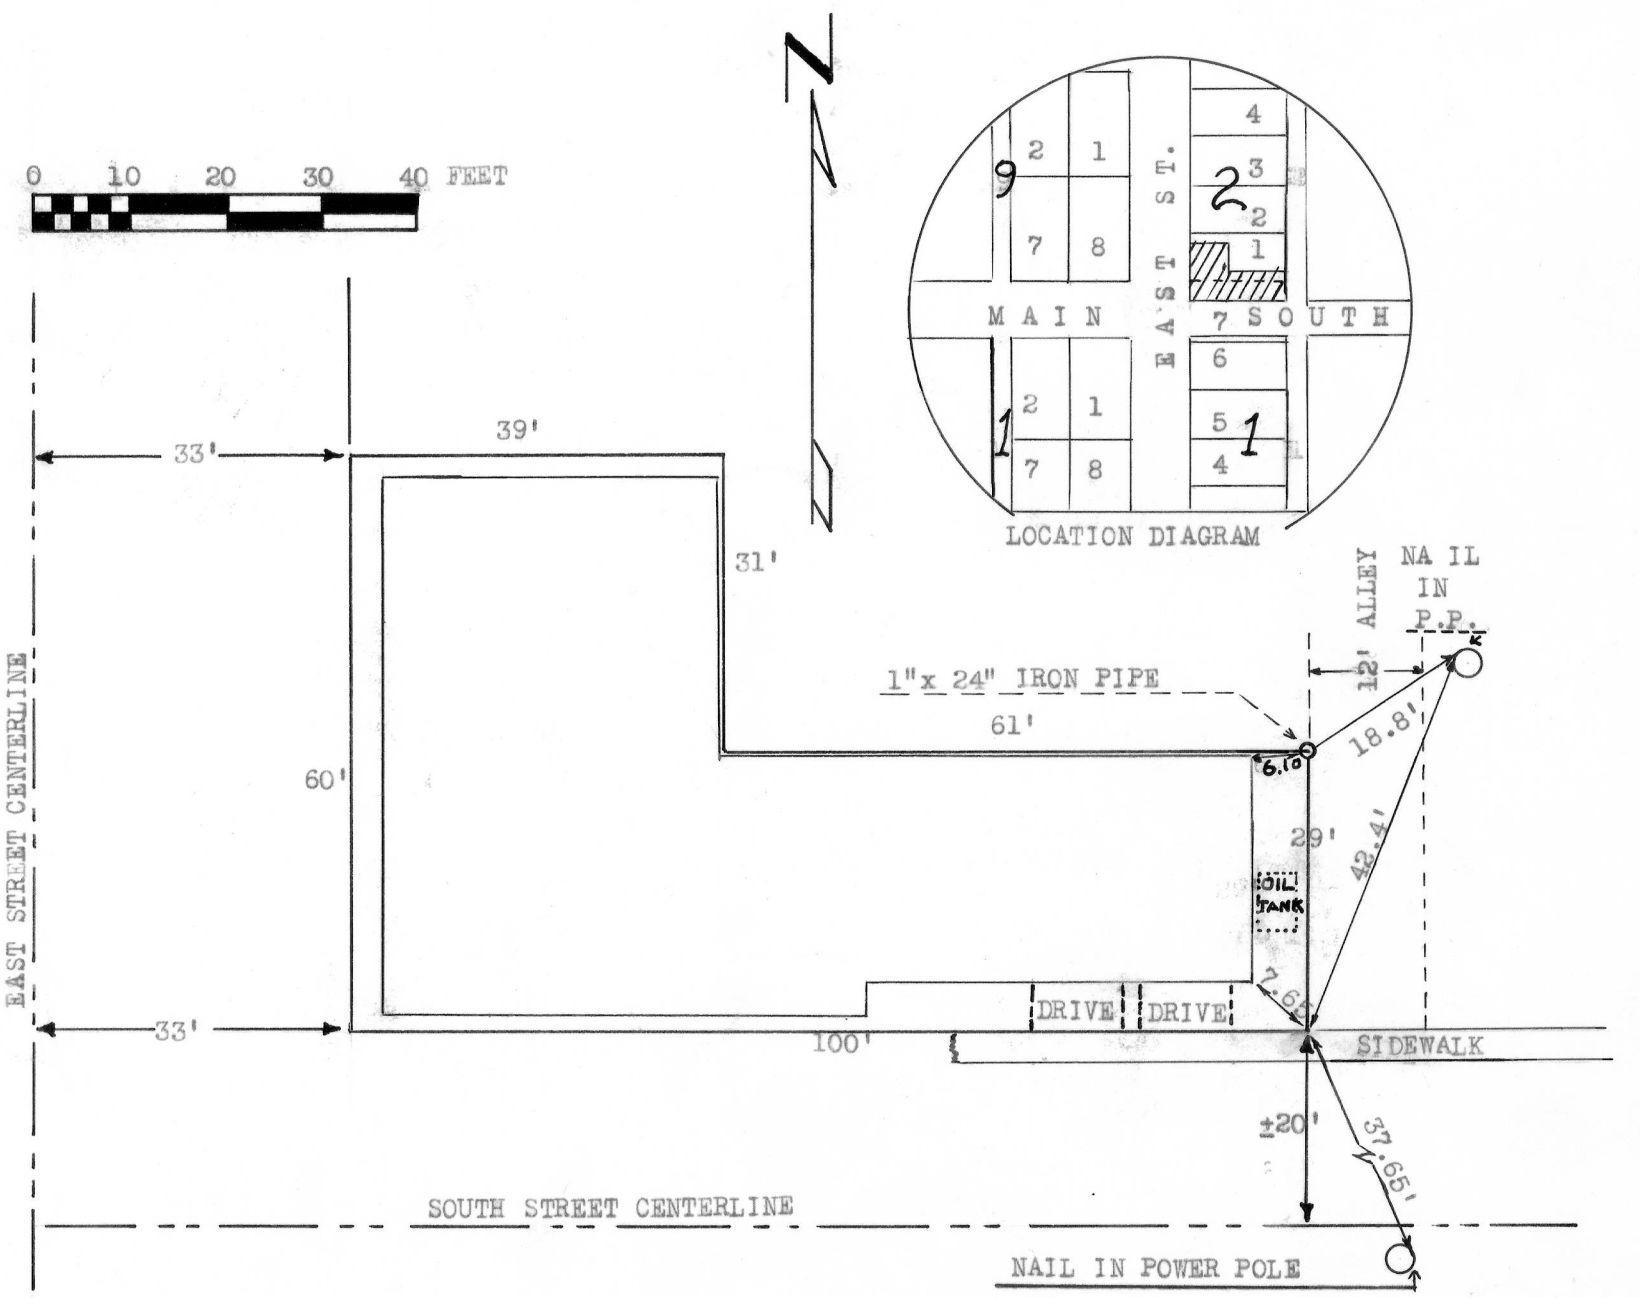
Homer D. Ralph, Jr.
Homer D. Ralph, Jr.
Surveyor for Grant Co., Wis.
Wis. Reg. No. S-141
1/21/66 1/25/66