



FARMERS TELEPHONE CO.

POTOSI, WISCONSIN

95

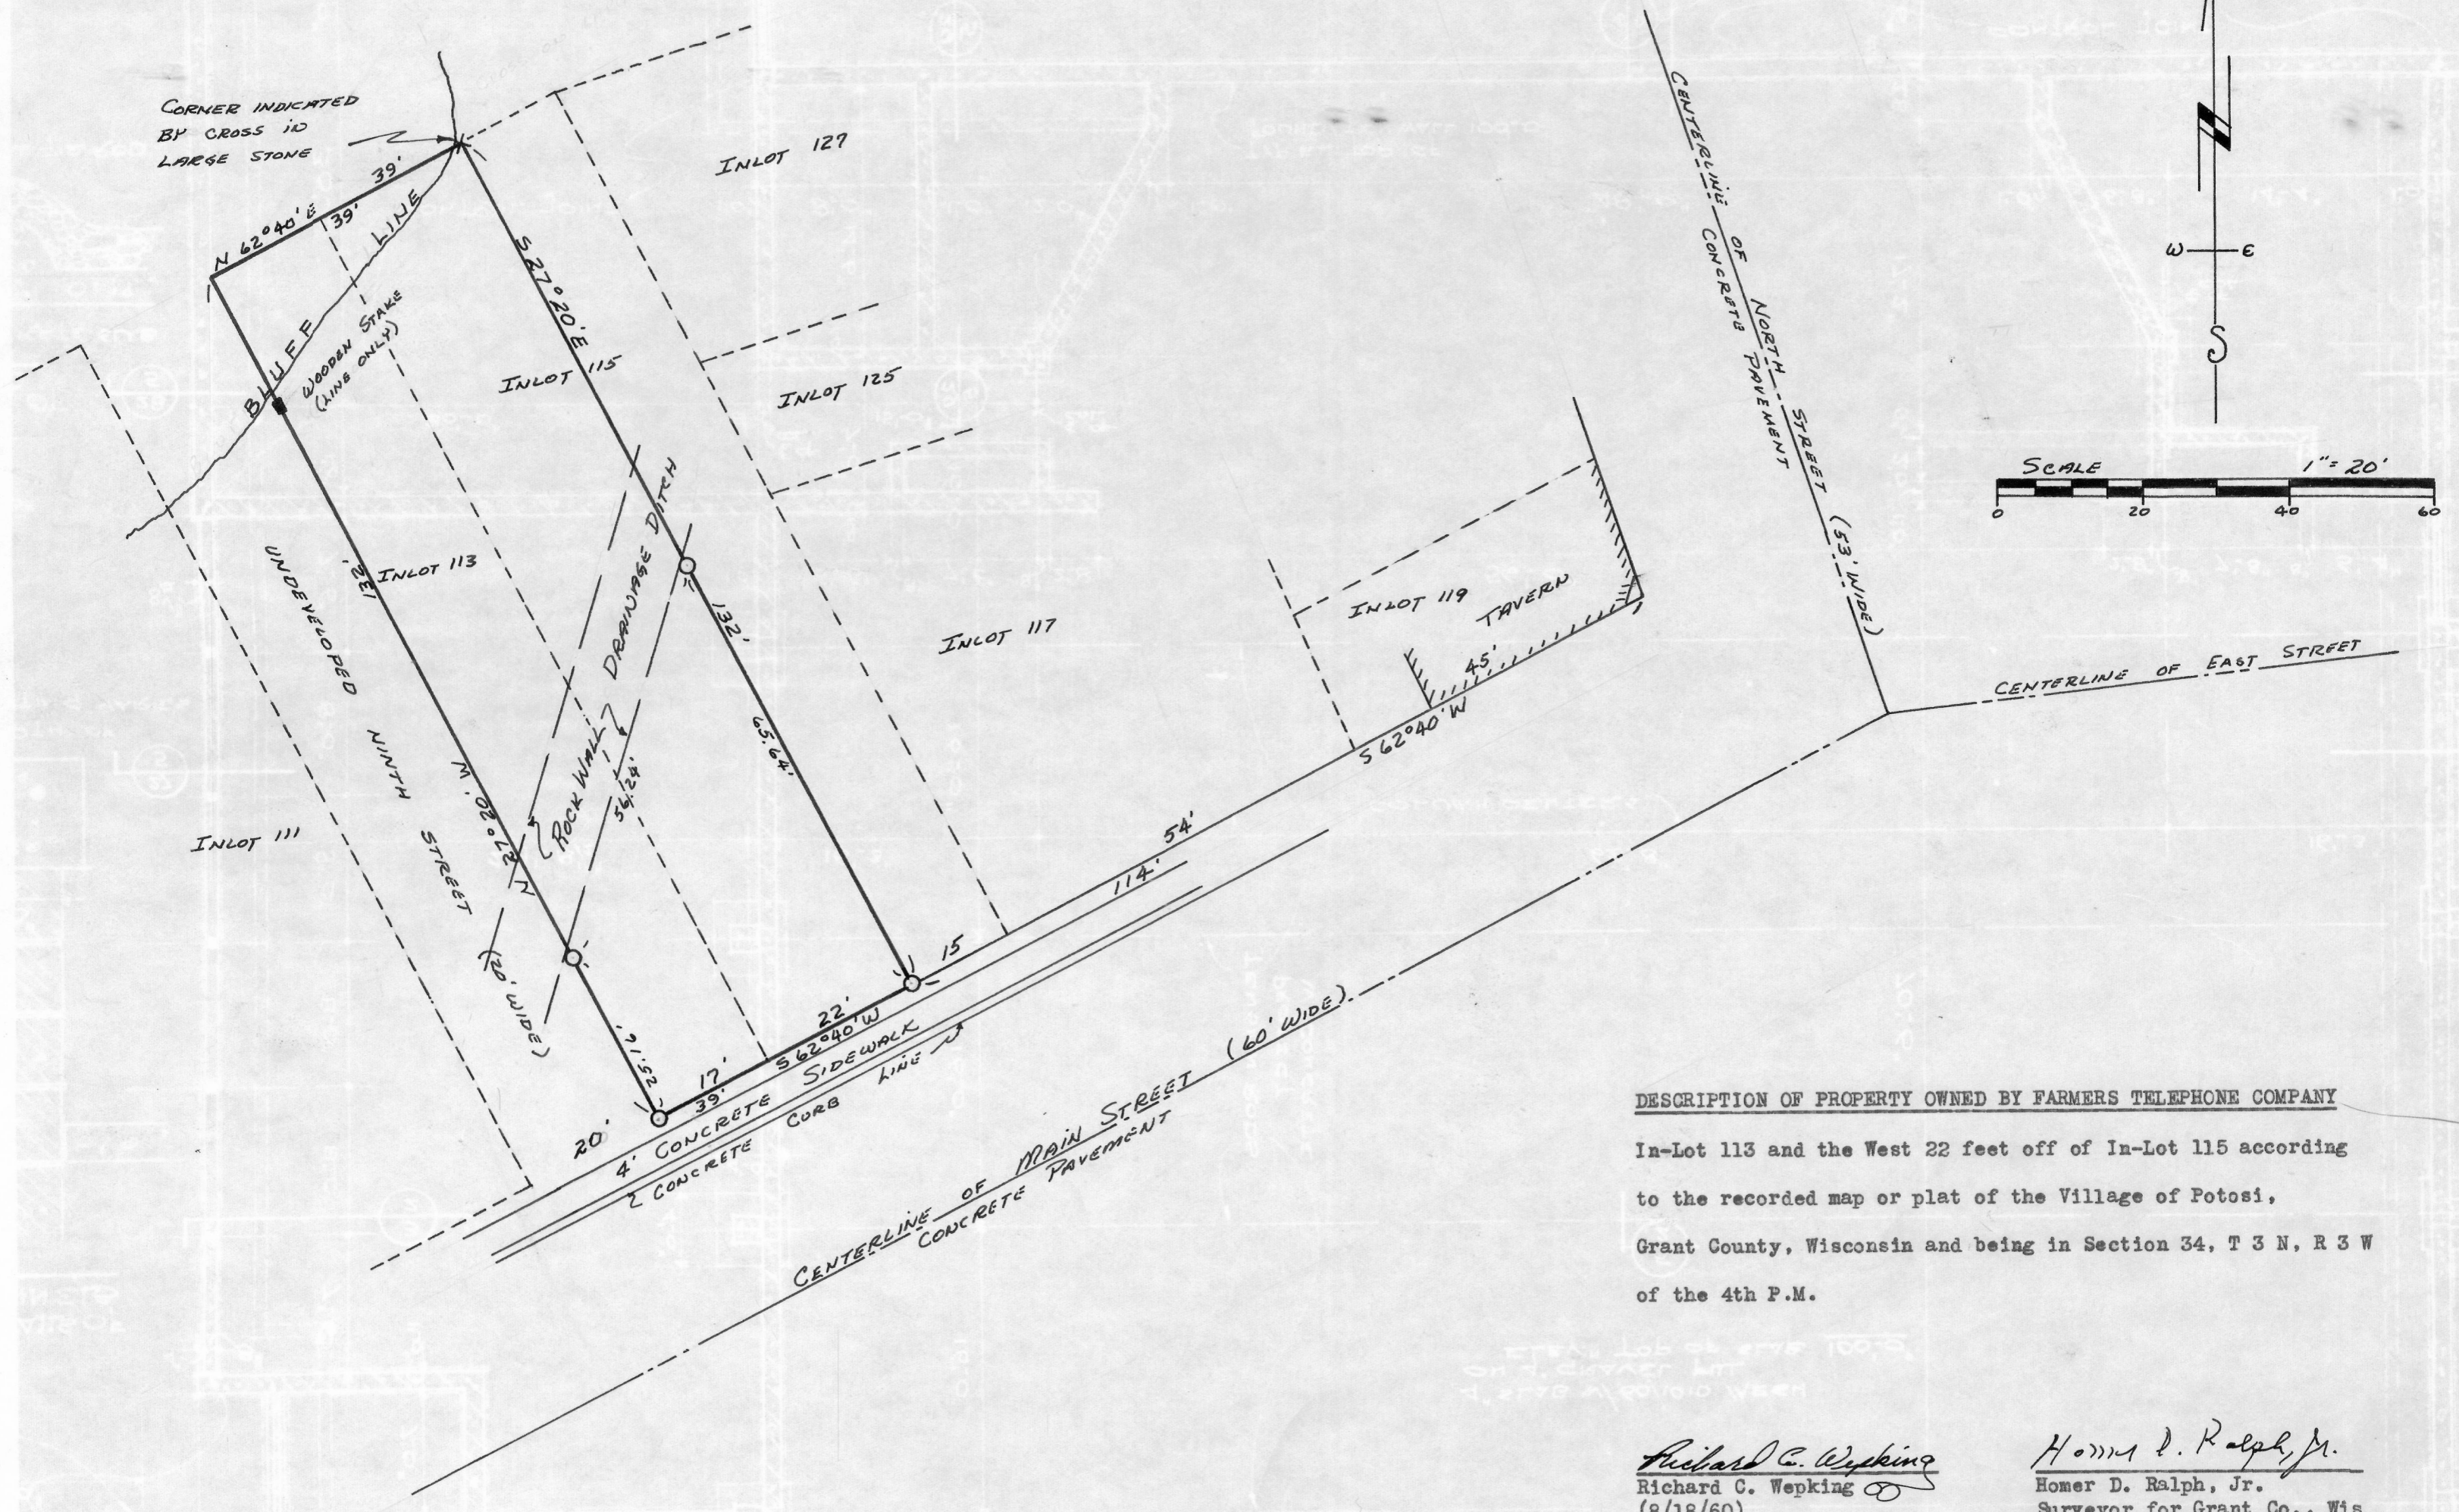

CORNER INDICATED BY CROSS ID LARGE STONE

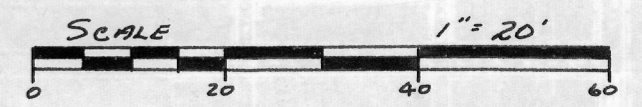

DESCRIPTION OF PROPERTY OWNED BY FARMERS TELEPHONE COMPANY
 In-Lot 113 and the West 22 feet off of In-Lot 115 according to the recorded map or plat of the Village of Potosi, Grant County, Wisconsin and being in Section 34, T 3 N, R 3 W of the 4th P.M.

Richard C. Wepking
 Richard C. Wepking
 (8/18/60)

Homer D. Ralph, Jr.
 Homer D. Ralph, Jr.
 Surveyor for Grant Co., Wis
 Wis. Reg. No. S-141
 (8/19/60)

○ INDICATES 1"x24" IRON PIPE PLACED BY THIS SURVEY.

