

SECTION QUARTER SECTION AND BOUNDARY QUARTER SECTION CORNERS



N.W. Corner of
S.W. 1/4 of Sec.
2, T4N, R3W

Fair Ground

(ELM St.)

ROAD

17.27 chains

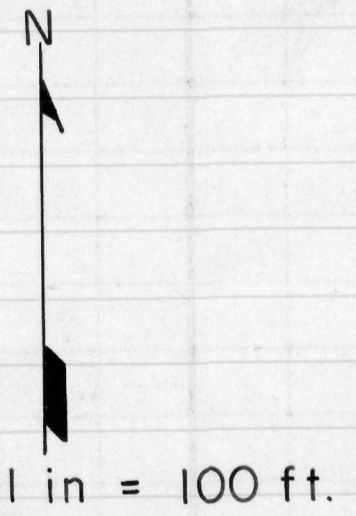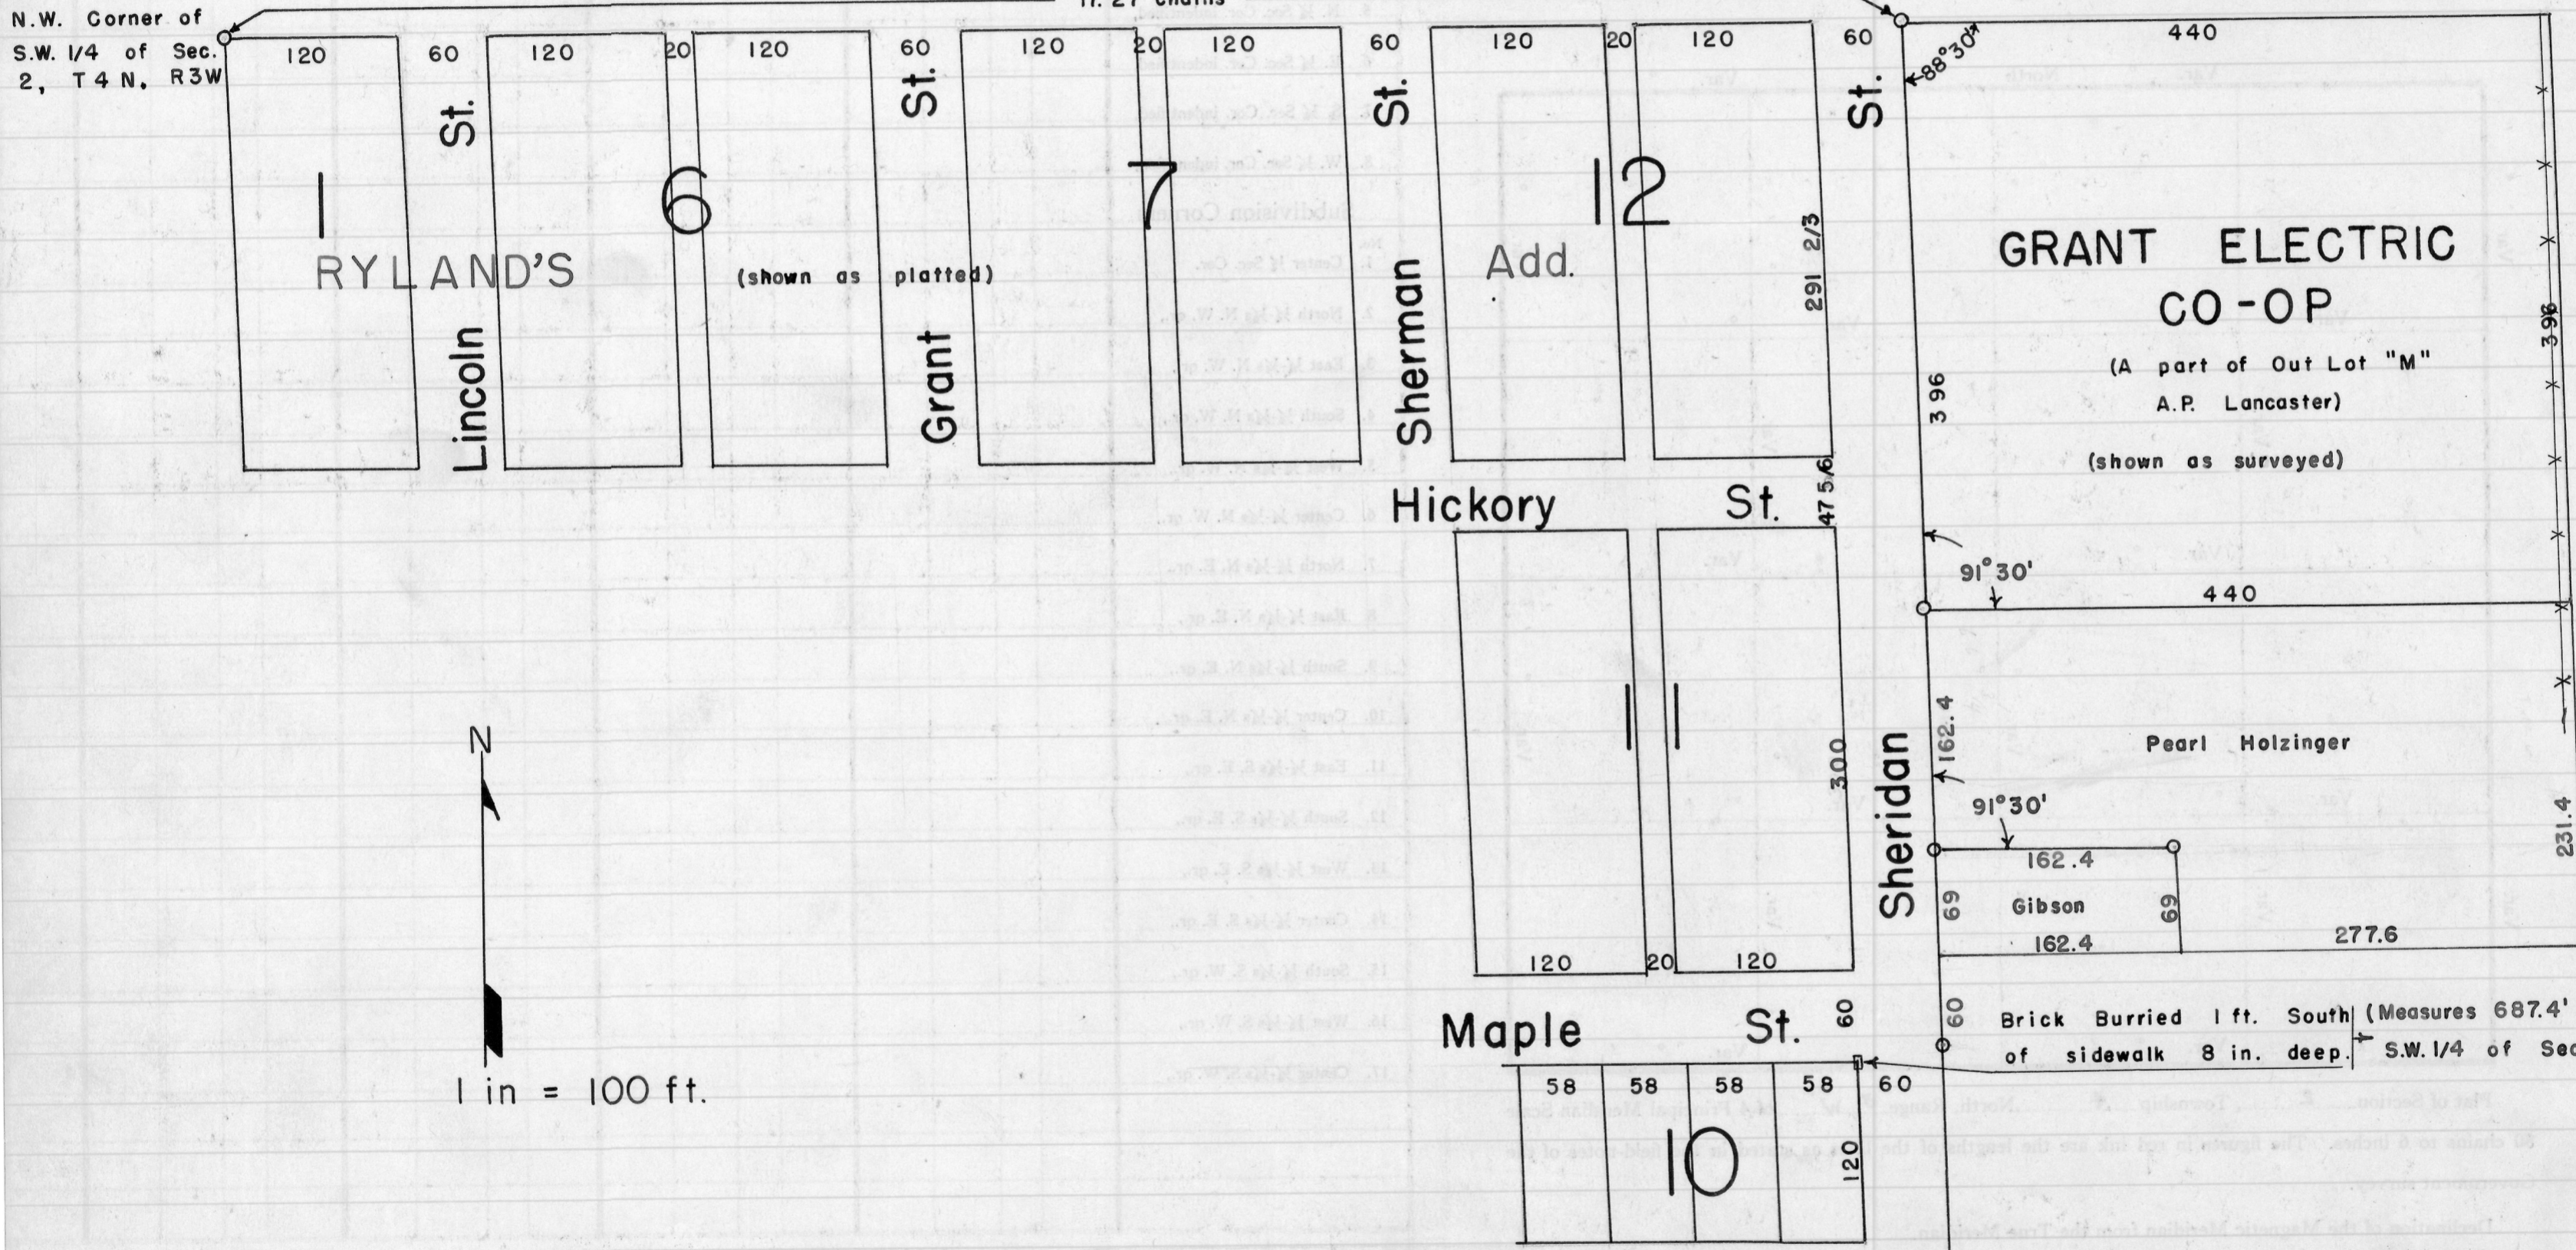

4 ft. from fence
to East line of
REA Lot

Brick Buried 1 ft. South of sidewalk 8 in. deep. (Measures 687.4' from N. Line of S.W. 1/4 of Sec. 2, T4N, R3W.)