126

CERTIFIED GROCERS of ILLINOIS

LANCASTER, WISCONSIN SITE

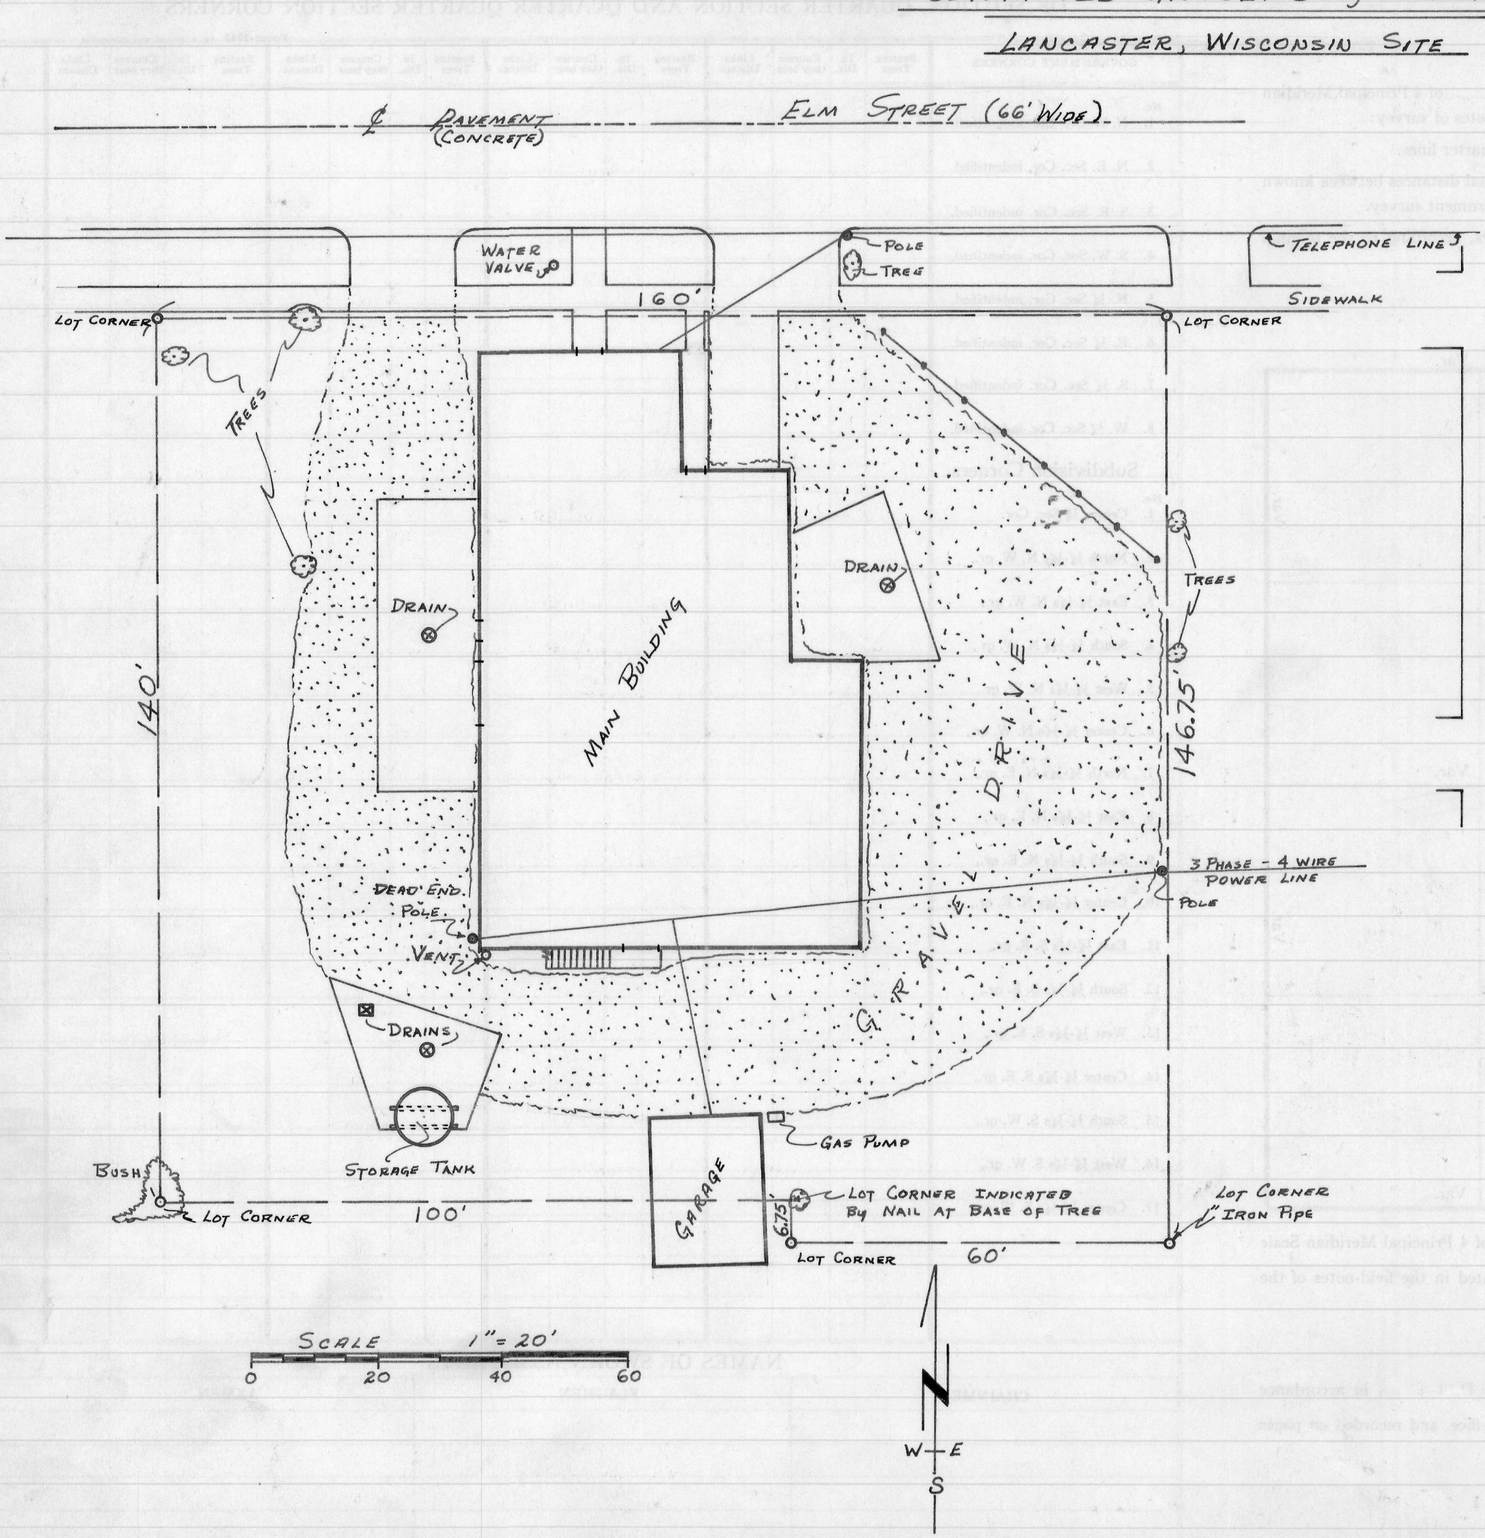

LOCATION DIAGRAM

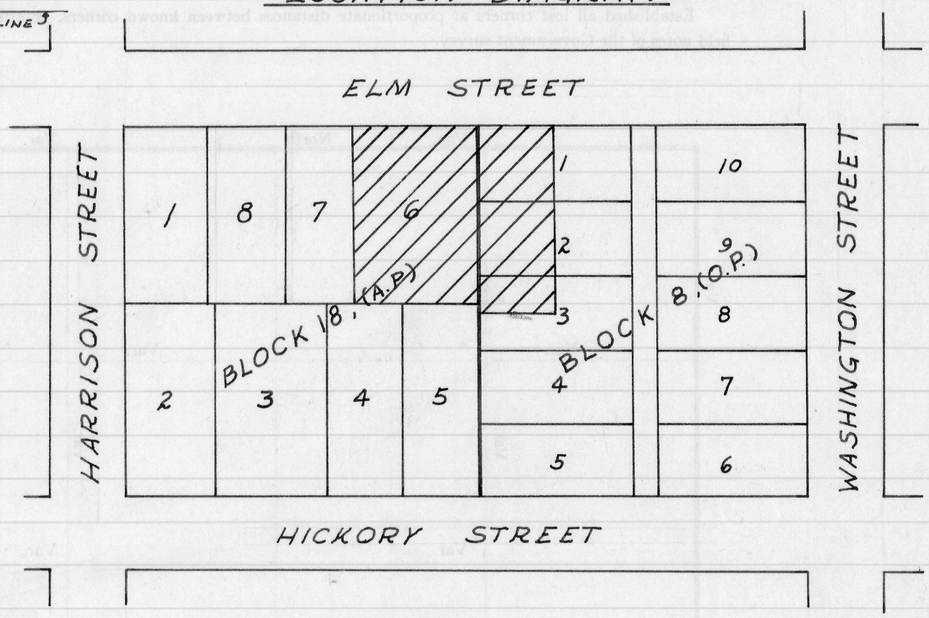

DESCRIPTION

Commencing at the Northwest corner of Block 8, Original Plat of the City of Lancaster; thence West. 100 feet; thence South. 140 feet; thence East. 100 feet; thence North. 140 feet to the place of beginning, and also the West 1/2 of Lots 1 and 2, and the Northwest 1/4 of Lot 3, all in Block 8 of the Original Plat of the Village (now City) of Lancaster, Grant County, Wisconsin.

o Designates 1" by 2' iron pipe placed at all Lot Corners by this survey.

Richard C. Wepking
Richard C. Wepking
(6/21/60)

Homer D. Ralph, Jr.
Homer D. Ralph, Jr.
Surveyor for Grant County, Wis.
Wis. Reg. No. S-141
(6/21/60)