211

HOWARD WOOD — SURVEY

DESCRIPTION OF TRACT SURVEYED:

A tract of land located in the West 1/2 of N.E.1/4 of Section 14, T 7 N, R 4 W. of the 4th P.M., Grant County, Wisconsin, described as follows, to-wit: Commence at the Northeast corner of Block 19 in the Village of Woodman, according to the recorded map or plat thereof; thence South 58° 10' West 471.80 feet; thence South 70° 41' West 1949.90 feet to the place of beginning; thence South 70° 41' West 144.00 feet; thence North 19° 19' West 78.00 feet; thence North 70° 41' East 144.00 feet; thence South 19° 19' East 78.00 feet to the place of beginning.

Homer D. Ralph, Jr.
Homer D. Ralph, Jr.
Surveyor for Grant Co., Wis.
Wis. Reg. No. S-141
10/13/62 12/6/62

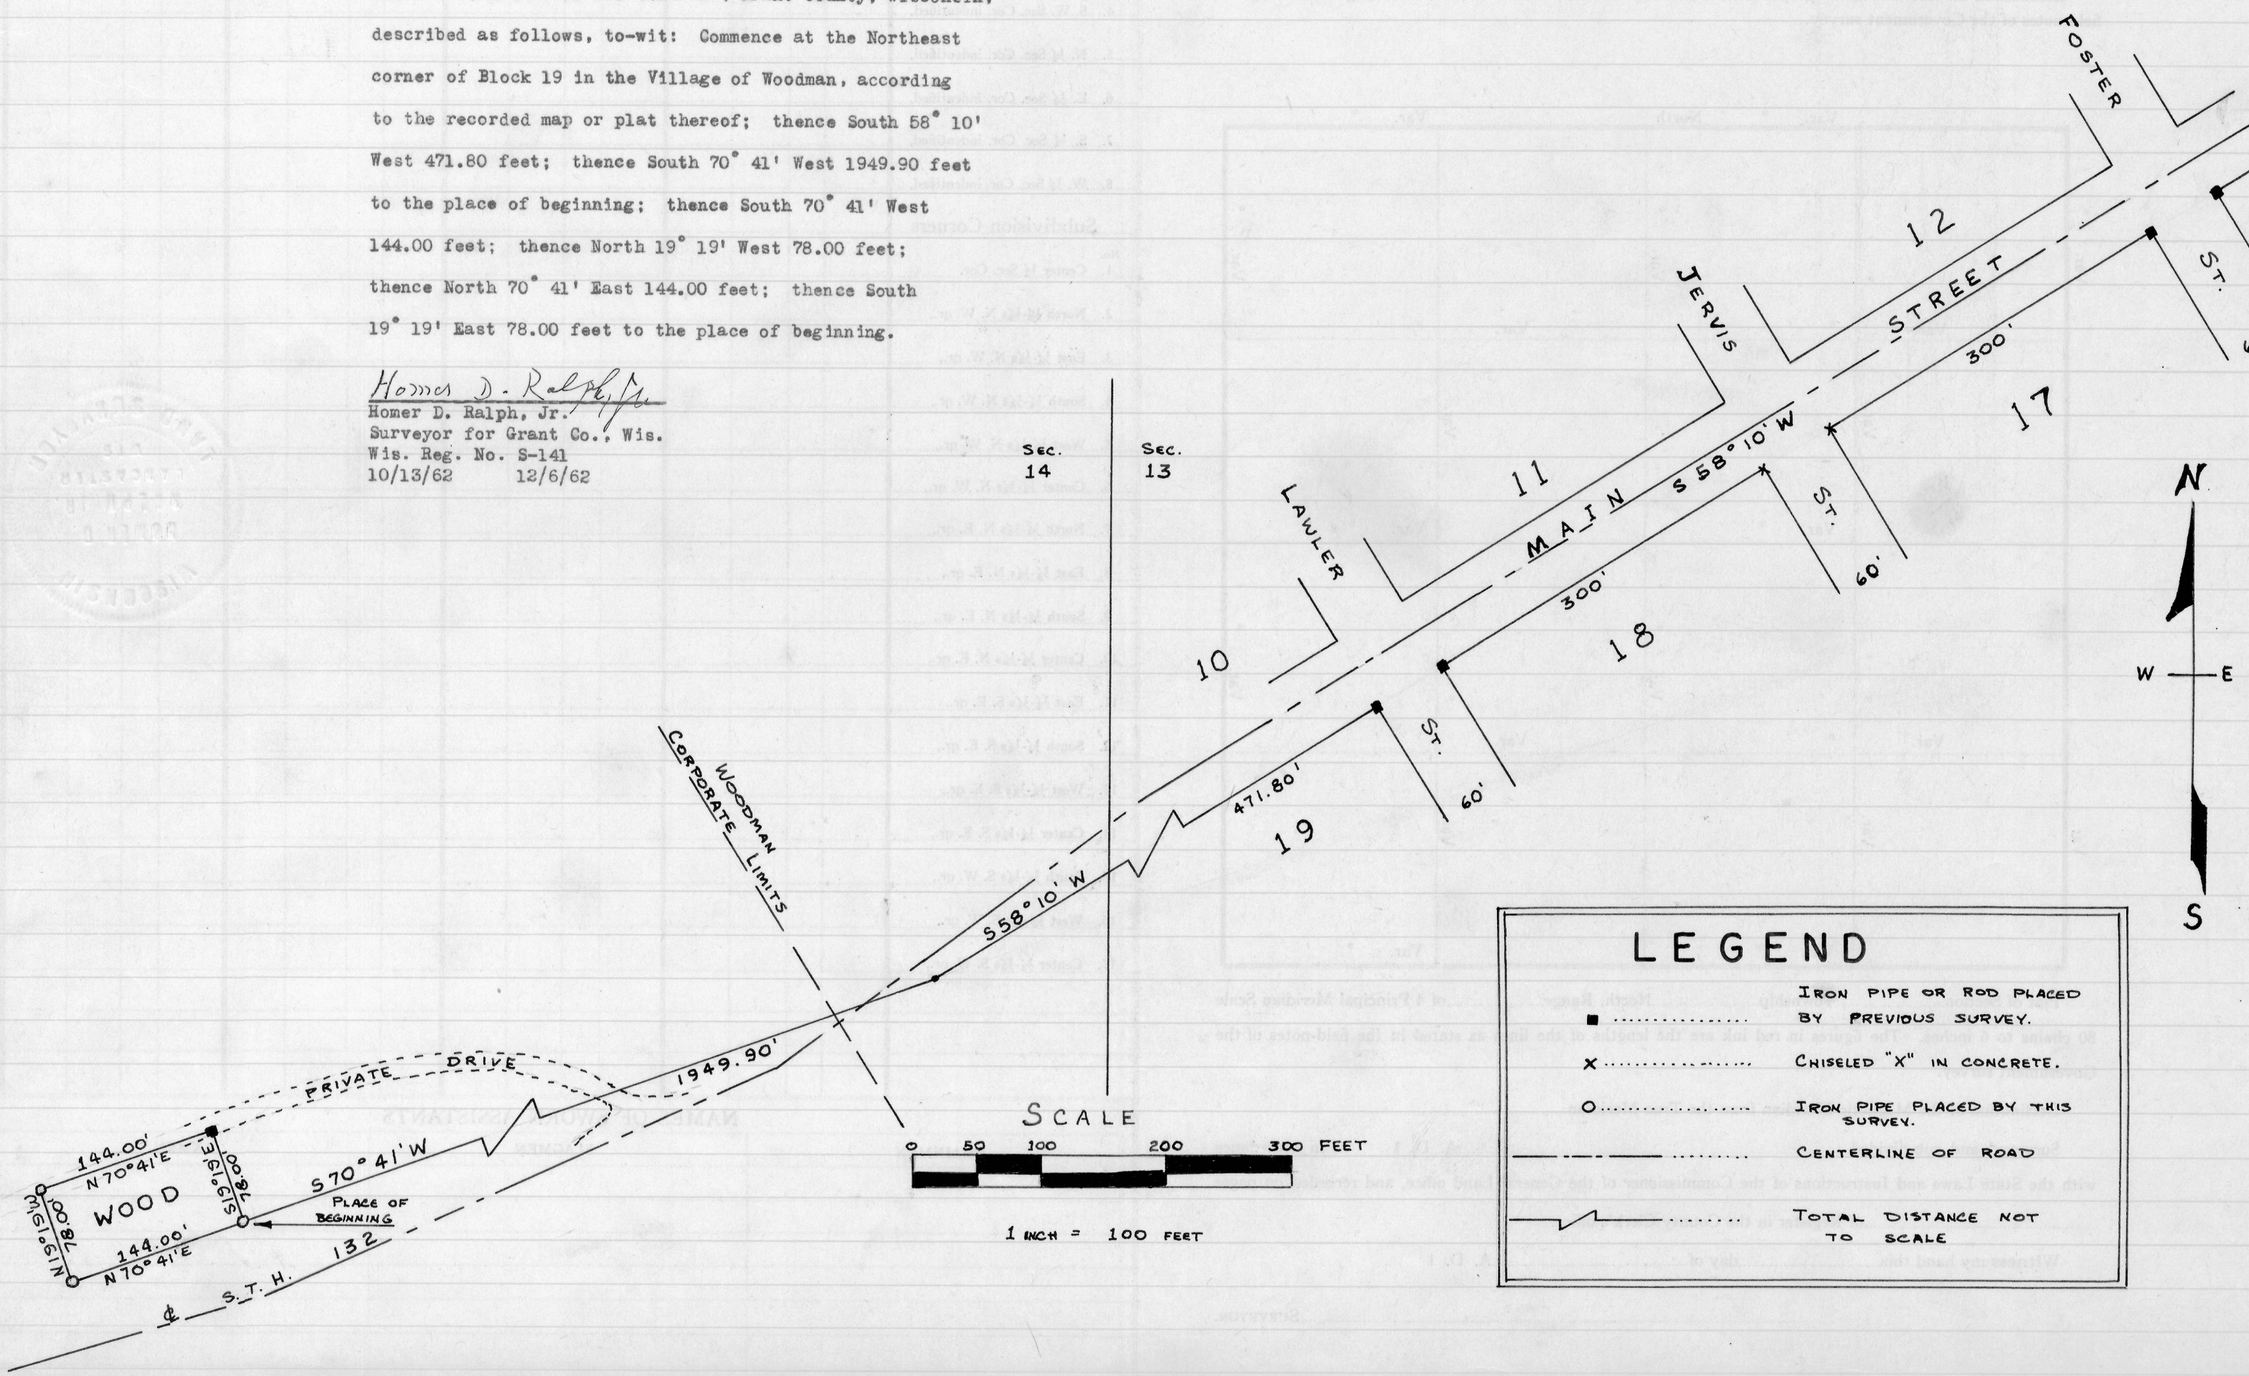

LEGEND

■	IRON PIPE OR ROD PLACED BY PREVIOUS SURVEY.
X	CHISELED "X" IN CONCRETE.
O	IRON PIPE PLACED BY THIS SURVEY.
——— --- ———	CENTERLINE OF ROAD
——/\/\——	TOTAL DISTANCE NOT TO SCALE