WINKERS SURVEY

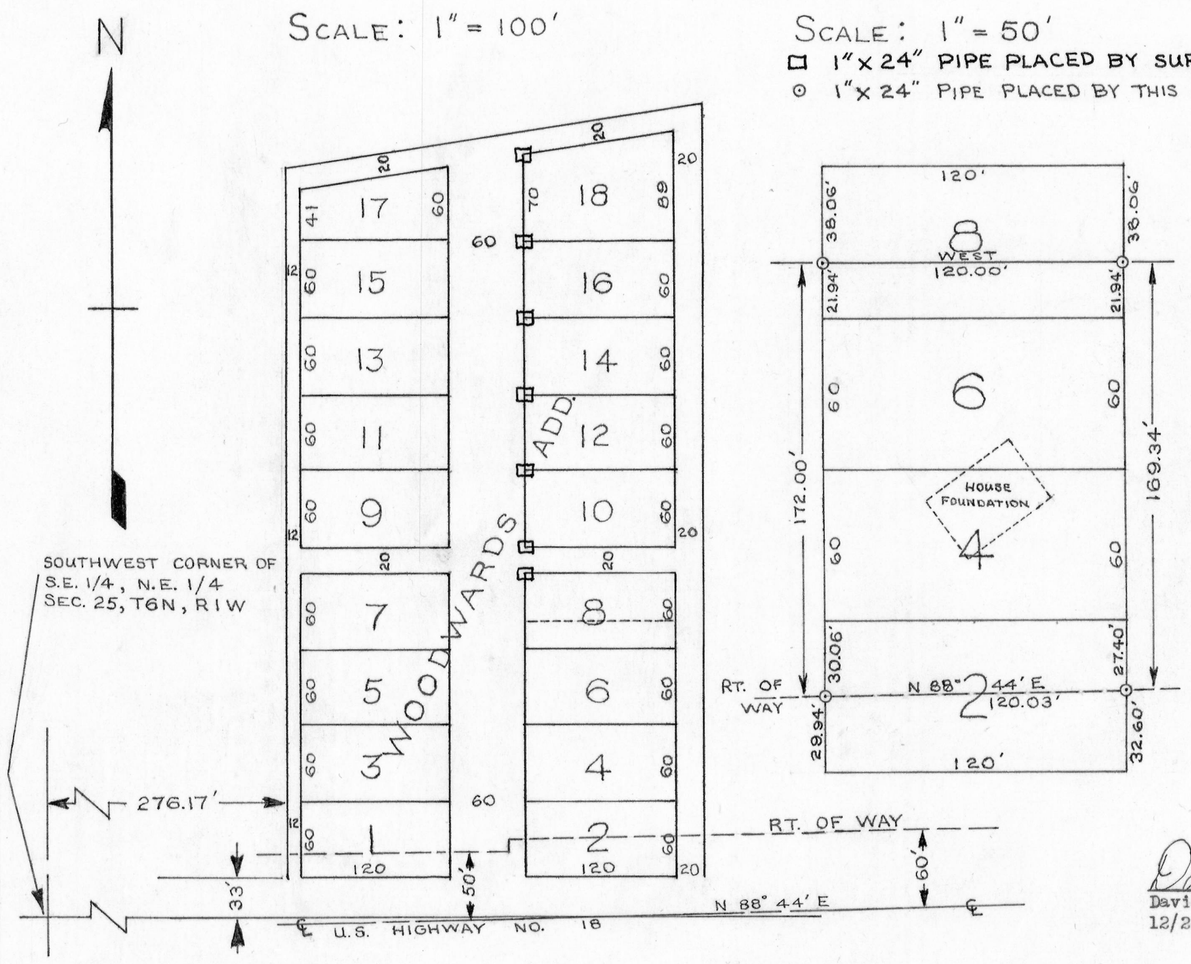

DESCRIPTION:

Lots 4 and 6 and the South 21.94 feet of Lot 8, and that part of Lot 2 lying North of a line described as follows, to-wit: Begin at a point on the western boundary of said Lot 2 which is 29.94 feet North of the Southwest corner of said Lot 2; thence North 88°44' East 120.03 feet to a point on the eastern boundary of said Lot 2; All in Woodwards Addition to the Village of Montfort, Grant County, Wisconsin.

WISCONSIN
HOMER D. RALPH, JR.
S-141
LANCASTER, WIS.
LAND SURVEYOR

David Krohn
David Krohn
12/23/71 - 12/30/71

Homer D. Ralph Jr.
Homer D. Ralph, Jr.
Surveyor for Grant Co.
Wisconsin.