


SCALE: 1" = 250 feet

F/ 43

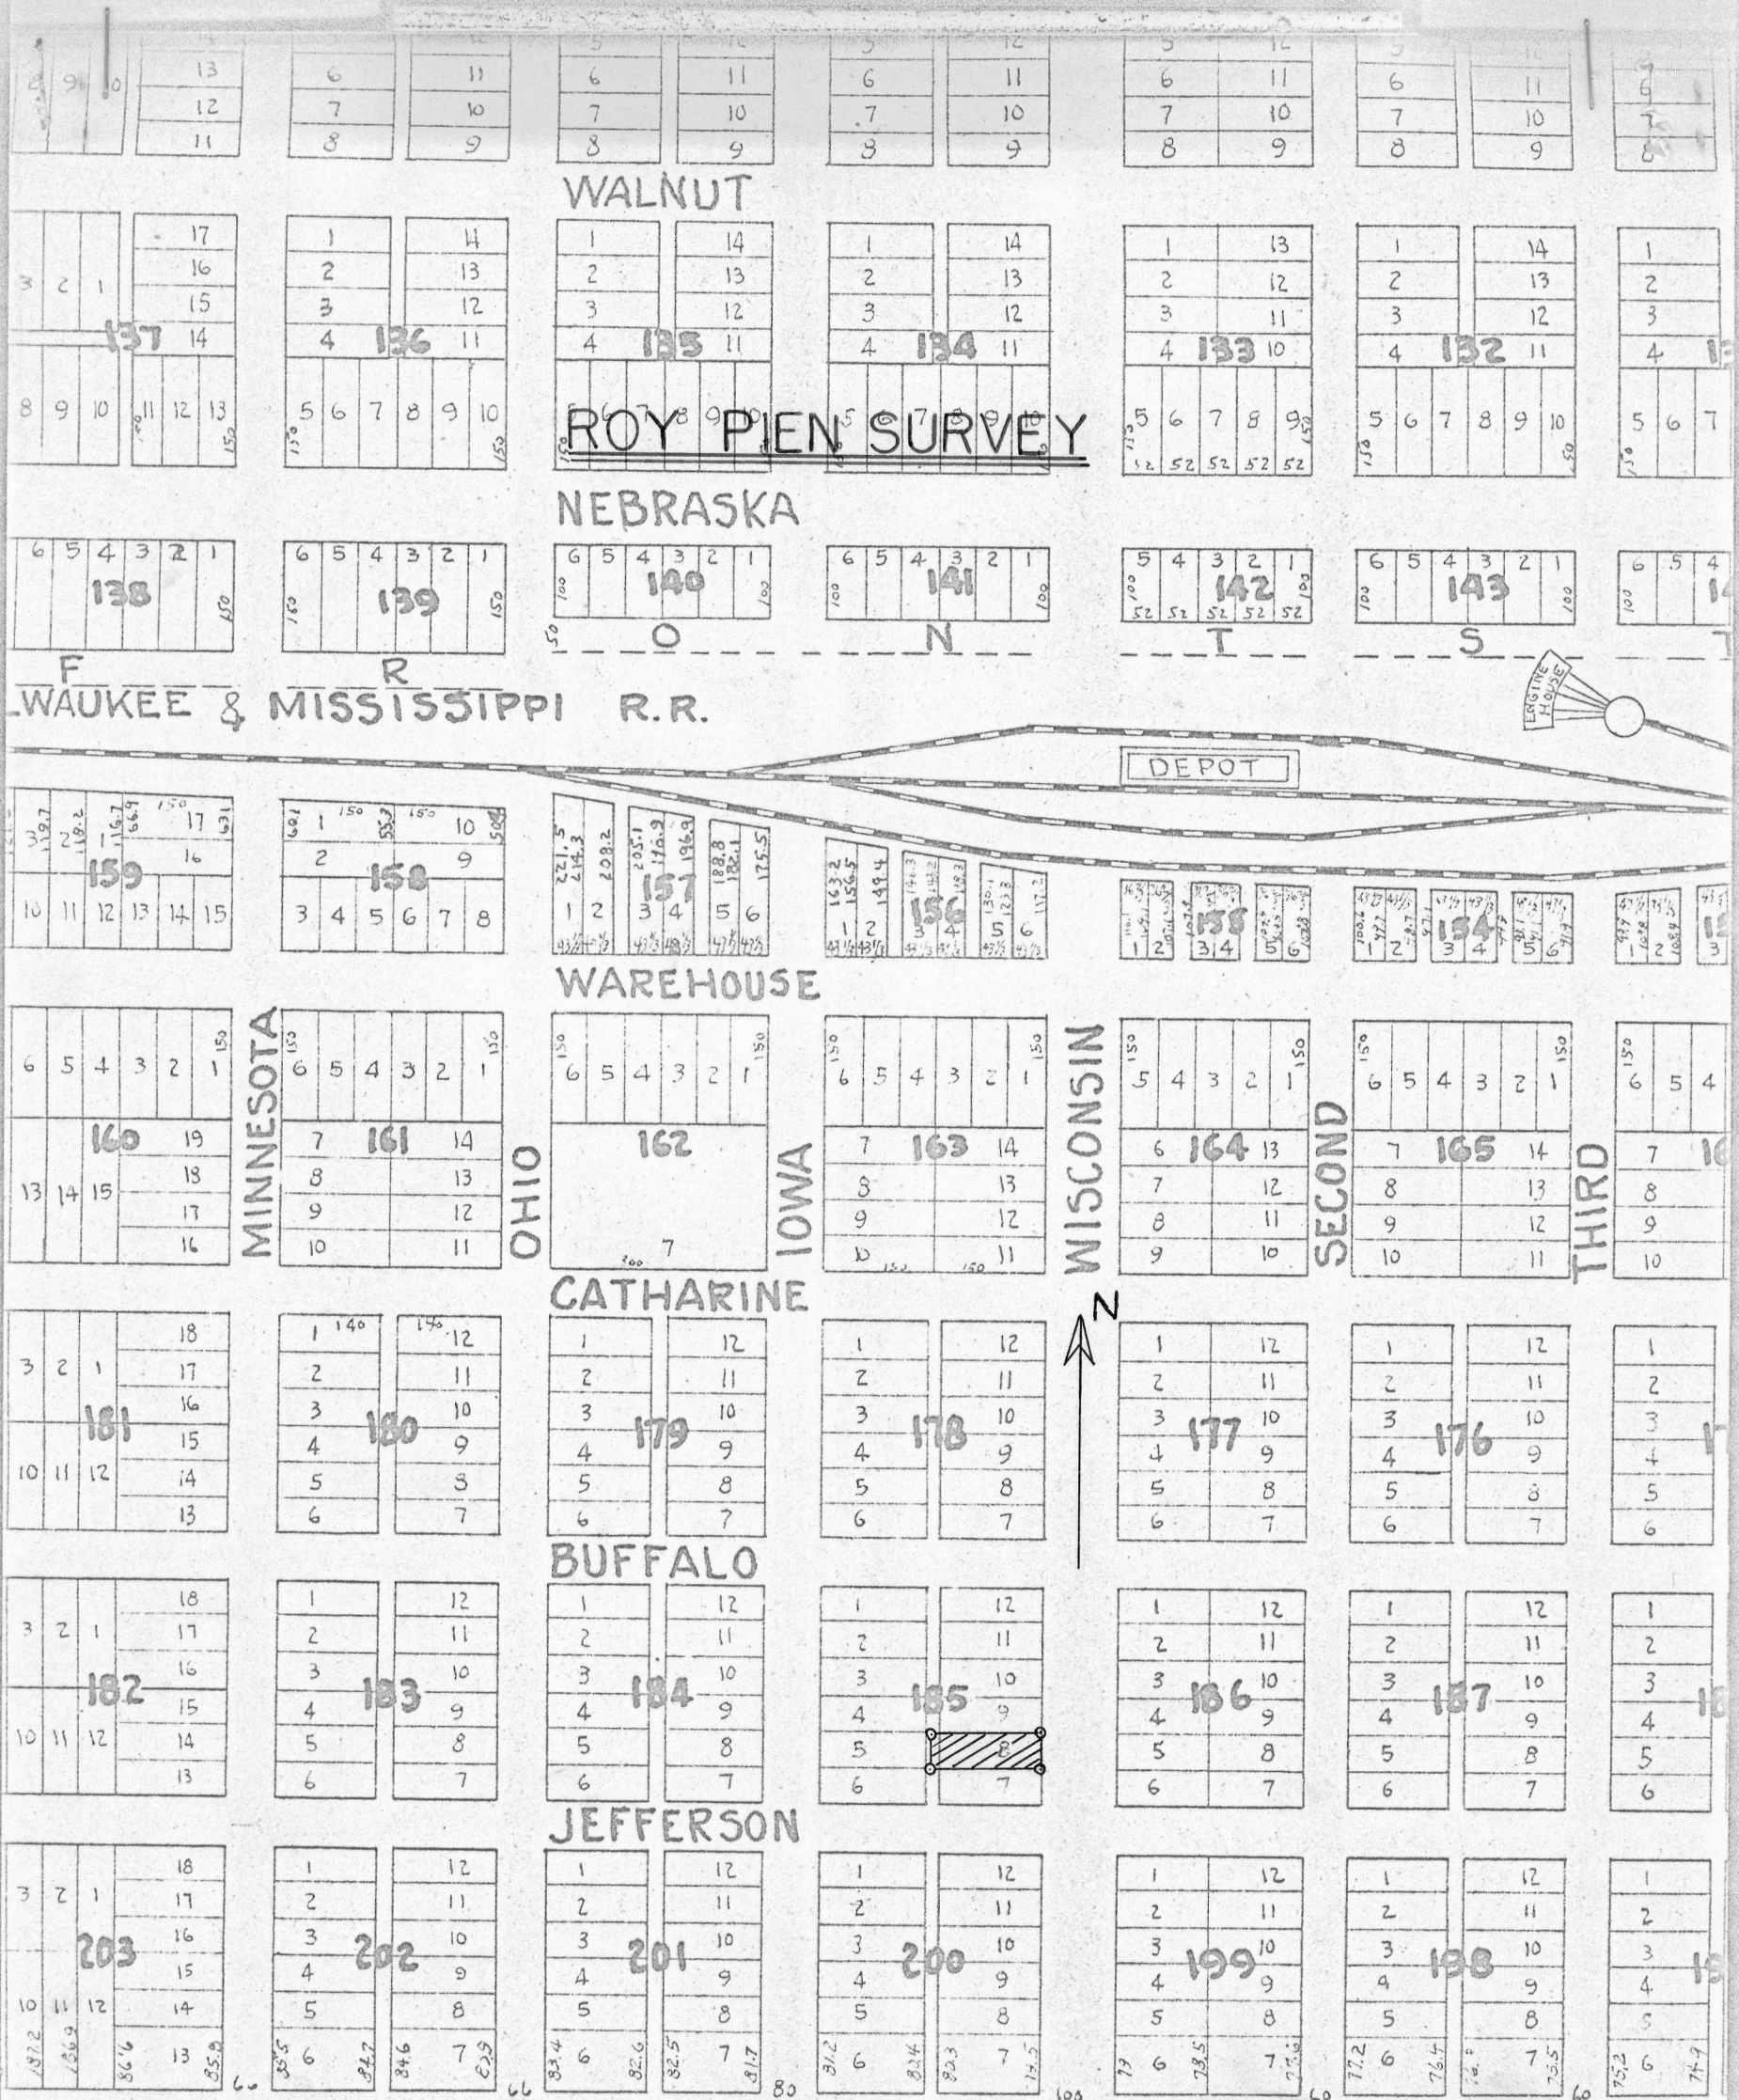

DESCRIPTION:

of the Village
 Lot 8 of Block 185, Original Plat/(now Township)
 of Muscoda, Grant County, Wisconsin

SCALE

LEGEND:

- 1" by 24" pipes

Steven W. Abing
 Steven Abing 6/1/70-
 6/2/70



Homer D. Ralph, Jr.
 Homer D. Ralph, Jr.
 Surveyor of Grant County,
 Wisconsin