KRUSER SURVEY

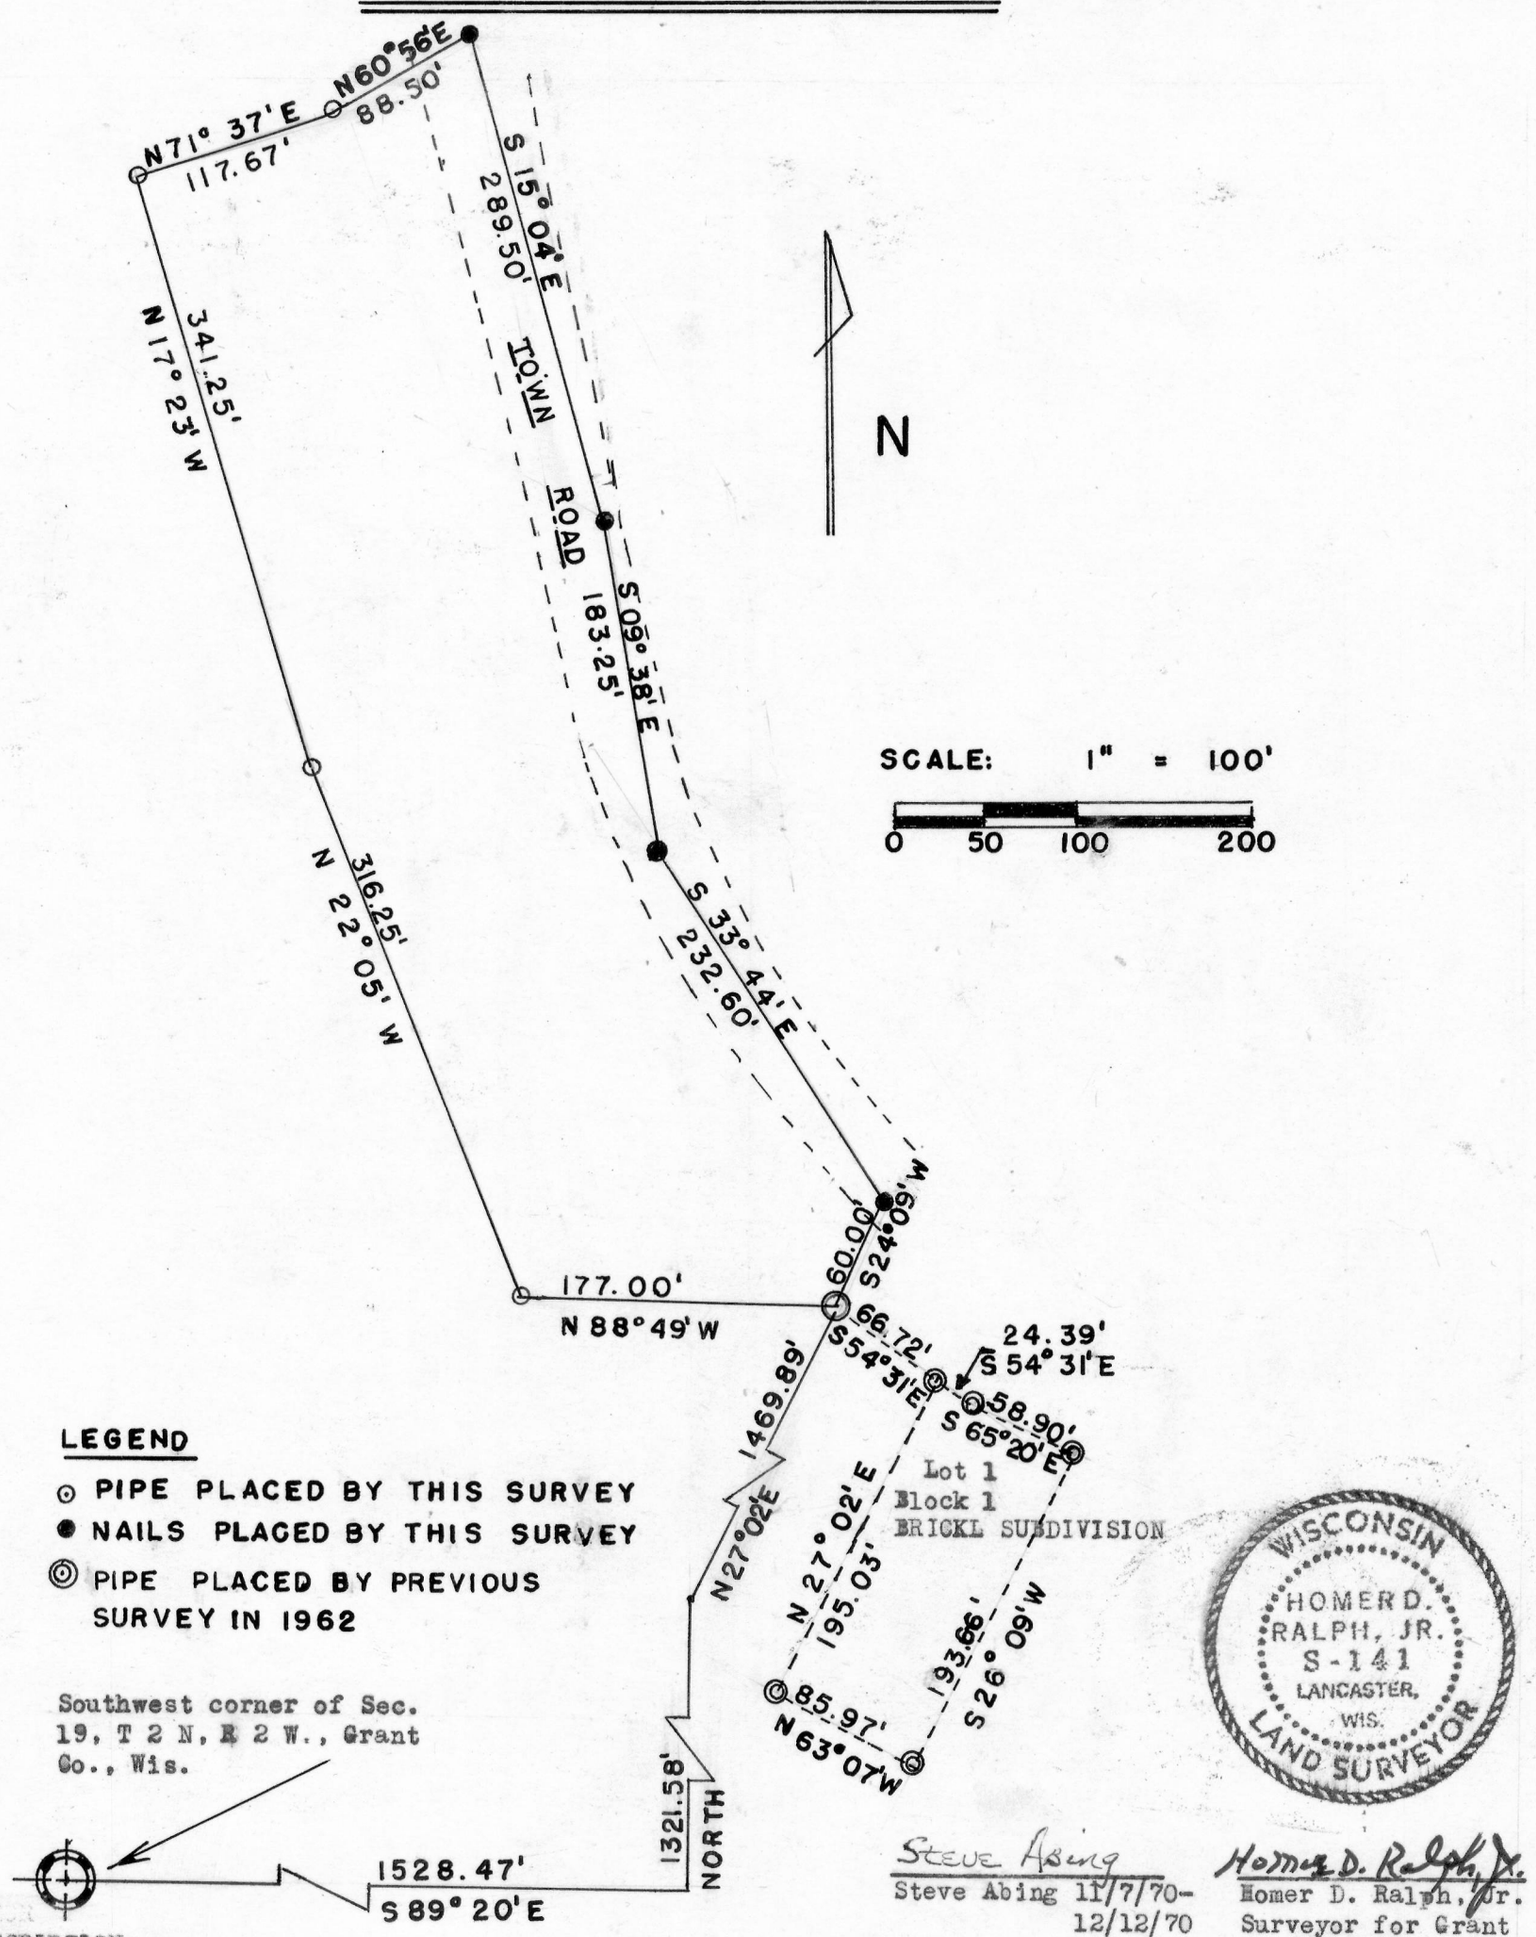

Steve Abing
Steve Abing 11/7/70-12/12/70

Homer D. Ralph, Jr.
Homer D. Ralph, Jr.
Surveyor for Grant County, Wisconsin

DESCRIPTION:

A part of Government Lots 3 and 4 of Section 19, T. 2 N., R. 2 W., of the 4 th. P.M., Grant County, Wisconsin, described as follows, to-wit:

Commence at the Southwest corner of said Section 19; thence South 89° 20' East 1528.47 feet; thence North 1321.58 feet; thence North 27° 02' East 1469.89 feet to the point of beginning; thence North 88° 49' West 177.00 feet; thence North 22° 05' West 316.25 feet; thence North 17° 23' West 341.25 feet; thence North 71° 37' East 117.67 feet; thence North 60° 56' East 88.50 feet; thence South 15° 04' East 289.50 feet along the approximate centerline of town road; thence South 09° 38' East 183.25 feet along said centerline; thence South 33° 44' East 232.60 feet along said centerline; thence South 24° 09' West 60.00 feet along said centerline to the point of beginning.