111

BERNARD MILLER SURVEY

N.W. CORNER
S.E. 1 4, N.E. 1 4,
SEC. 29-8-2

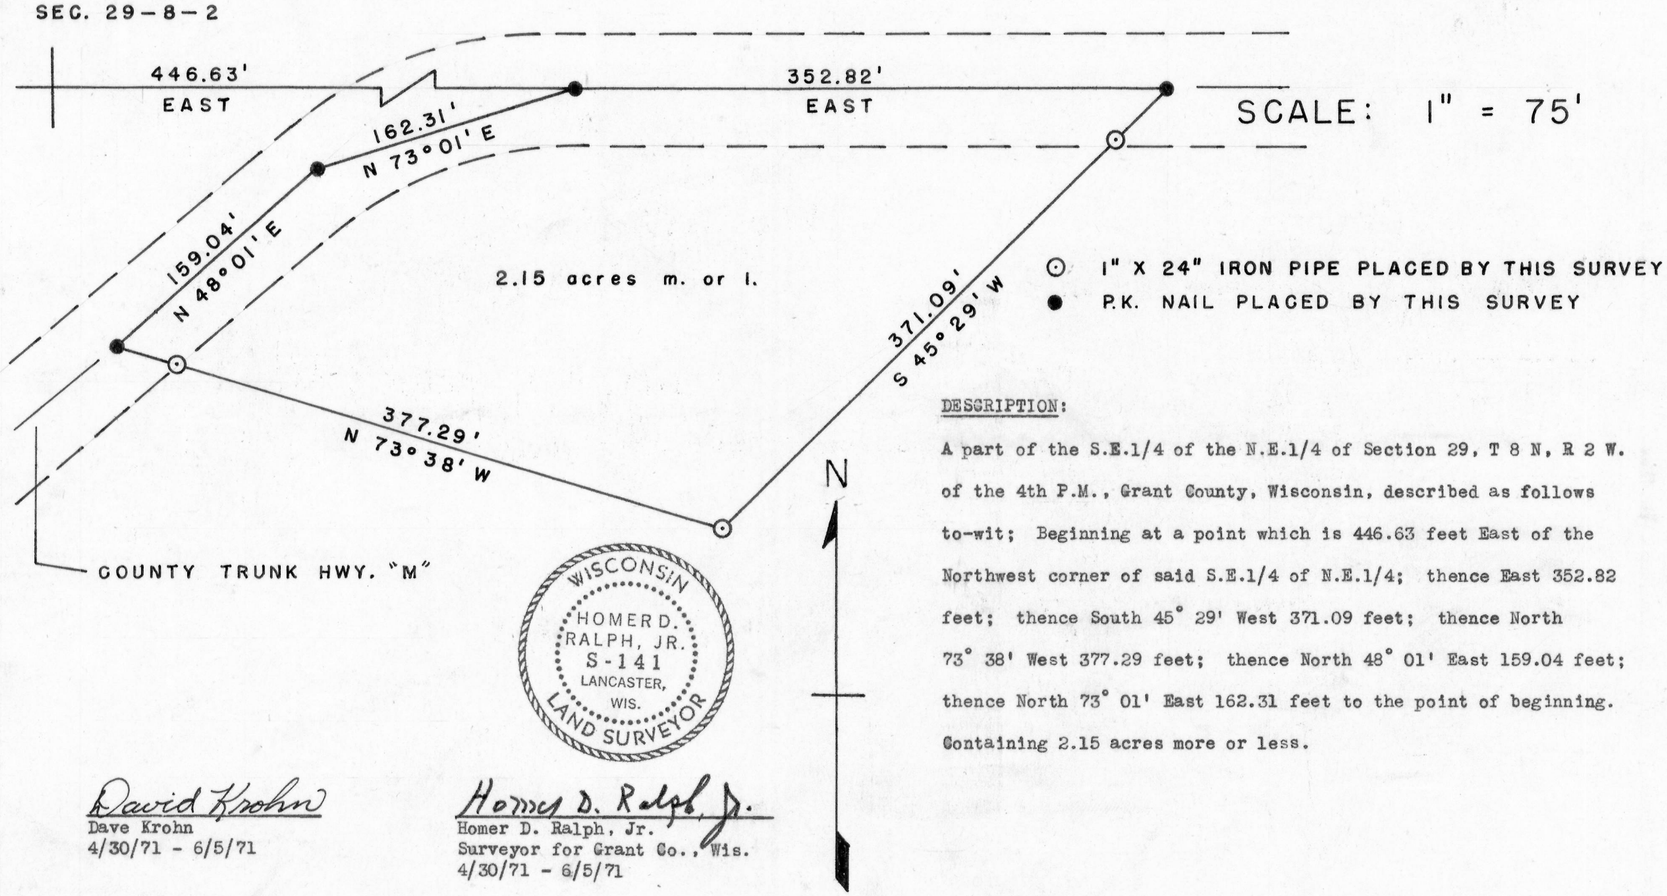

DESCRIPTION:

A part of the S.E.1/4 of the N.E.1/4 of Section 29, T 8 N, R 2 W. of the 4th P.M., Grant County, Wisconsin, described as follows to-wit; Beginning at a point which is 446.63 feet East of the Northwest corner of said S.E.1/4 of N.E.1/4; thence East 352.82 feet; thence South 45° 29' West 371.09 feet; thence North 73° 38' West 377.29 feet; thence North 48° 01' East 159.04 feet; thence North 73° 01' East 162.31 feet to the point of beginning. Containing 2.15 acres more or less.

David Krohn
Dave Krohn
4/30/71 - 6/5/71

Homer D. Ralph, Jr.
Homer D. Ralph, Jr.
Surveyor for Grant Co., Wis.
4/30/71 - 6/5/71