123

STOLGA SURVEY

Scale: 1" = 20'

⊙ - 1" X 24" Iron Pipe Placed By this Survey

● - 1" X 24" Iron Pipe Placed By Previous Survey

DISCRIPTION

In-Lot 101 of the Village of Potosi, Grant county, Wisconsin, according to the recorded map of the plat there of.

WISCONSIN HOMER D. RALPH, JR. S-141 LANCASTER, WIS. LAND SURVEYOR

Charles Lange
Charles Lange
5/13-5/26/72
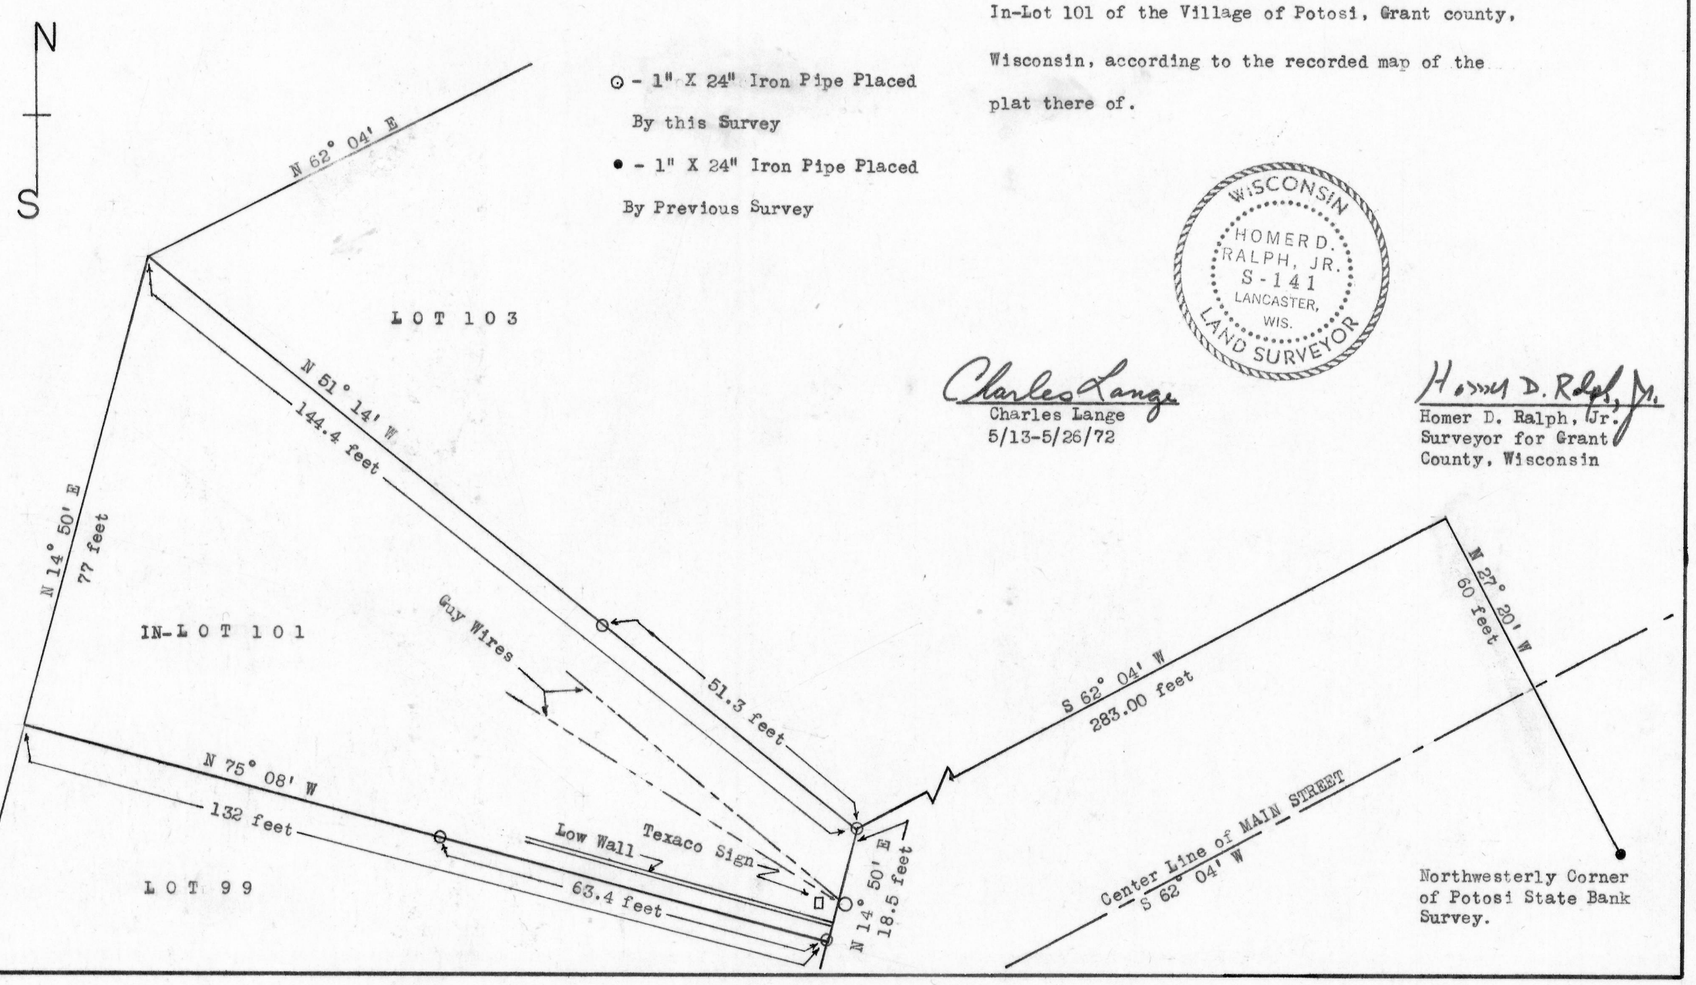
Homer D. Ralph, Jr.
Homer D. Ralph, Jr.
Surveyor for Grant County, Wisconsin