DR. G. BURTON BLOCH SURVEY

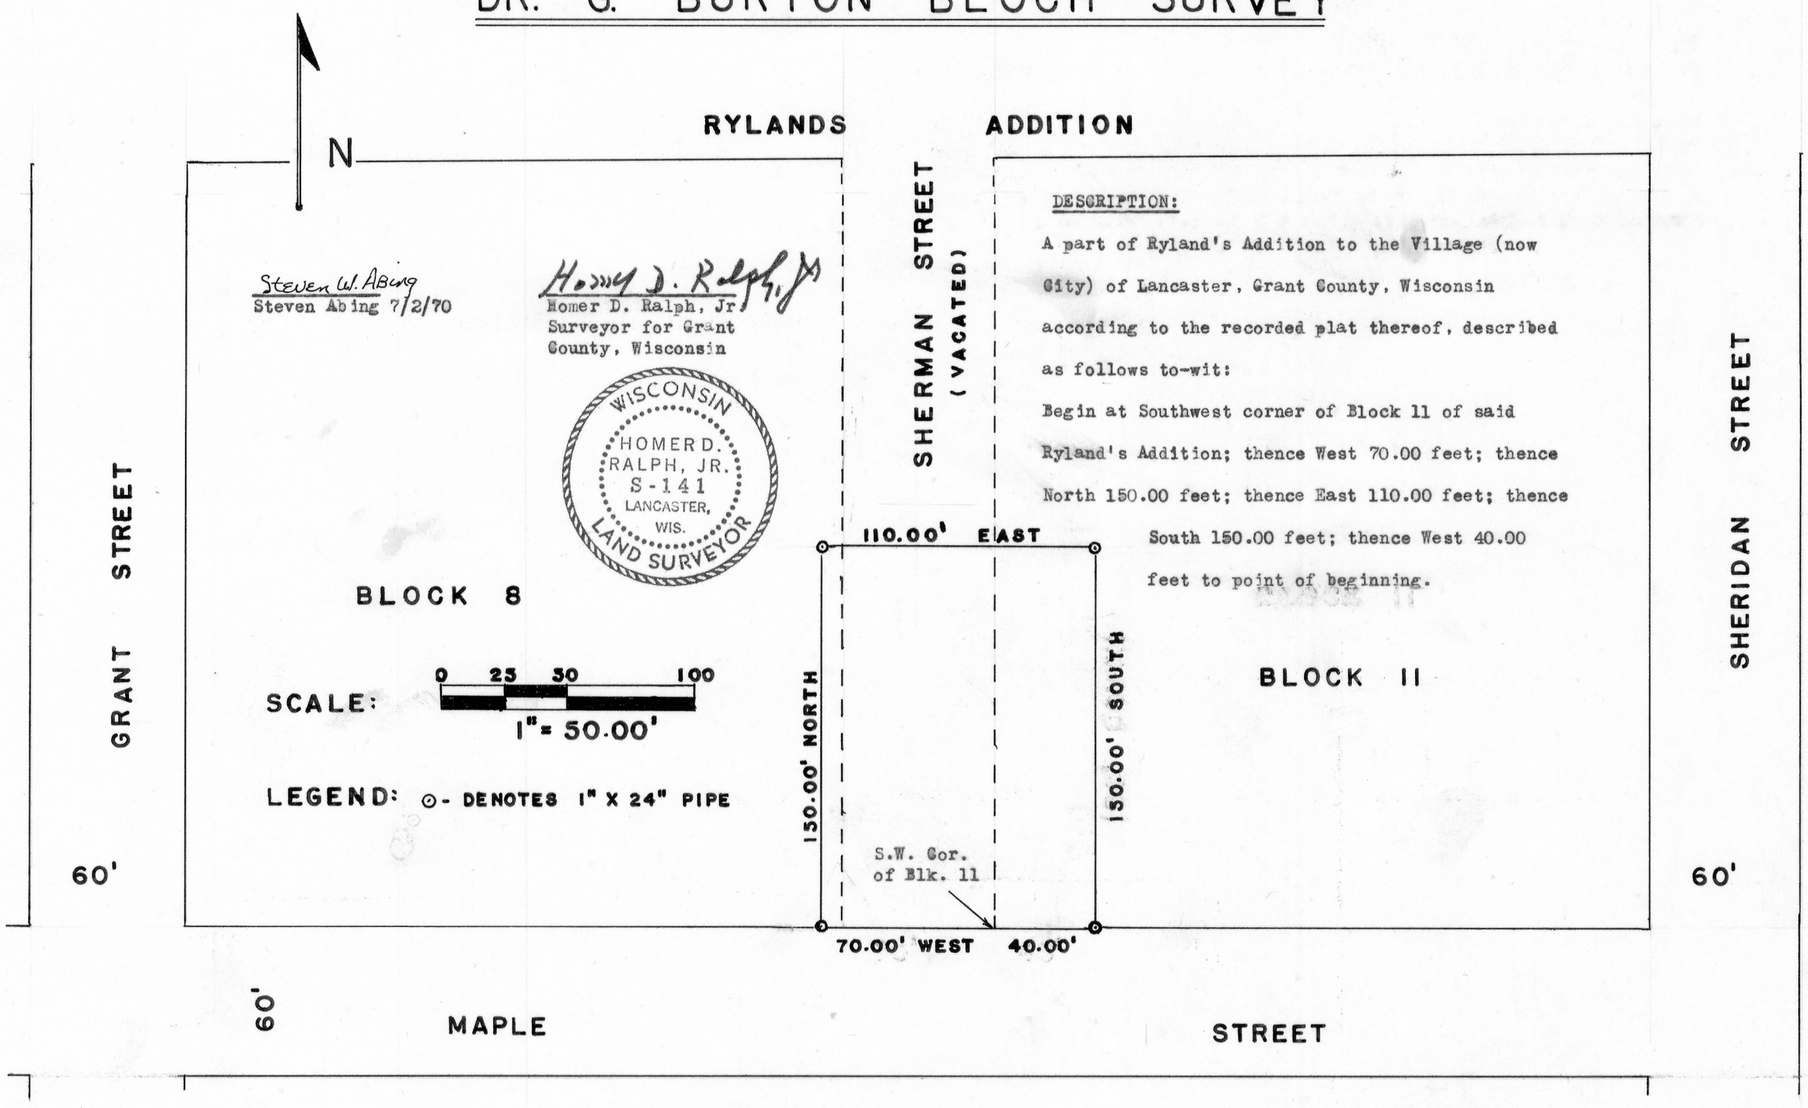

DESCRIPTION:

A part of Ryland's Addition to the Village (now City) of Lancaster, Grant County, Wisconsin according to the recorded plat thereof, described as follows to-wit:

Begin at Southwest corner of Block 11 of said Ryland's Addition; thence West 70.00 feet; thence North 150.00 feet; thence East 110.00 feet; thence South 150.00 feet; thence West 40.00 feet to point of beginning.

071