DERWERD COOK SURVEY

SCALE = 1" = 100'

⊙ 1"X 24" IRON PIPE PLACED BY THIS SURVEY

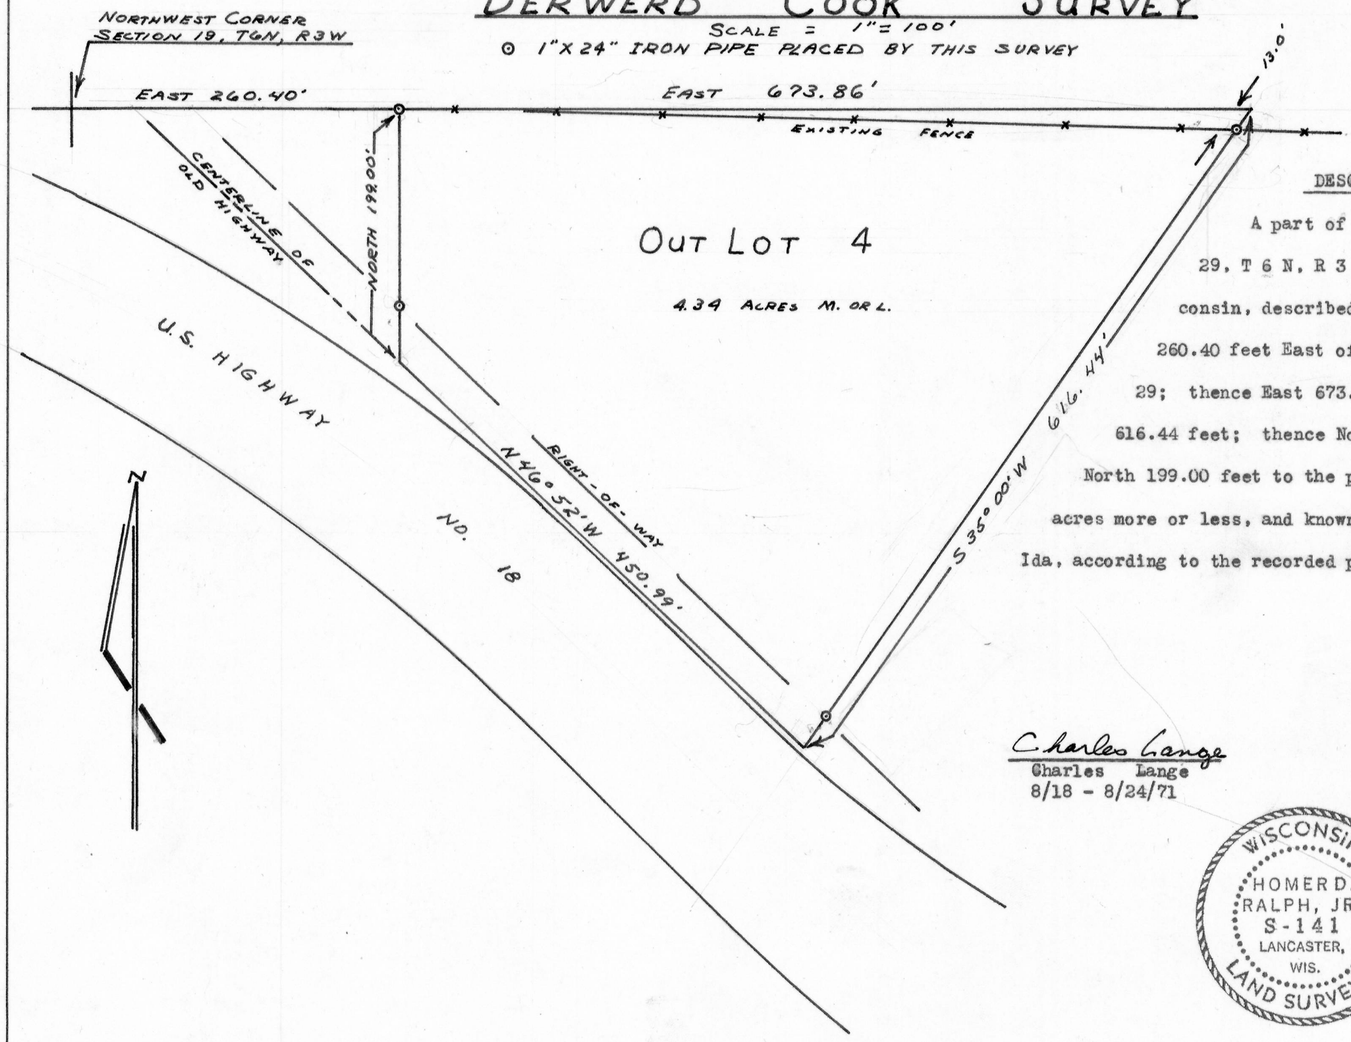

DESCRIPTION

A part of the N.W.1/4 of the N.W.1/4 of Section 29, T 6 N, R 3 W. of the 4th P.M., Grant County, Wisconsin, described as follows, to-wit: Begin at a point 260.40 feet East of the Northwest corner of said Section 29; thence East 673.86 feet; thence South 35°00' West 616.44 feet; thence North 46° 52' West 450.99 feet; thence North 199.00 feet to the place of beginning. Containing 4.34 acres more or less, and known as Outlot 4 of the Village of Mt. Ida, according to the recorded plat thereof.

Charles Lange
Charles Lange
8/18 - 8/24/71

Homer D. Ralph, Jr.
Homer D. Ralph, Jr.
Surveyor for Grant County, Wisconsin.

WISCONSIN
HOMER D. RALPH, JR.
S-141
LANCASTER, WIS.
LAND SURVEYOR