


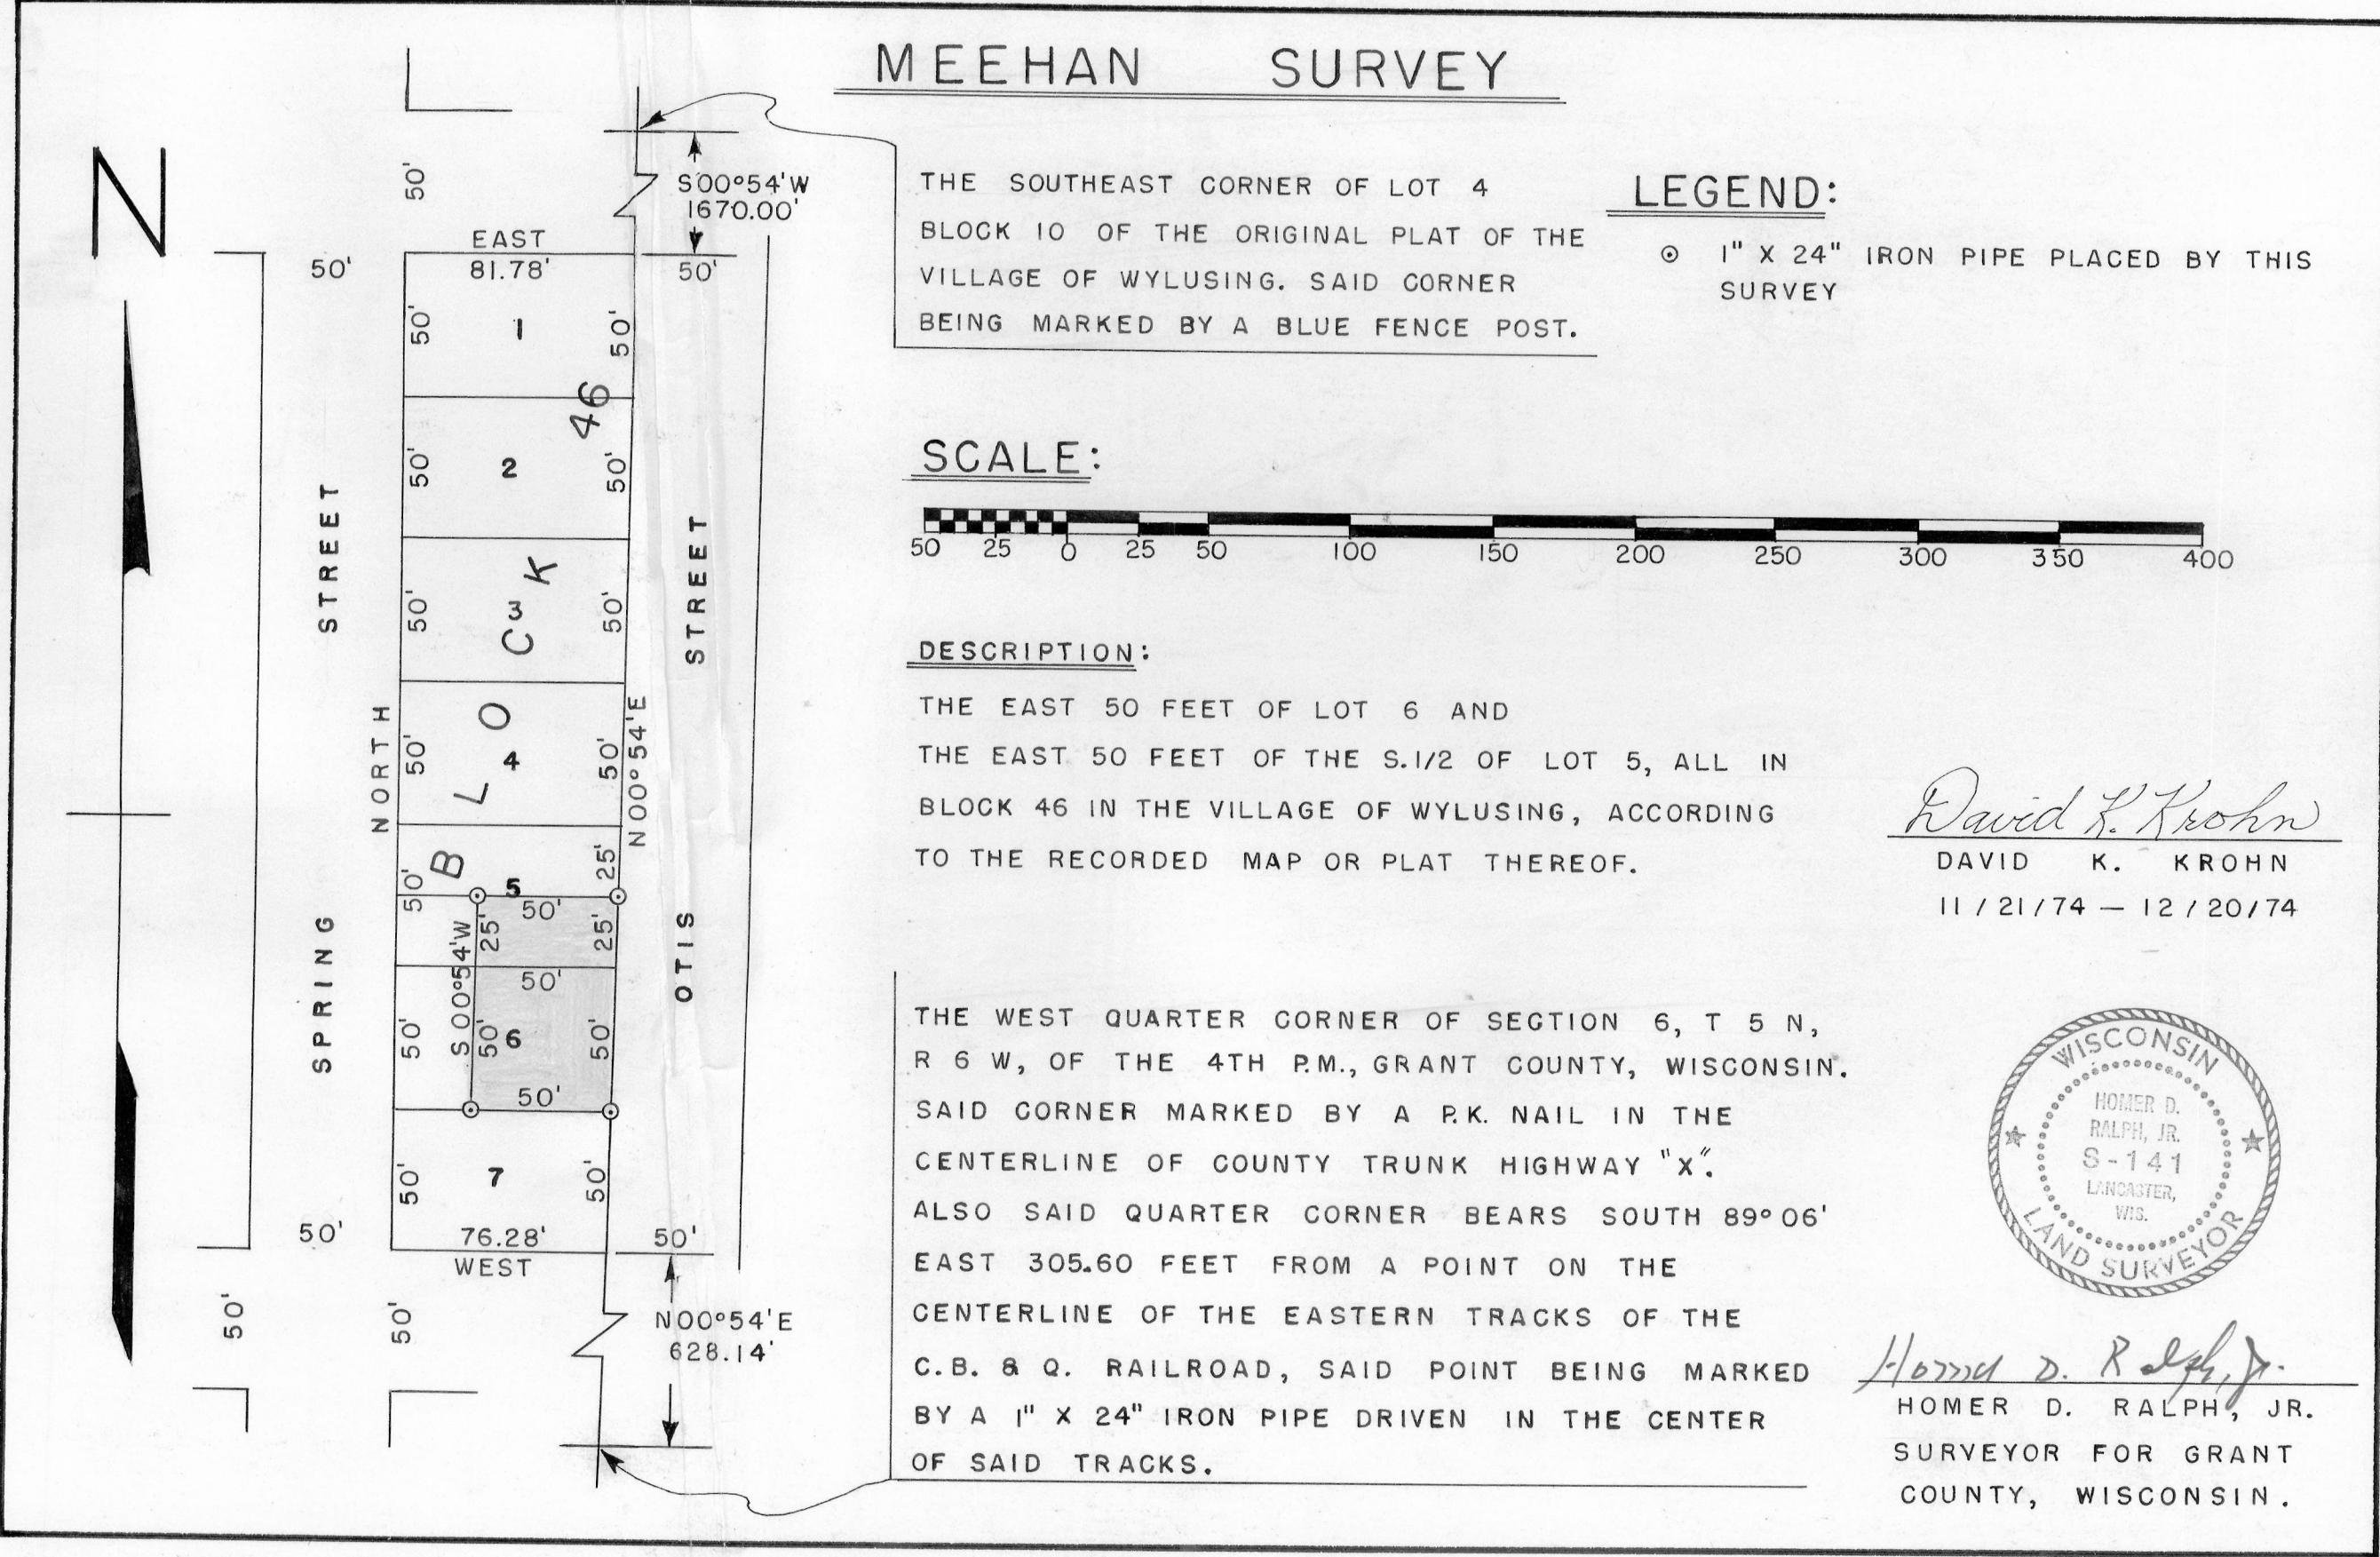


MEEHAN SURVEY

LEGEND:

⊙ 1" X 24" IRON PIPE PLACED BY THIS SURVEY

SCALE:

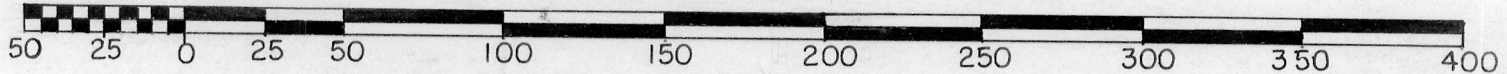

DESCRIPTION:


THE EAST 50 FEET OF LOT 6 AND THE EAST 50 FEET OF THE S.1/2 OF LOT 5, ALL IN BLOCK 46 IN THE VILLAGE OF WYLUSING, ACCORDING TO THE RECORDED MAP OR PLAT THEREOF.

THE WEST QUARTER CORNER OF SECTION 6, T 5 N, R 6 W, OF THE 4TH P.M., GRANT COUNTY, WISCONSIN. SAID CORNER MARKED BY A P.K. NAIL IN THE CENTERLINE OF COUNTY TRUNK HIGHWAY "X". ALSO SAID QUARTER CORNER BEARS SOUTH 89° 06' EAST 305.60 FEET FROM A POINT ON THE CENTERLINE OF THE EASTERN TRACKS OF THE C.B. & Q. RAILROAD, SAID POINT BEING MARKED BY A 1" X 24" IRON PIPE DRIVEN IN THE CENTER OF SAID TRACKS.

David K. Krohn

DAVID K. KROHN

11/21/74 — 12/20/74

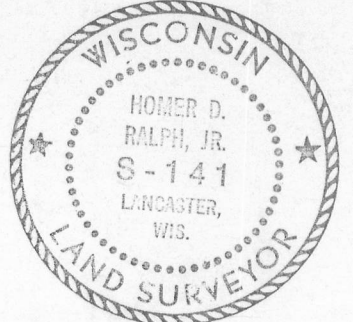

Homer D. Ralph, Jr.

HOMER D. RALPH, JR.
SURVEYOR FOR GRANT
COUNTY, WISCONSIN.