S. B. M.,
PRAIRIE DU CHIEN FEDERAL SAVINGS & LOAN SURVEY

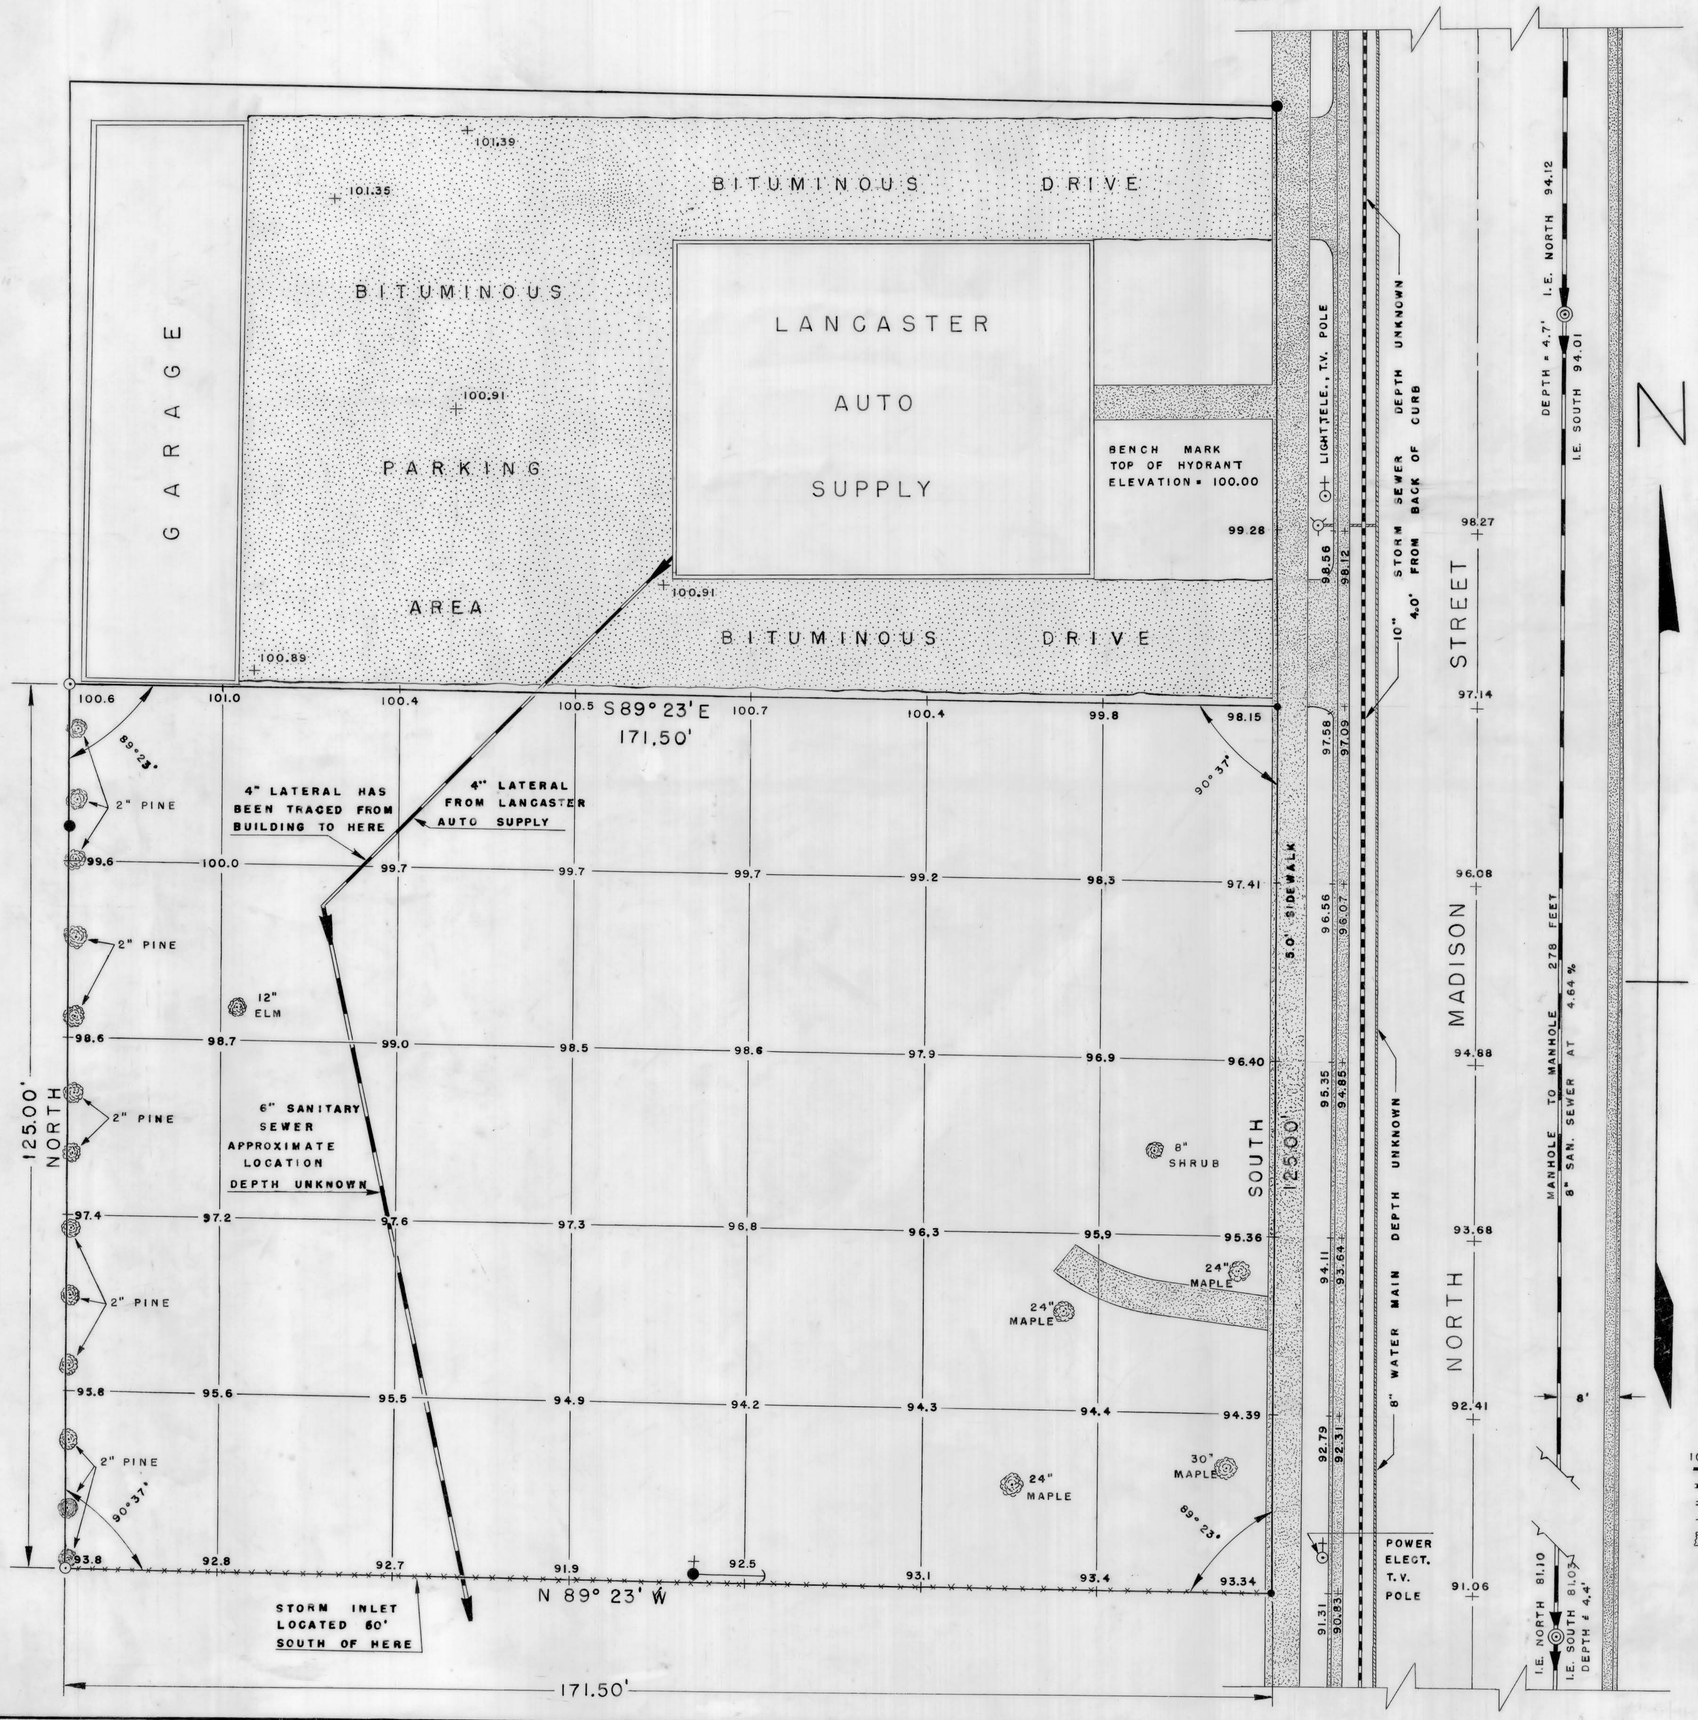

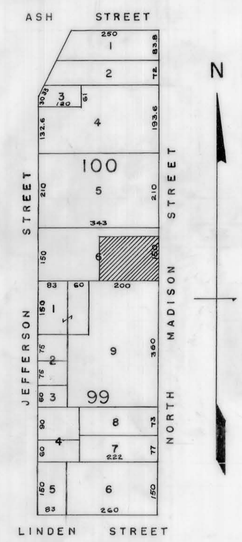

SCALE: 1" = 200'

DESCRIPTION:

THE E. 1/2 OF THE SOUTH 125.00 FEET OF LOT 6, BLOCK 100, OF THE ASSESSMENT PLAT OF THE CITY OF LANCASTER, GRANT COUNTY, WISCONSIN.

BENCH MARK:

TOP OF HYDRANT IN FRONT OF LANCASTER AUTO SUPPLY ON NORTH MADISON STREET.

ELEVATION = 100.00'

LOCATION DIAGRAM

BLOCK 99 AND 100 OF THE ASSESSMENT PLAT OF THE CITY OF LANCASTER, WIS.

SCALE: 1" = 10'

5 0 5 10 15 20 25 30 40 50 60 70

LEGEND:

- MANHOLE I.E. (INVERT ELEVATION)
- CHISEL MARK IN SIDEWALK PLACED BY THIS SURVEY
- 1" X 24" IRON PIPE PLACED BY THIS SURVEY
- 1" X 24" IRON PIPE PLACED BY PREVIOUS SURVEY
- TELEPHONE POLE
- ELECTRIC POLE
- FIRE HYDRANT
- TREE
- 100.0 + ELEVATION
- SANITARY SEWER
- STORM SEWER
- WATER MAIN
- CENTERLINE
- 2.0' CURB AND GUTTER
- GUY

WISCONSIN HOMER D. RALPH, JR. S-141 LANCASTER, WIS. LAND SURVEYOR

David K. Krohn
DAVID K. KROHN
10/9/73 — 10/29/73

Homer D. Ralph Jr.
HOMER D. RALPH, JR.
SURVEYOR FOR GRANT COUNTY, WISCONSIN.