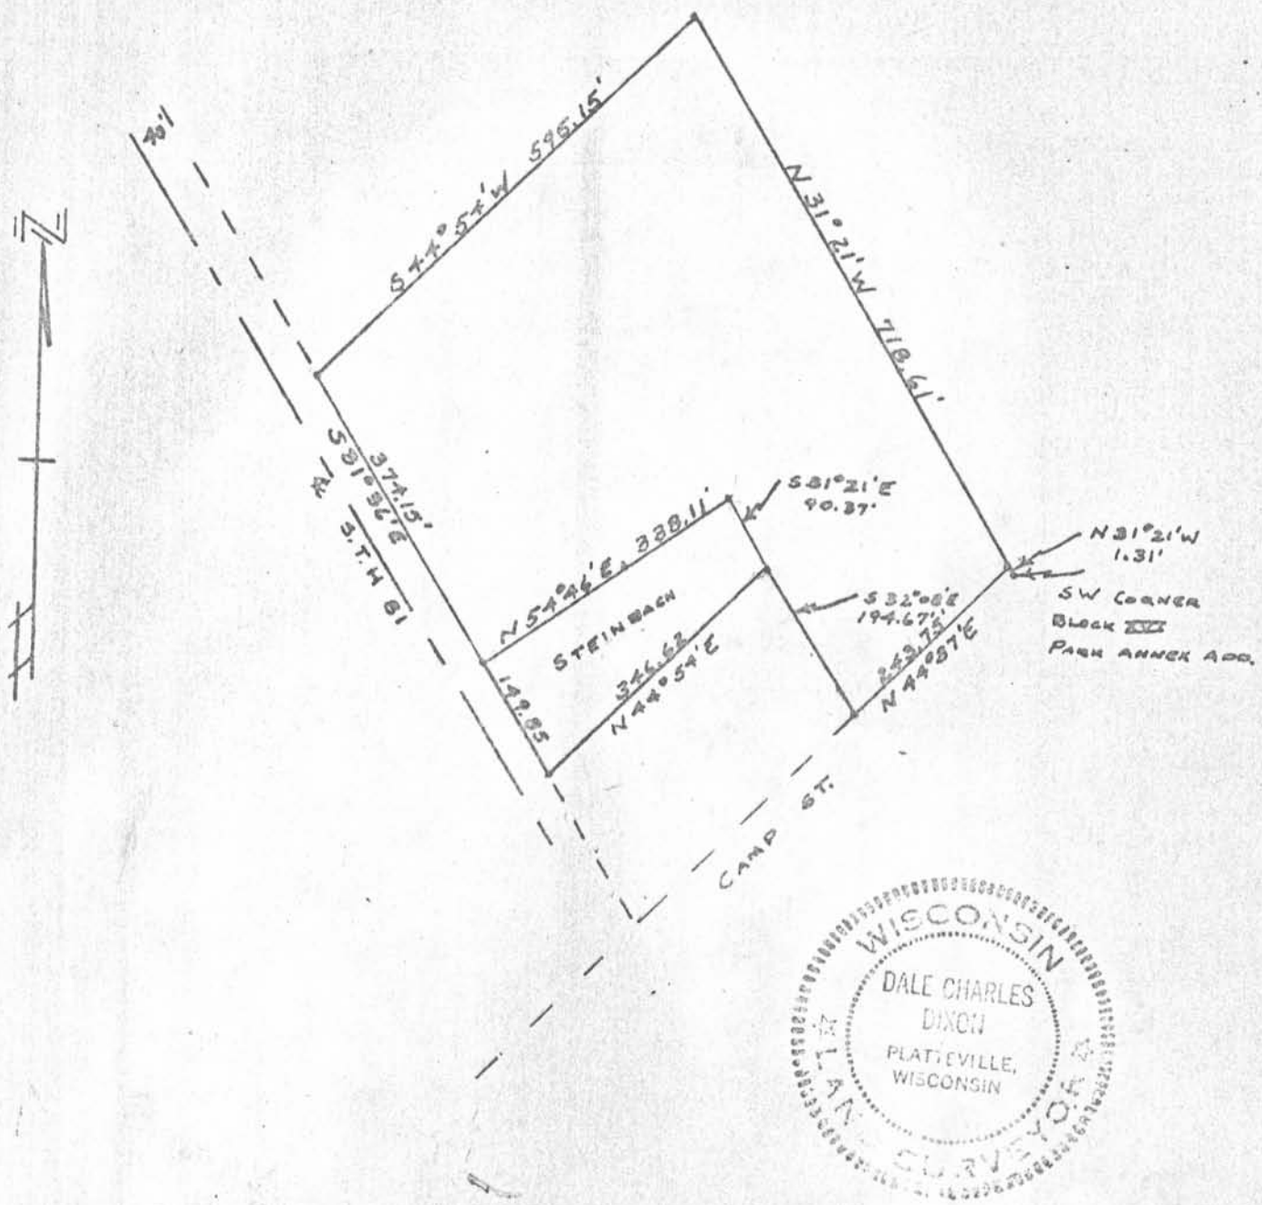STEINBACH PROPERTY
PLATTEVILLE, WIS.