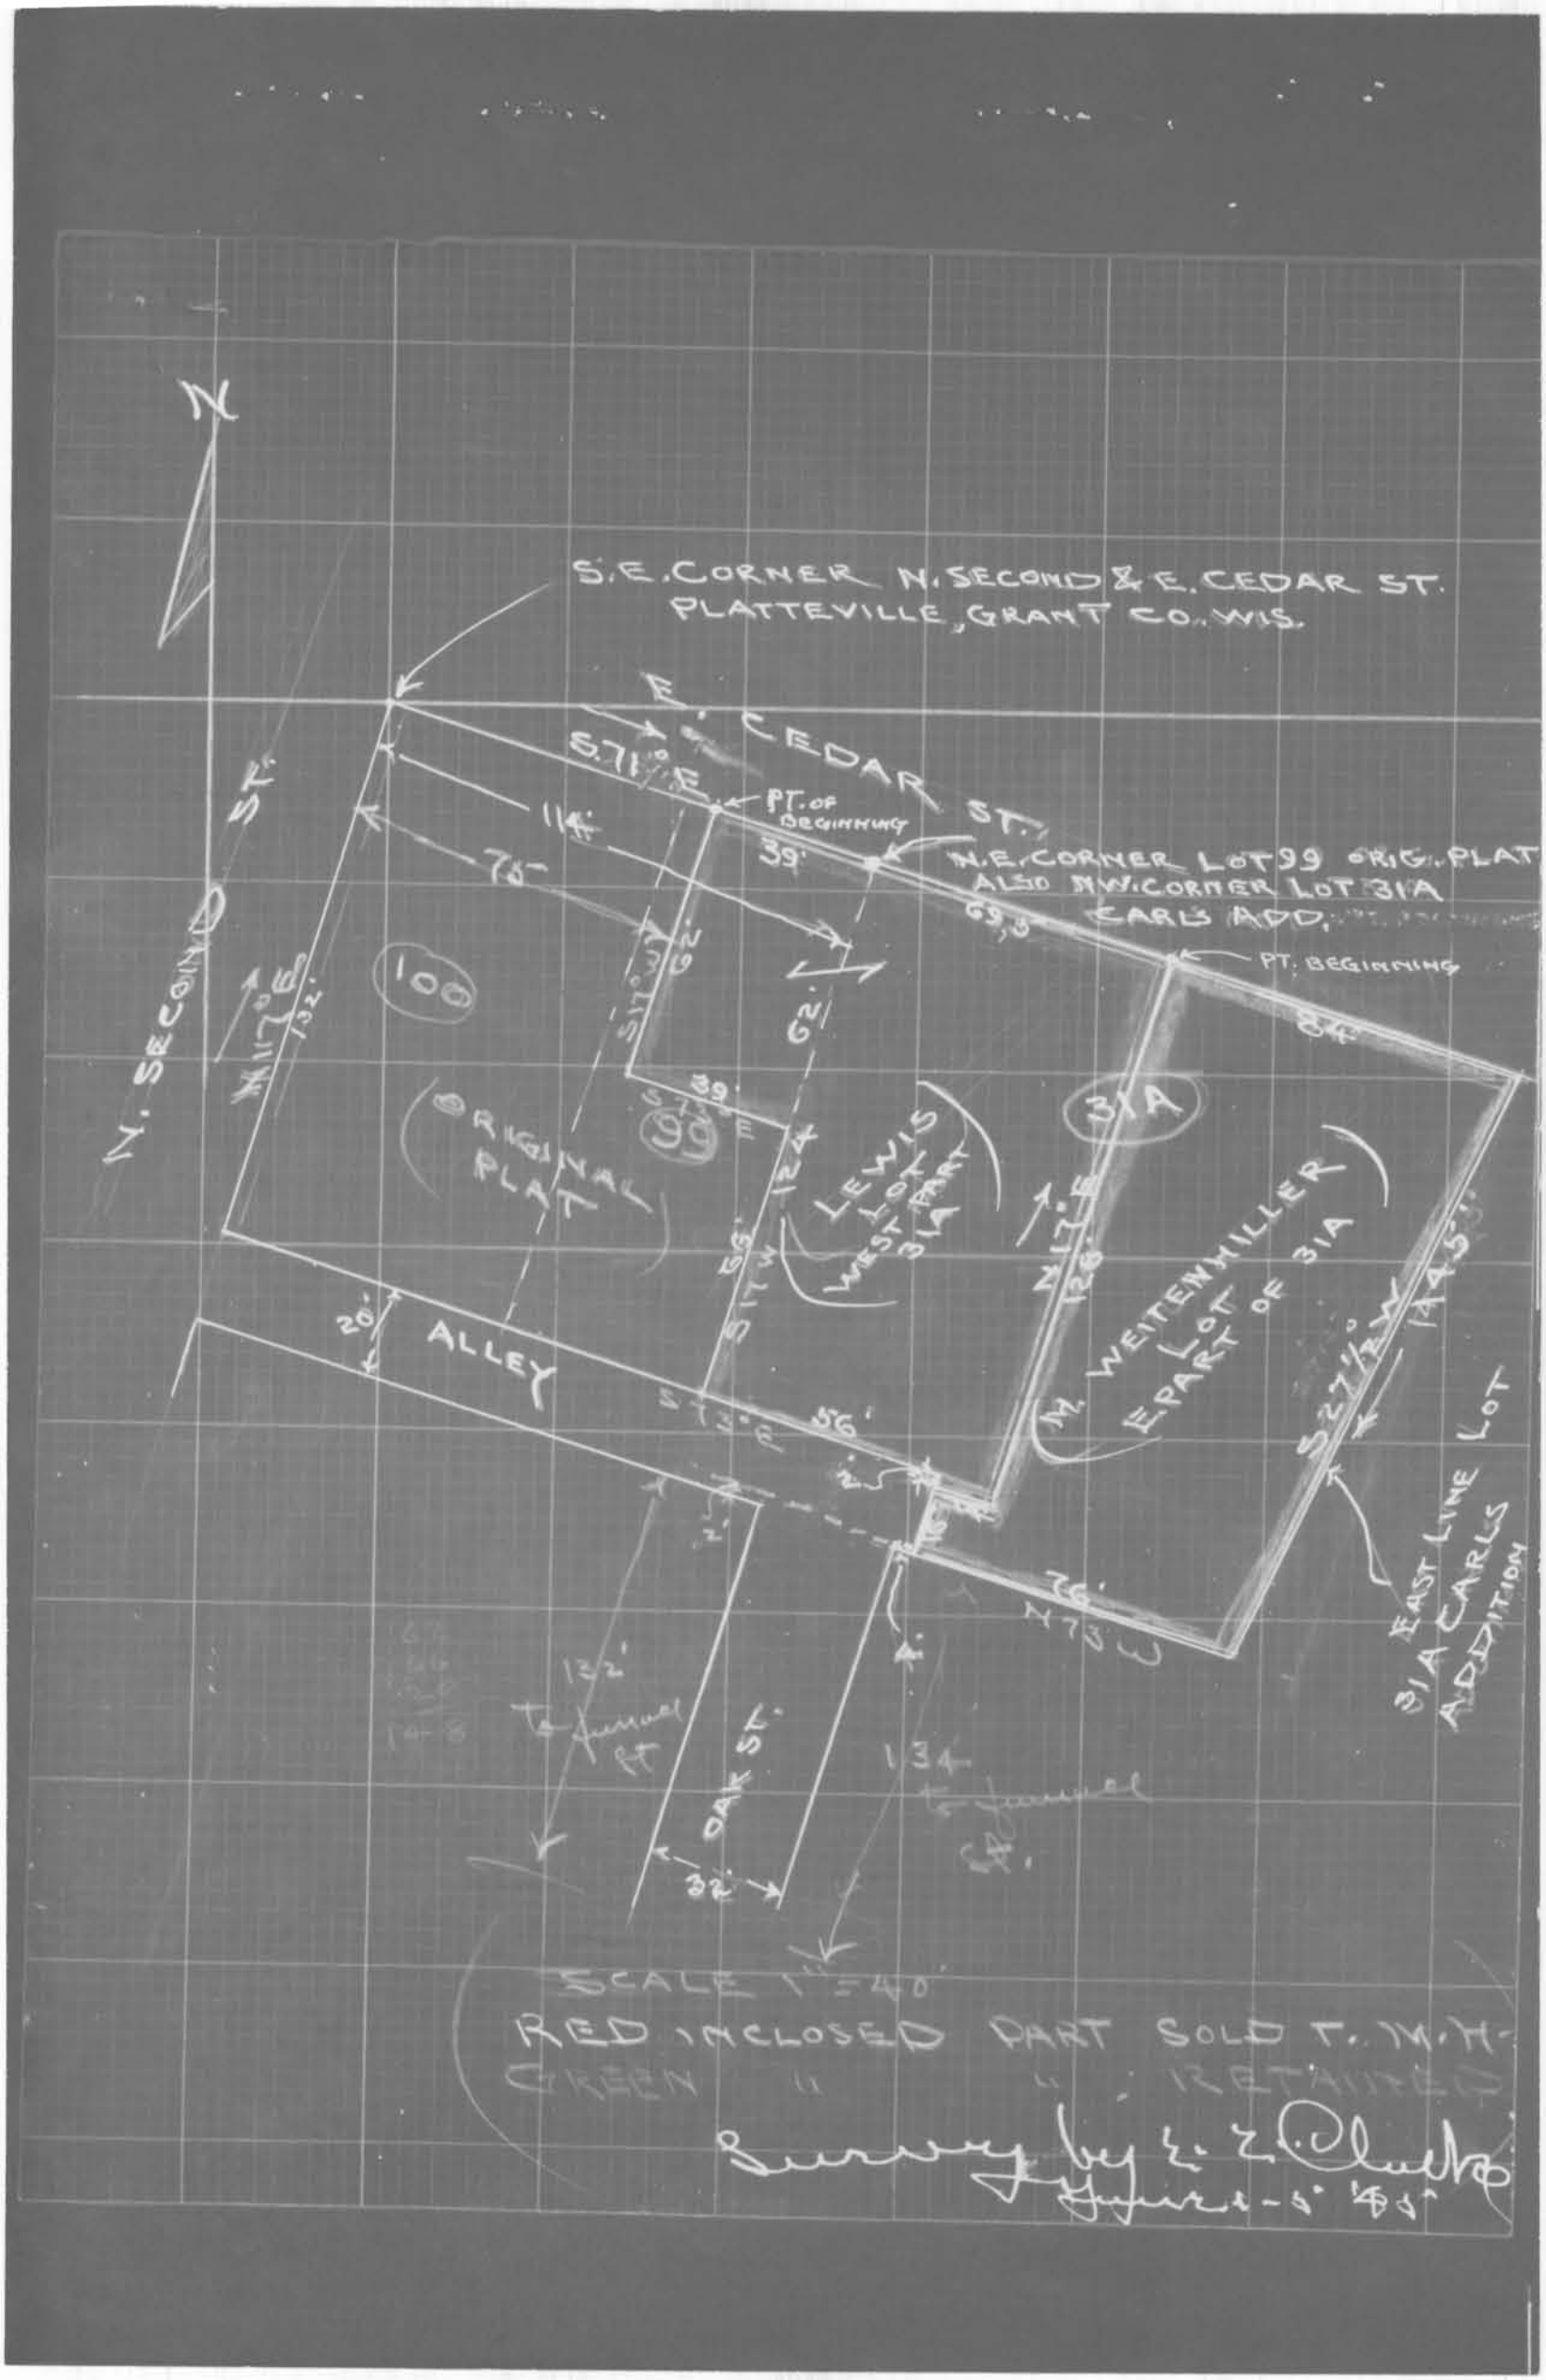
N
S.E. CORNER N. SECOND & E. CEDAR ST.
PLATTEVILLE, GRANT CO., WIS.
E. CEDAR ST.
S.71° E.
PT. OF BEGINNING
114'
75'
39'
N.E. CORNER LOT 99 ORIG. PLAT
ALSO N.W. CORNER LOT 31A
EARLS ADD.
69.5
PT. BEGINNING
84'
N. SECOND ST.
N.17° E.
132'
100
S.17° W.
62'
62'
39'
S.73° E.
99
31A
ORIGINAL PLAT
124'
LEWIS LOT WEST PART 31A
N.17° E.
126'
M. WEITENMILLER LOT E PART OF 31A
S.27½° W.
144.5'
20'
ALLEY
S.17° E.
56'
76'
N.73° W.
31A EAST LINE LOT EARLS ADDITION
132' to Tunnel St
OAK ST.
32'
134' to Tunnel St.
SCALE 1" = 40'
RED INCLOSED PART SOLD T. W. H.
GREEN " " RETAINED
Survey by E. E. Clark
