

**BOCKL DEVELOPMENT CORP.
SURVEY
LANCASTER, WISC.**

SCALE 1" = 10'


Legend

- ⊕ 1" X 24" IRON PIPE SET BY THIS SURVEY
- ⊙ MANHOLE
- ==== 8" SANITARY SEWER PIPE
- 24" STORM SEWER PIPE
- ===== 6" DIA. WATER MAIN
- +--- POWER LINES
- ⊙ DENOTES TREES
- GAS LINE


HOMER D. RALPH, JR.
SURVEYOR FOR GRANT
COUNTY, WISCONSIN



729 - 8/13/69

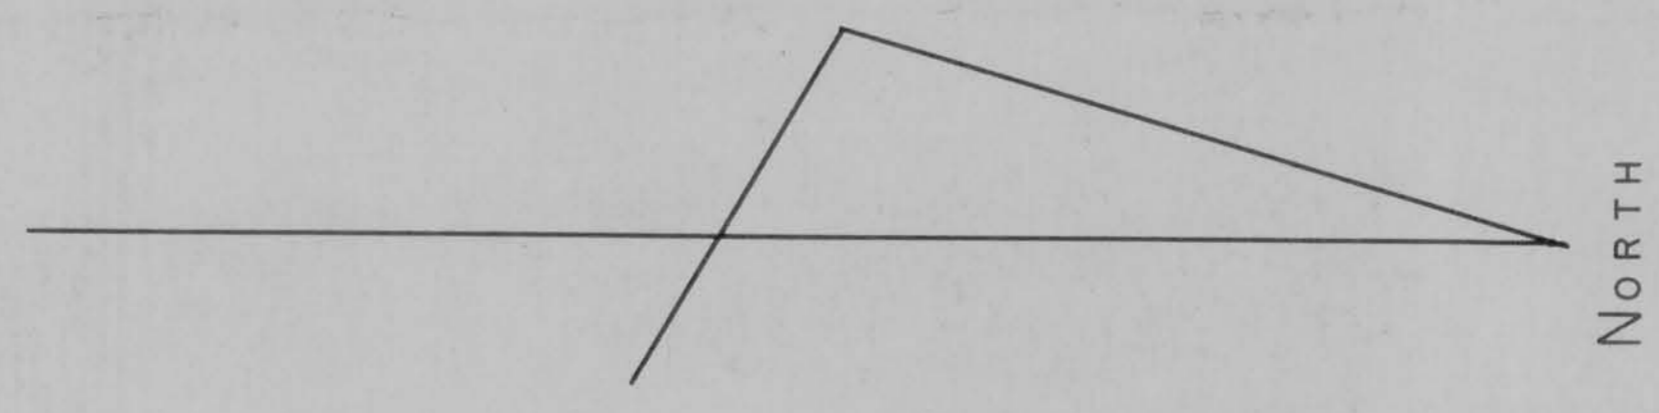

LANDS RETAINED
BY
ST. CLEMENT
CONGREGATION

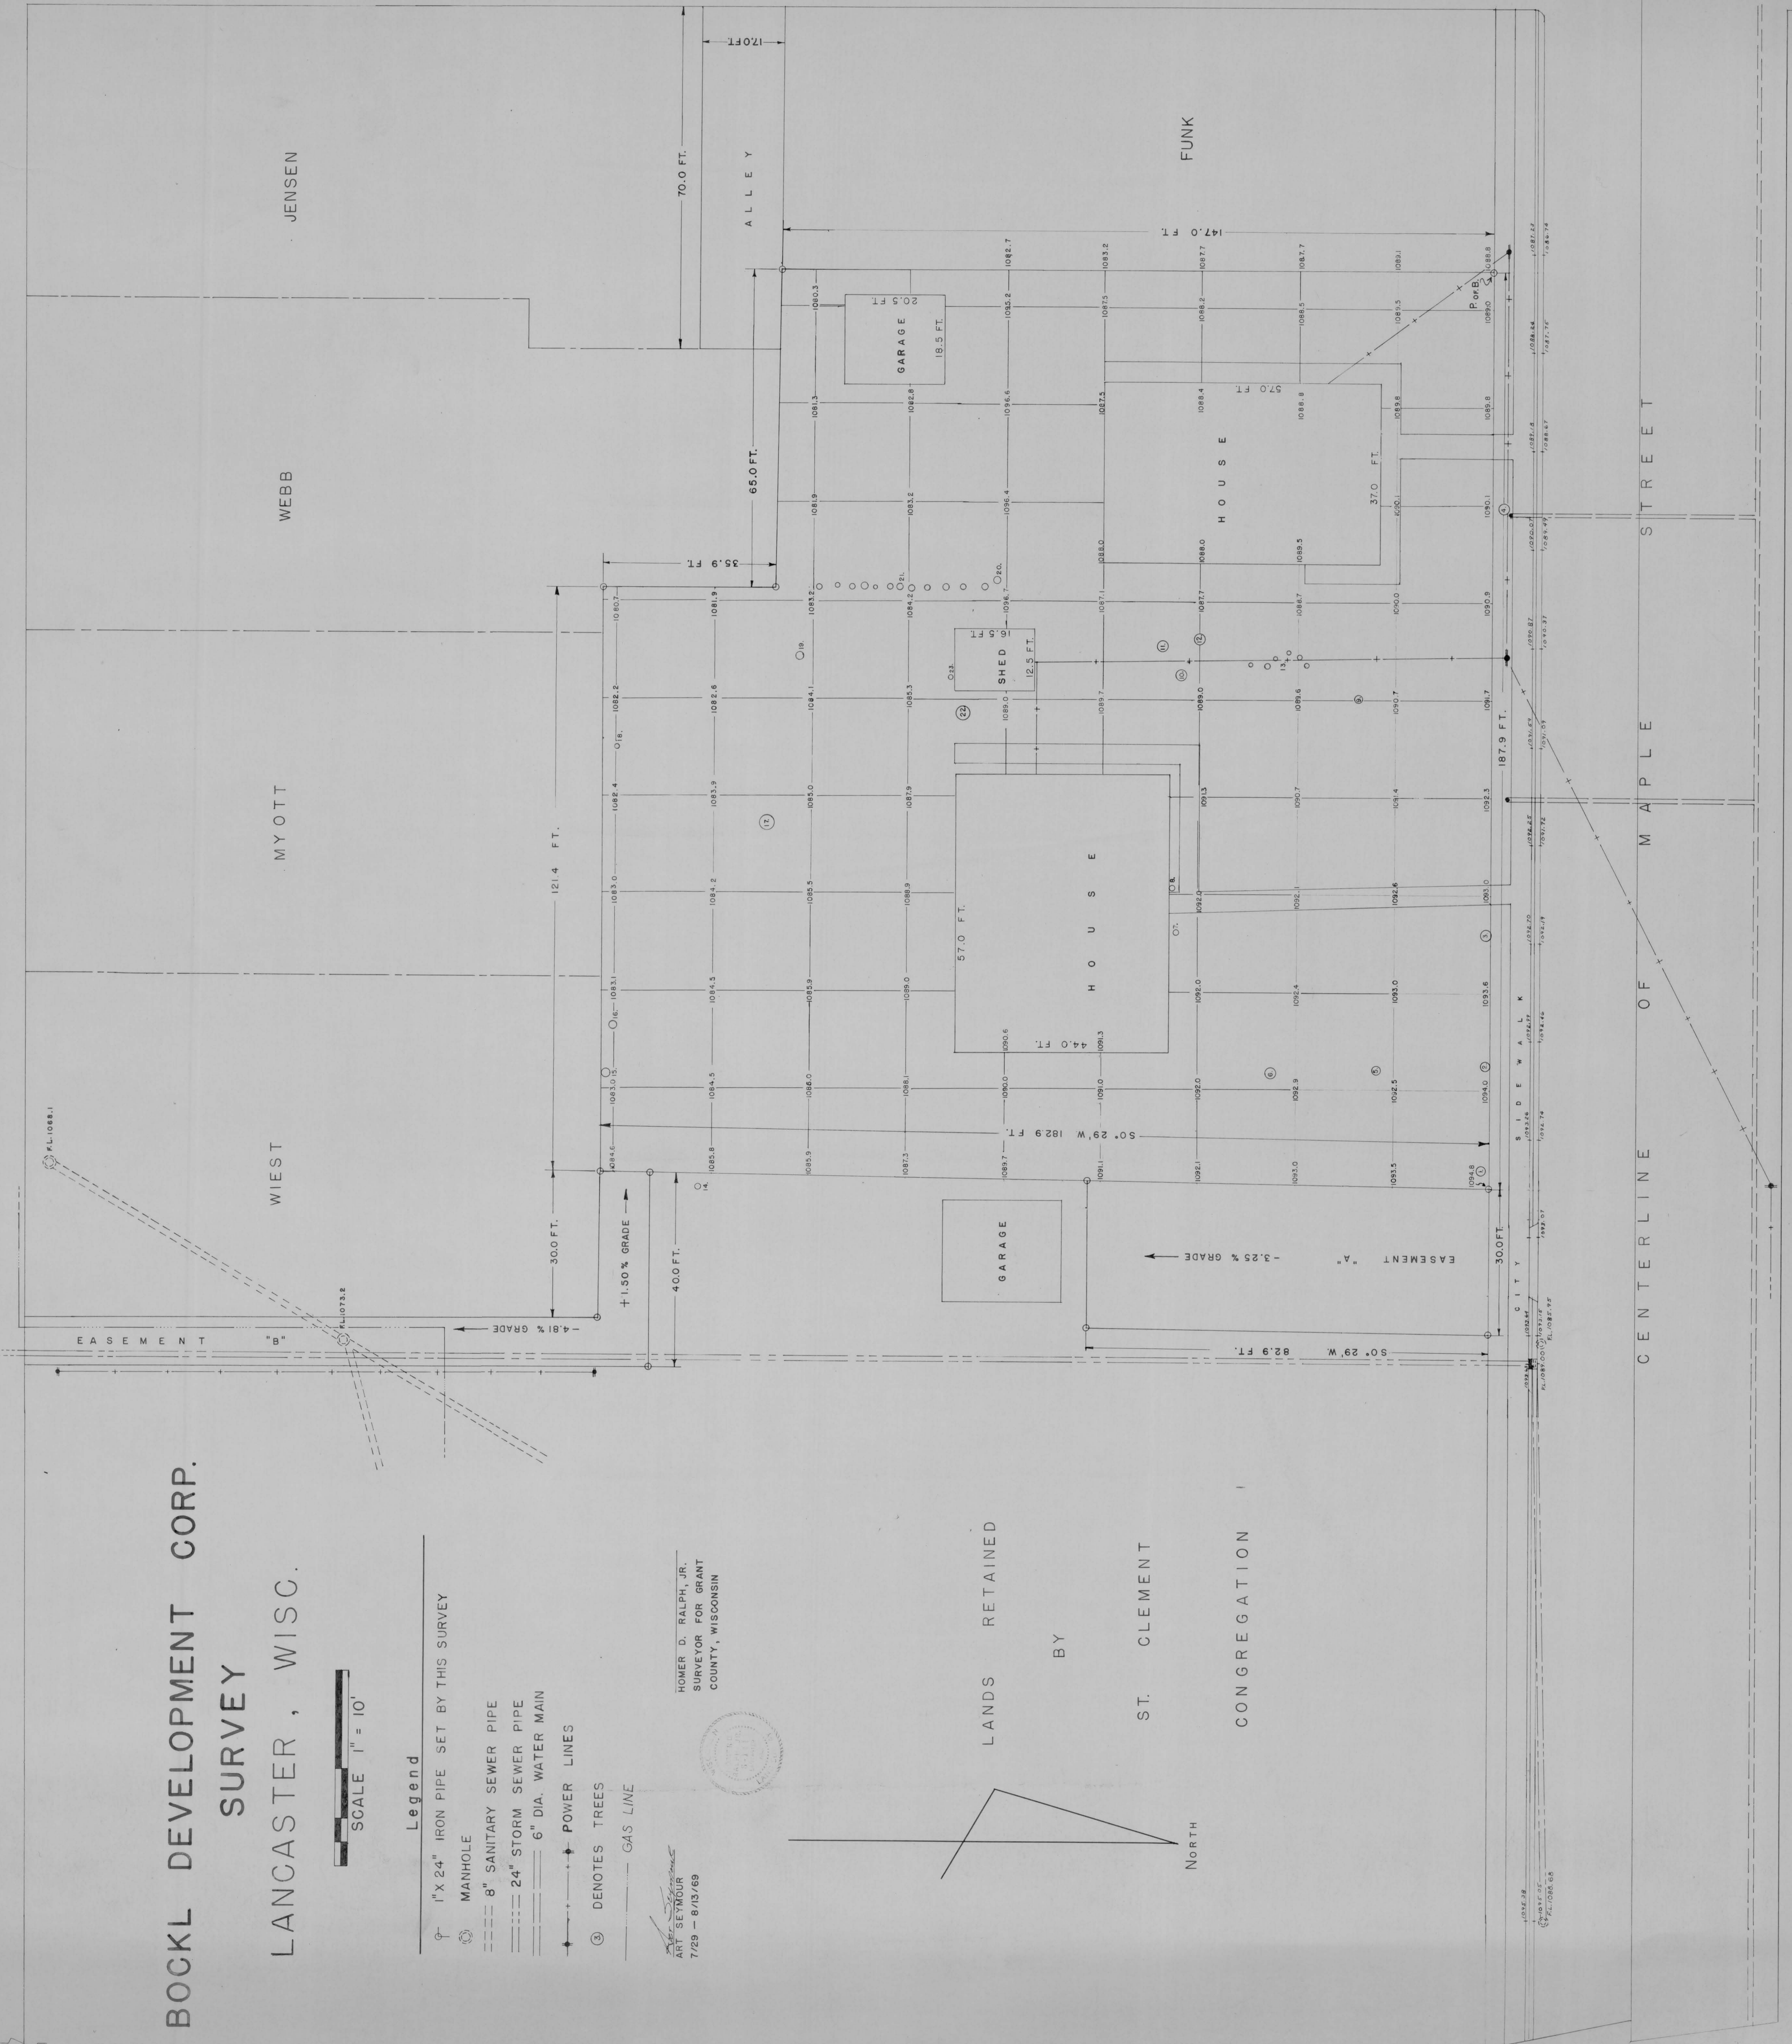

