RIBLET SURVEY

A PART OF THE S. W. 1/4 OF SECTION 35, T 5 N R 3 W OF THE 4TH P. M. IN GRANT COUNTY, WISCONSIN

SCALE 1" = 40'

N

Homer D. Ralph, Jr.
HOMER D. RALPH, JR.
SURVEYOR
WIS. REG. NO. S-141
11/13/71

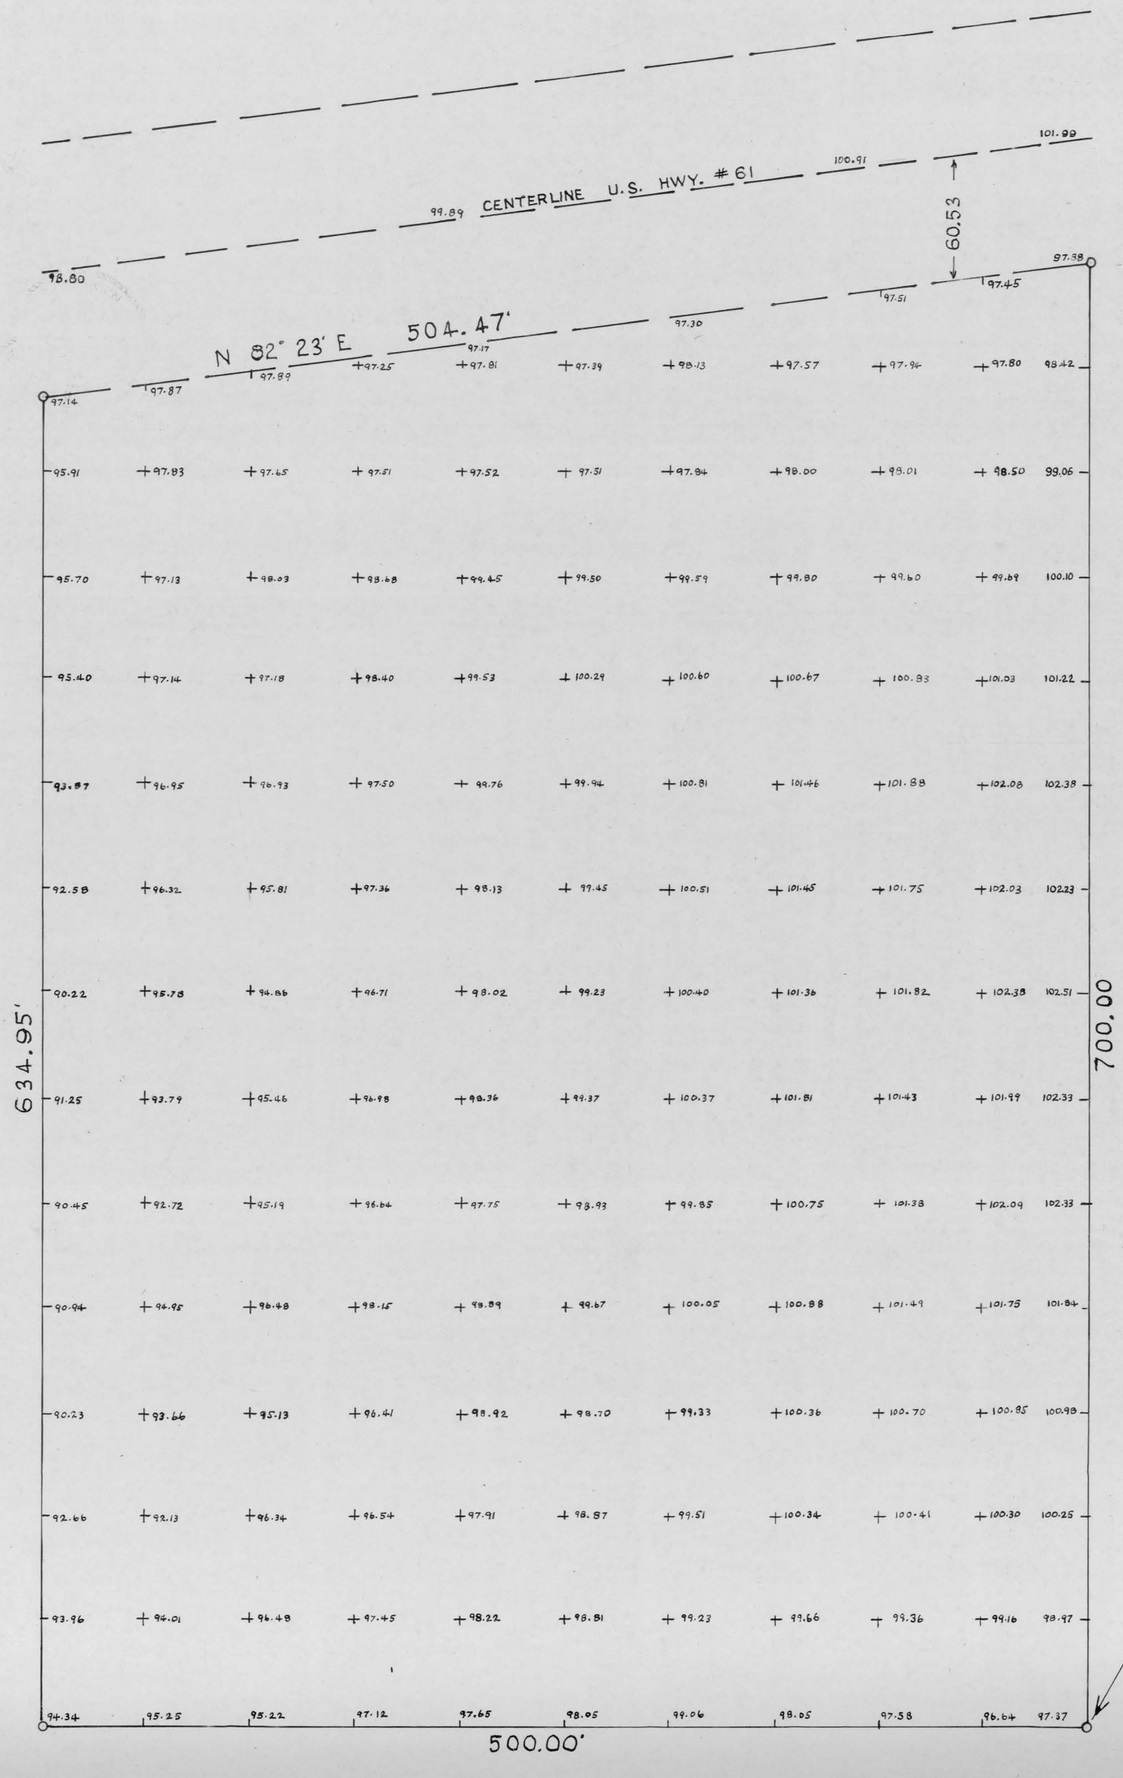

DESCRIPTION
P OF B 793.40 FEET NORTH AND 600.00 FEET WEST OF S.E. COR. OF W. 3/4 OF SAID S.W. 1/4