# PLAT OF SURVEY

THOMAS DEMUTH

OF A PARCEL OF LAND LOCATED IN THE NE 1/4 OF THE NE 1/4 OF SECTION 25, T 1 N, R 1 W OF THE 4TH P.M., GRANT COUNTY, WISCONSIN, MORE PARTICULARLY DESCRIBED AS FOLLOWS:

COMMENCING AT THE NE CORNER OF SECTION 25, T 1 N, R 1 W OF THE 4TH P.M., GRANT COUNTY, WISCONSIN; THENCE SOUTH 660.00' ALONG THE EAST LINE OF SAID SECTION 25; THENCE WEST 483.16' TO THE POINT OF BEGINNING;
THENCE WEST 176.84';
THENCE N 05°19'00" E 129.50';
THENCE EAST 164.84';
THENCE SOUTH 128.95' TO THE POINT OF BEGINNING, CONTAINING 0.506 ACRES, MORE OR LESS, AND BEING SUBJECT TO ANY AND ALL EASEMENTS OF RECORD.

SURVEYOR'S CERTIFICATE: I, LARRY L. AUSTIN, REGISTERED WISCONSIN LAND SURVEYOR, DO HEREBY CERTIFY THAT I HAVE SURVEYED THE ABOVE DESCRIBED PARCEL IN ACCORDANCE WITH THE INSTRUCTIONS OF TOM DEMUTH OF HAZEL GREEN, WI., AND THAT THIS PLAT IS AN ACCURATE REPRESENTATION OF SAID SURVEY TO THE BEST OF MY KNOWLEDGE AND BELIEF.

Larry L. Austin

6/12/90
DATE

LARRY L. AUSTIN RLS1903
LARRY AUSTIN ENGINEERING
RT 2
LANCASTER, WI. 53813
PHONE (608) 723-6363

WISCONSIN
LARRY L. AUSTIN
S-1903
LANCASTER
WI
LAND SURVEYOR
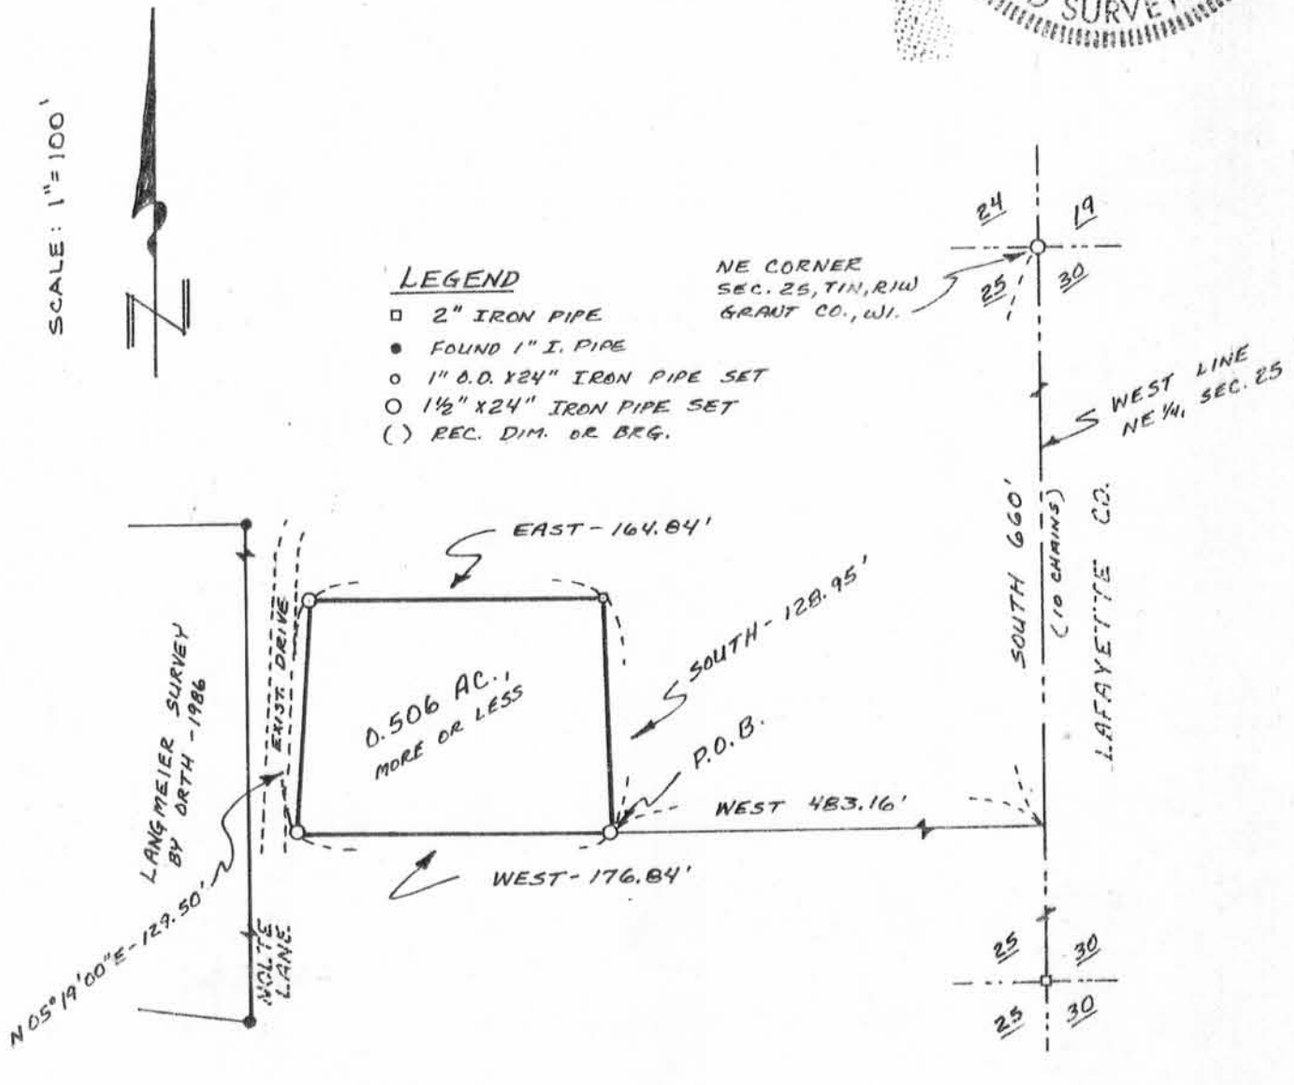
BEARING REFERENCE: FOR PURPOSES OF THIS SURVEY BEARINGS ARE REFERENCED TO THE EAST LINE OF NE 1/4 OF SECTION 25, T 1 N, R 1 W, WHICH IS ASSUMED TO BEAR SOUTH.