OFFICE OF

JOHN T. BUSER

GRANT COUNTY SURVEYOR

PLATTEVILLE, WIS.
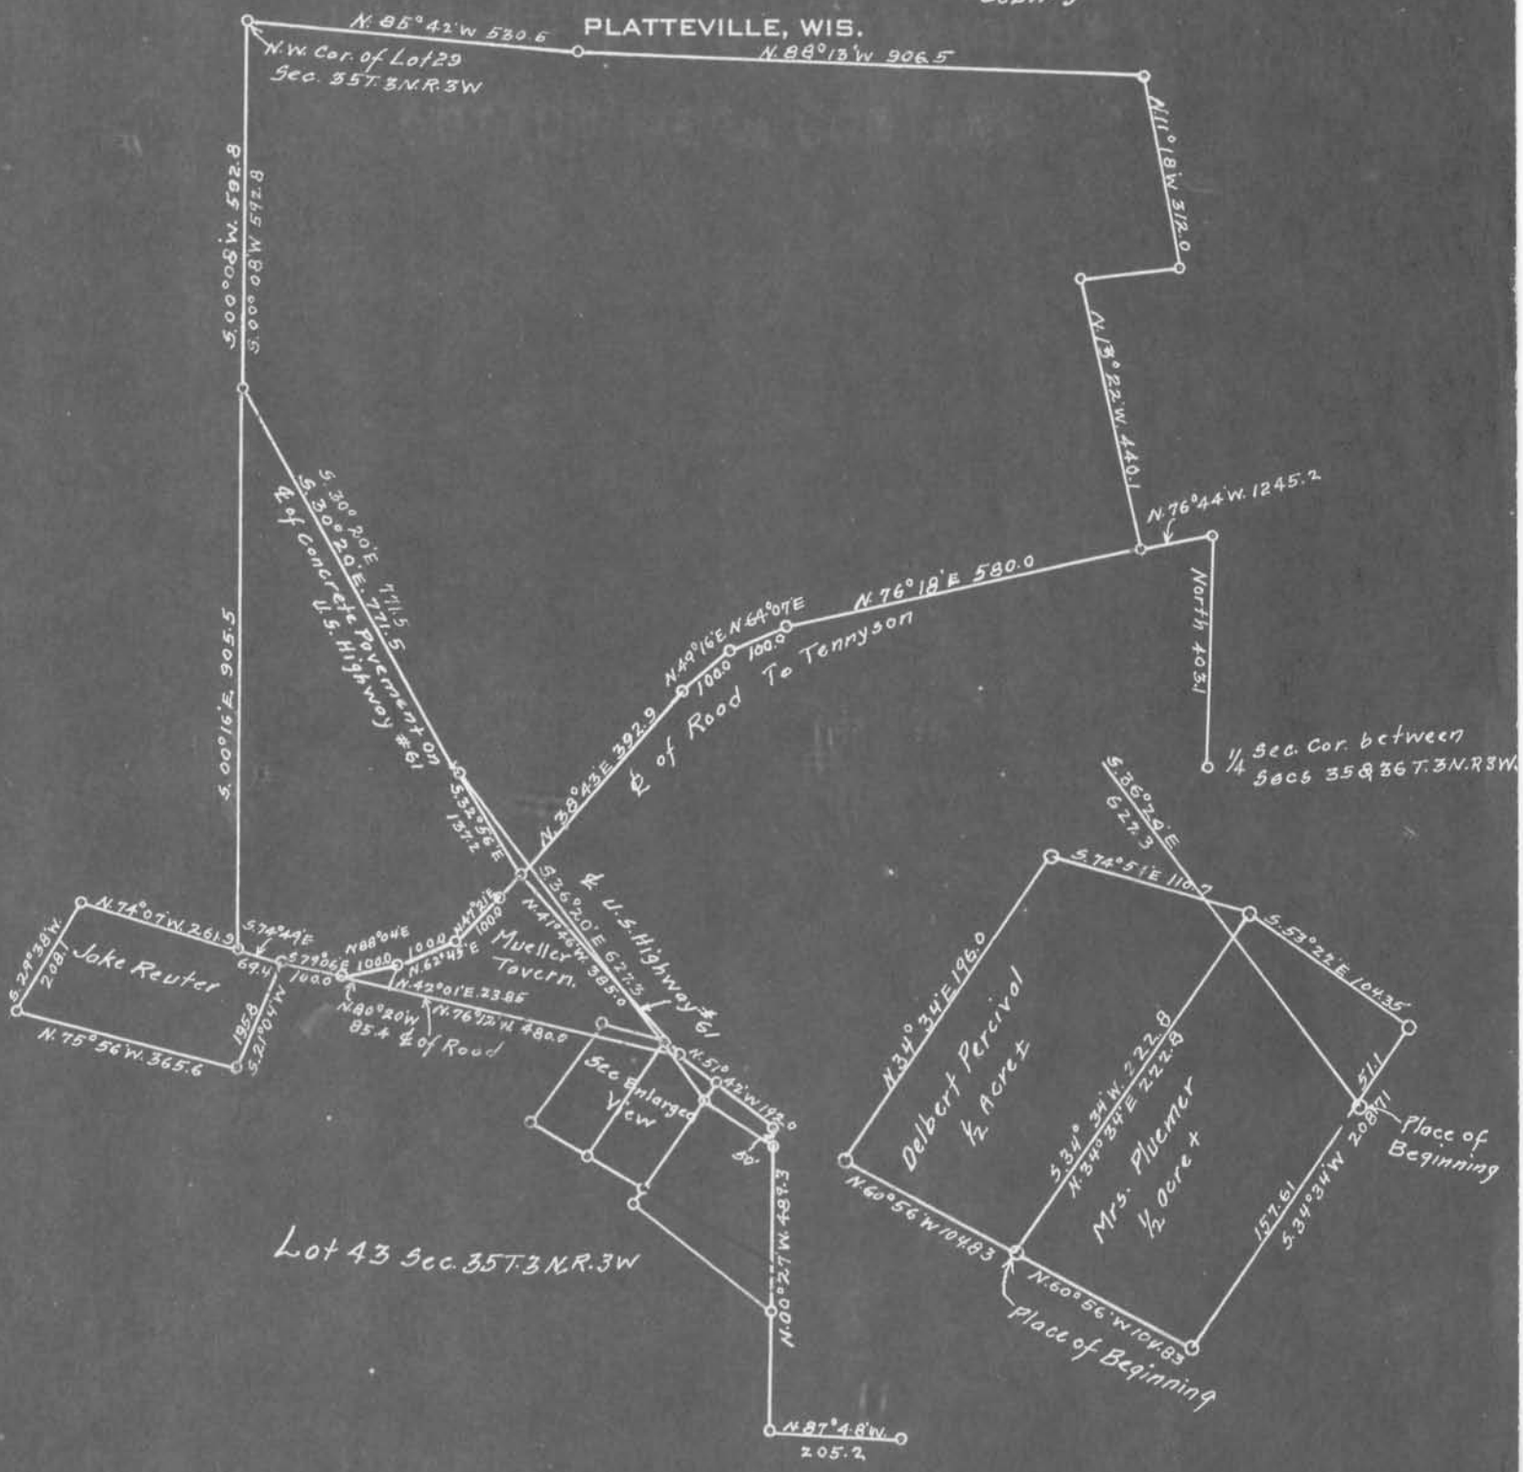
Surveyed May 13-1947
Delbert Percival
John T. Buser
County Surveyor.