DELBERT PERCIVAL BY WALTER BURBACH.

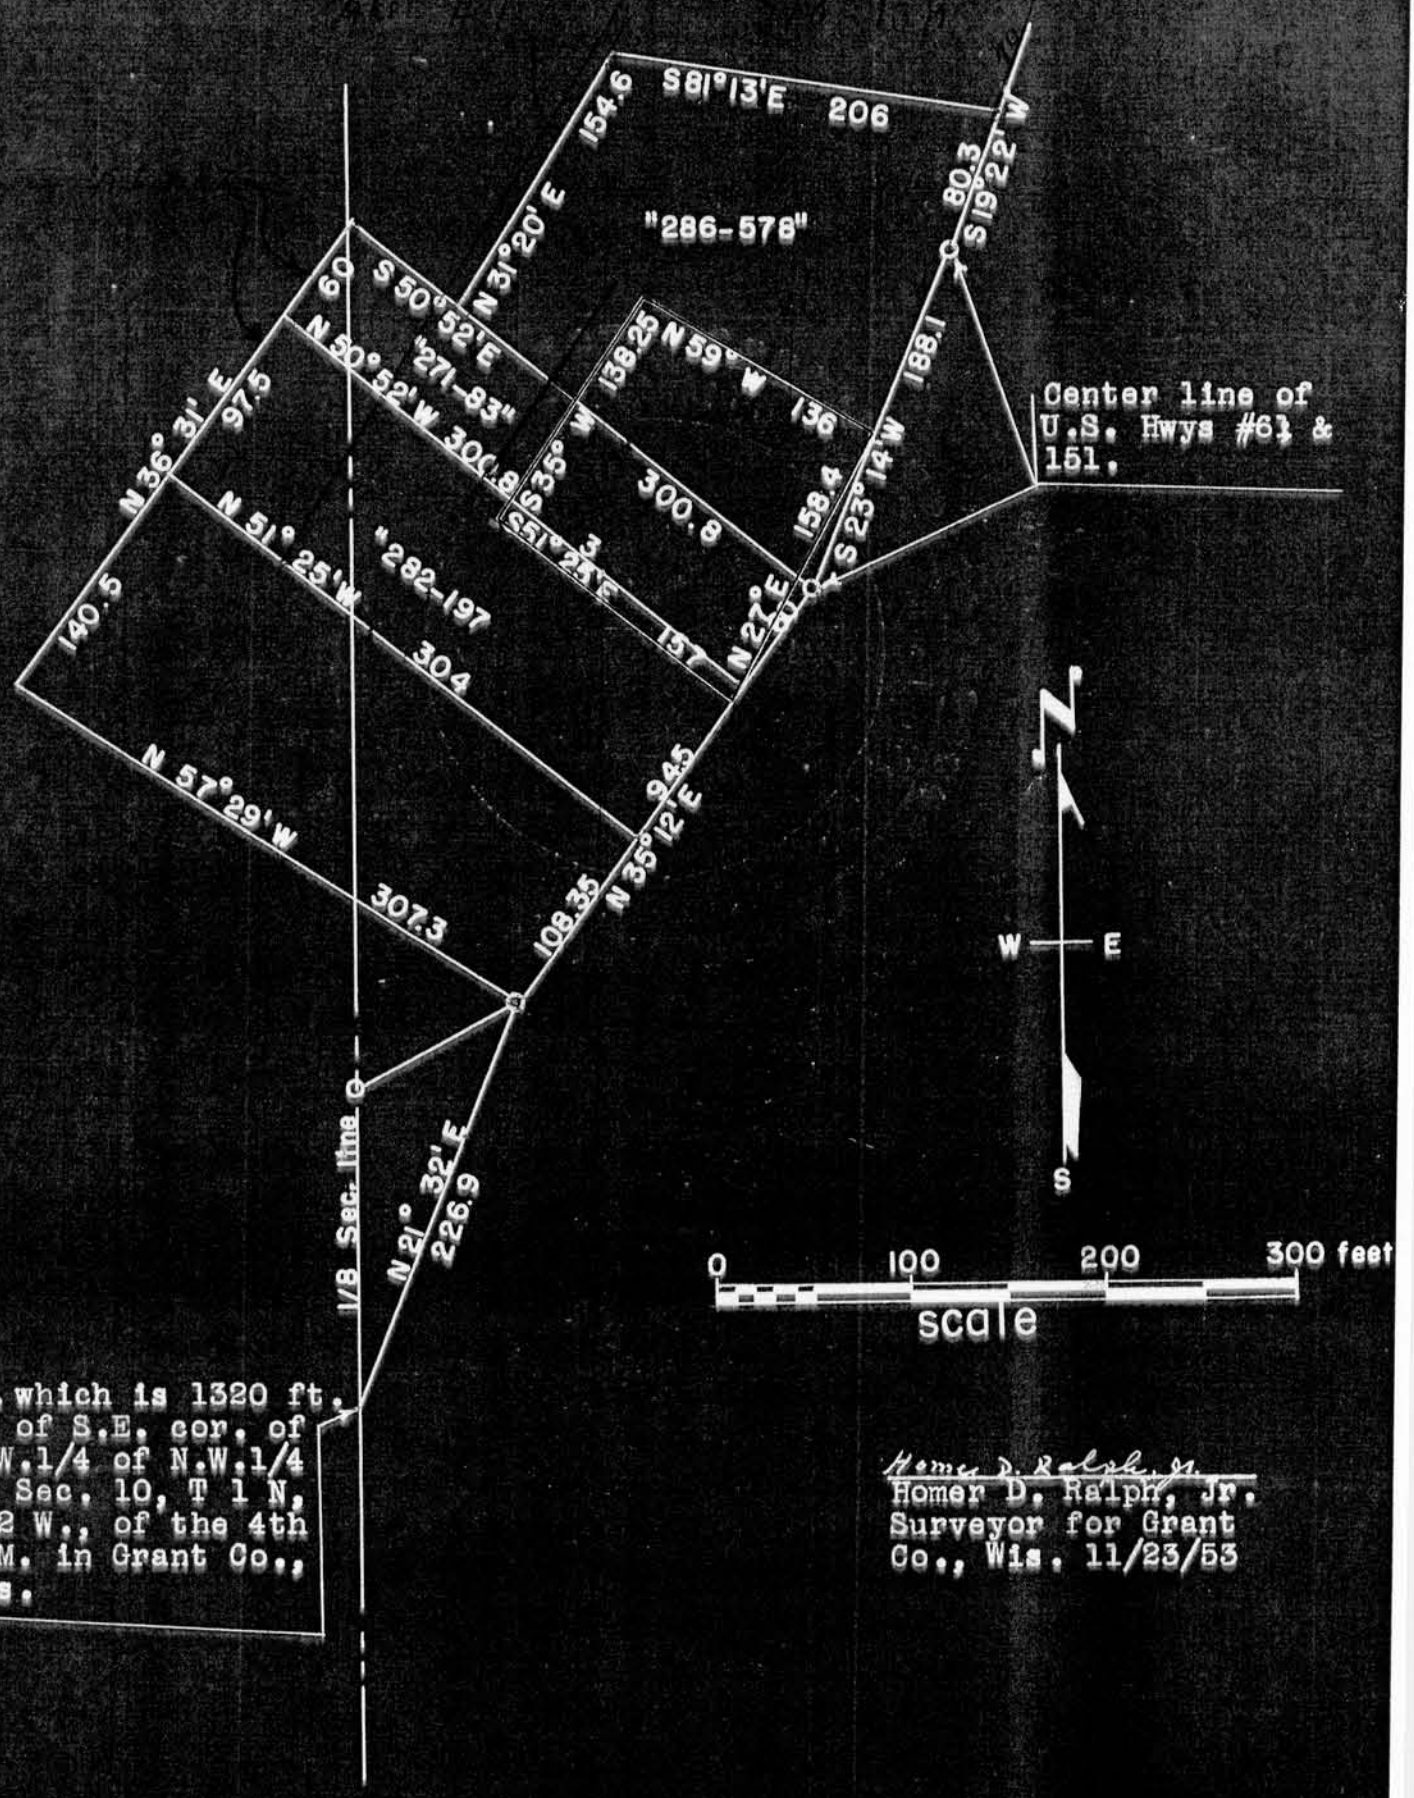

Homer D. Ralph, Jr.
Homer D. Ralph, Jr.
Surveyor for Grant Co., Wis. 11/23/53