SURVEY PLAT

HOVELSRUD CONSULTING ASSOCIATES
ENGINEERING - LAND SURVEYING
RICHLAND COUNTY BANK BUILDING
RICHLAND CENTER, WISCONSIN 53581

Survey for: Don Pitzer Date: May 21, 1970

Parcel Located in the SE Corner of the N½ of the NW¼ of Section 34; T.8N.; R.3W.; Grant County, Wisconsin

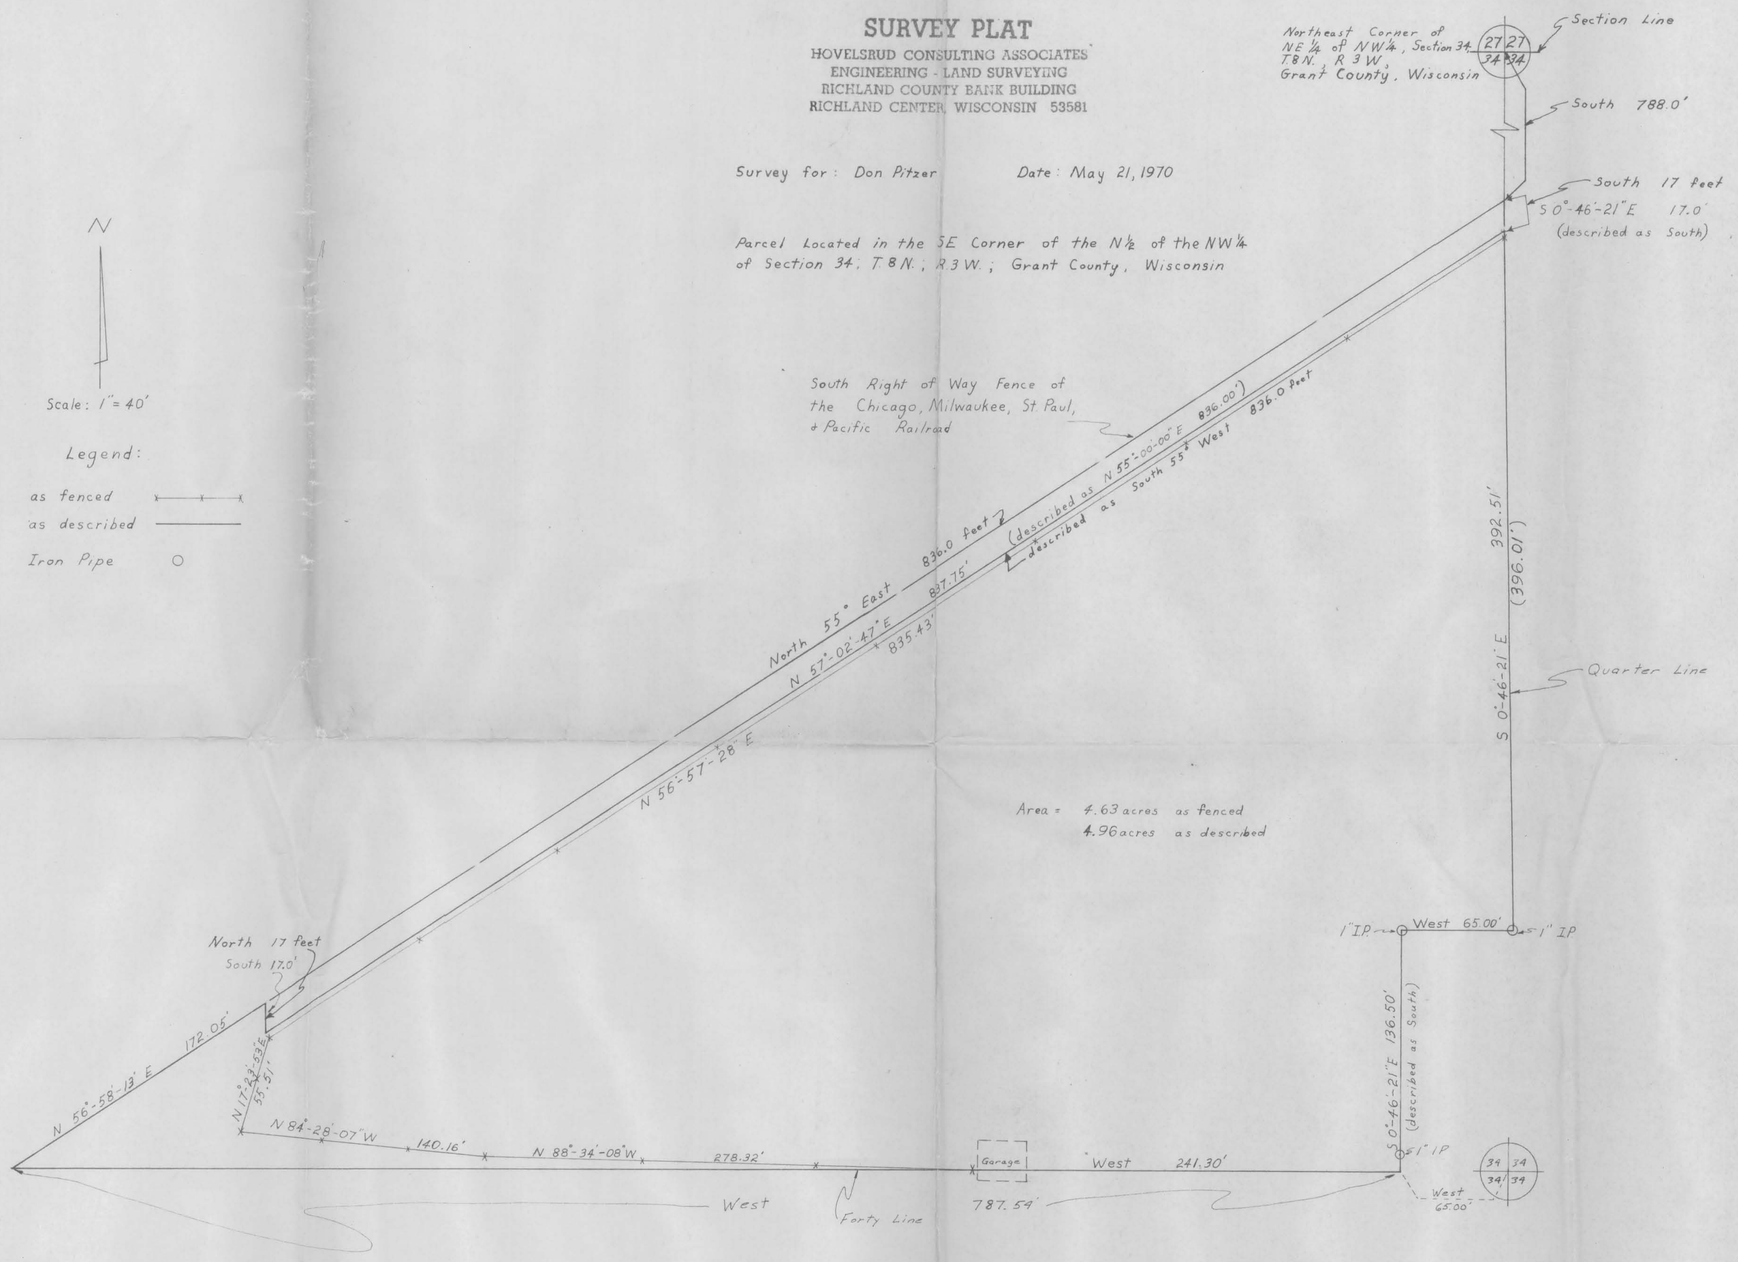

Rev. 5-24-71
Rev. 4-28-71

948

SURVEY PLAT

HOVELSRUD CONSULTING ASSOCIATES
ENGINEERING | LAND SURVEYING
RICHLAND CENTER, WISCONSIN 53581

Survey for: Don Pitzer Date: May 21, 1970

Parcel Located in the SE Corner of the N½ of the NW¼ of Section 34, T8N, R3W, Grant County, Wisconsin

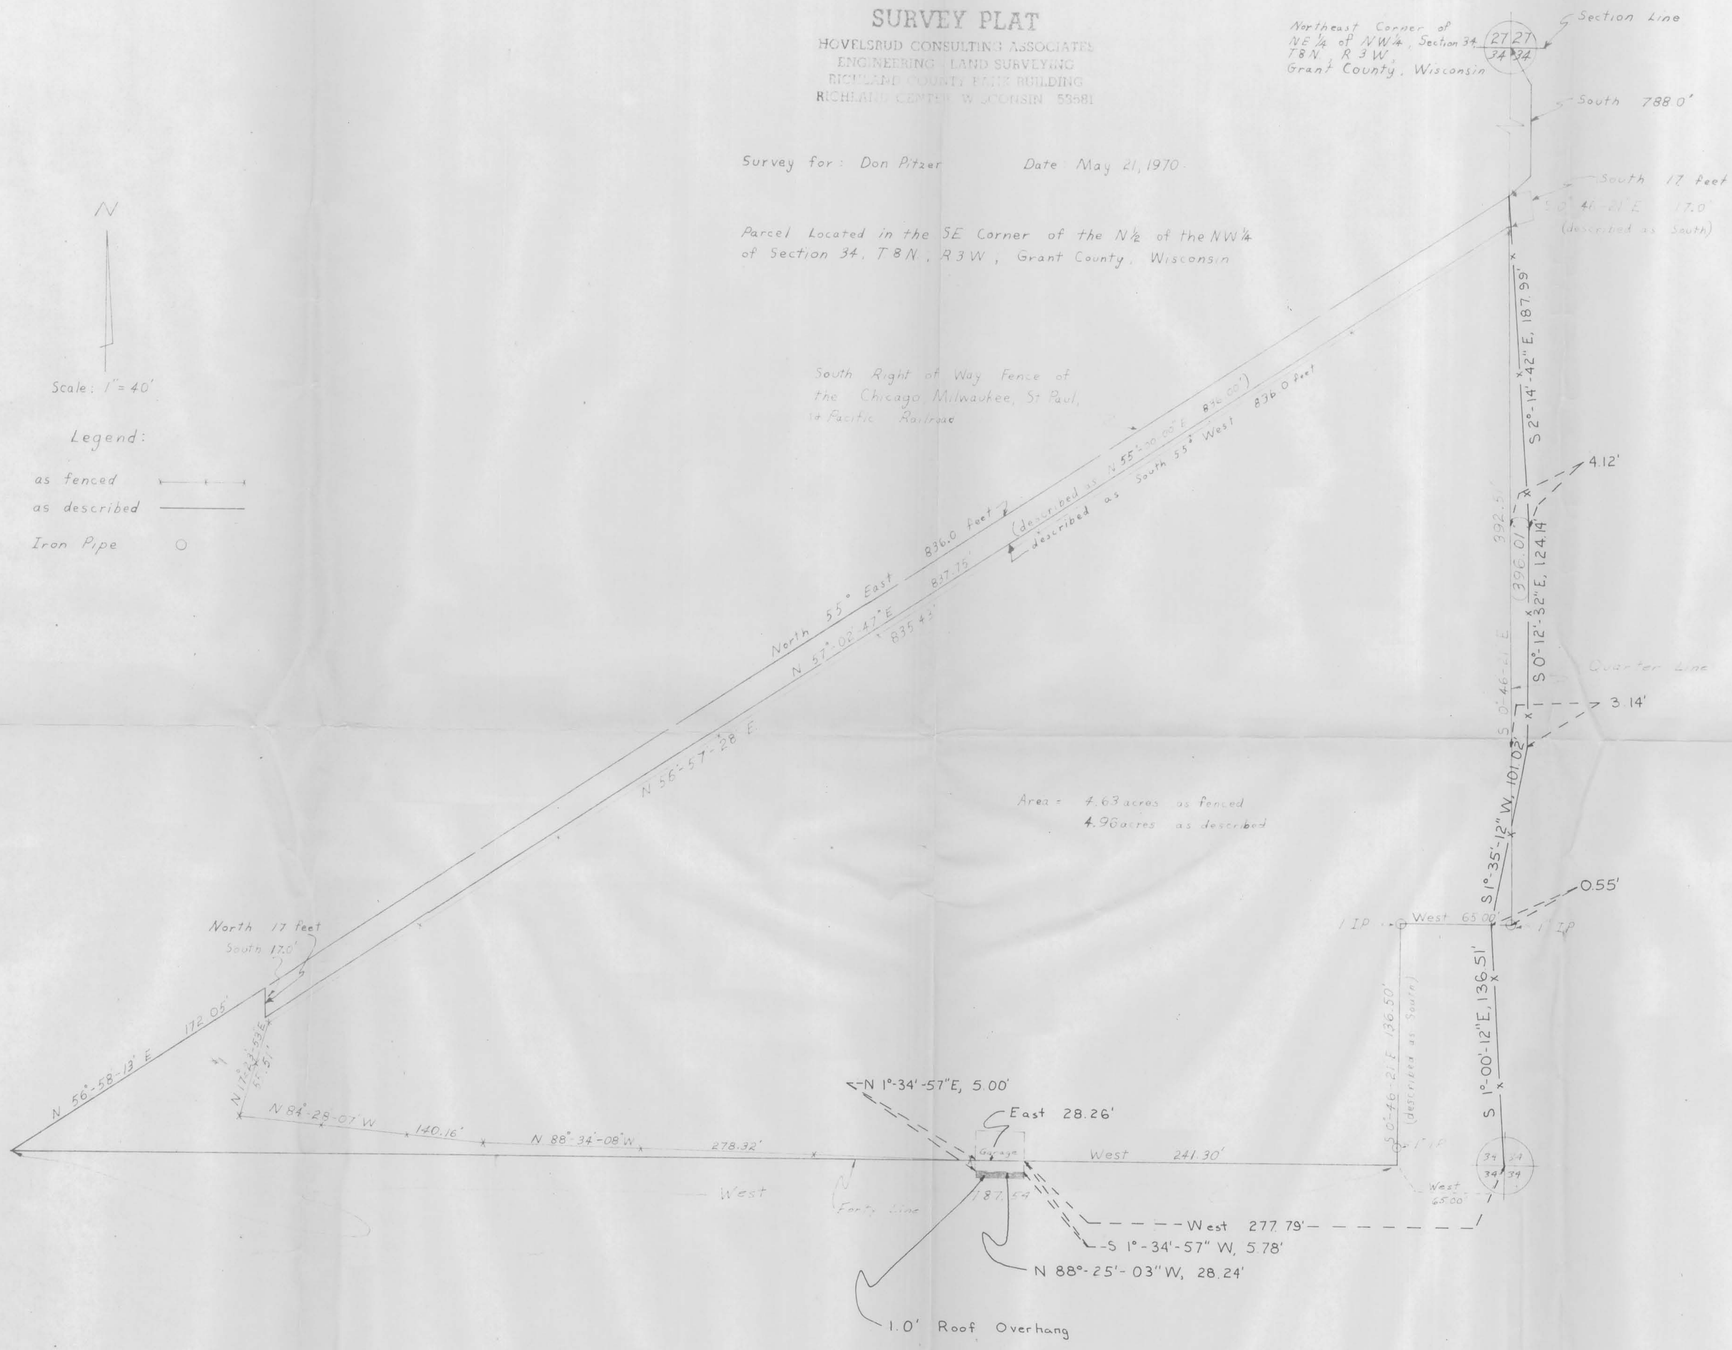

Rev. 5-24-71
Rev. 4-28-71

948