LEIFRIED SURVEY 3630
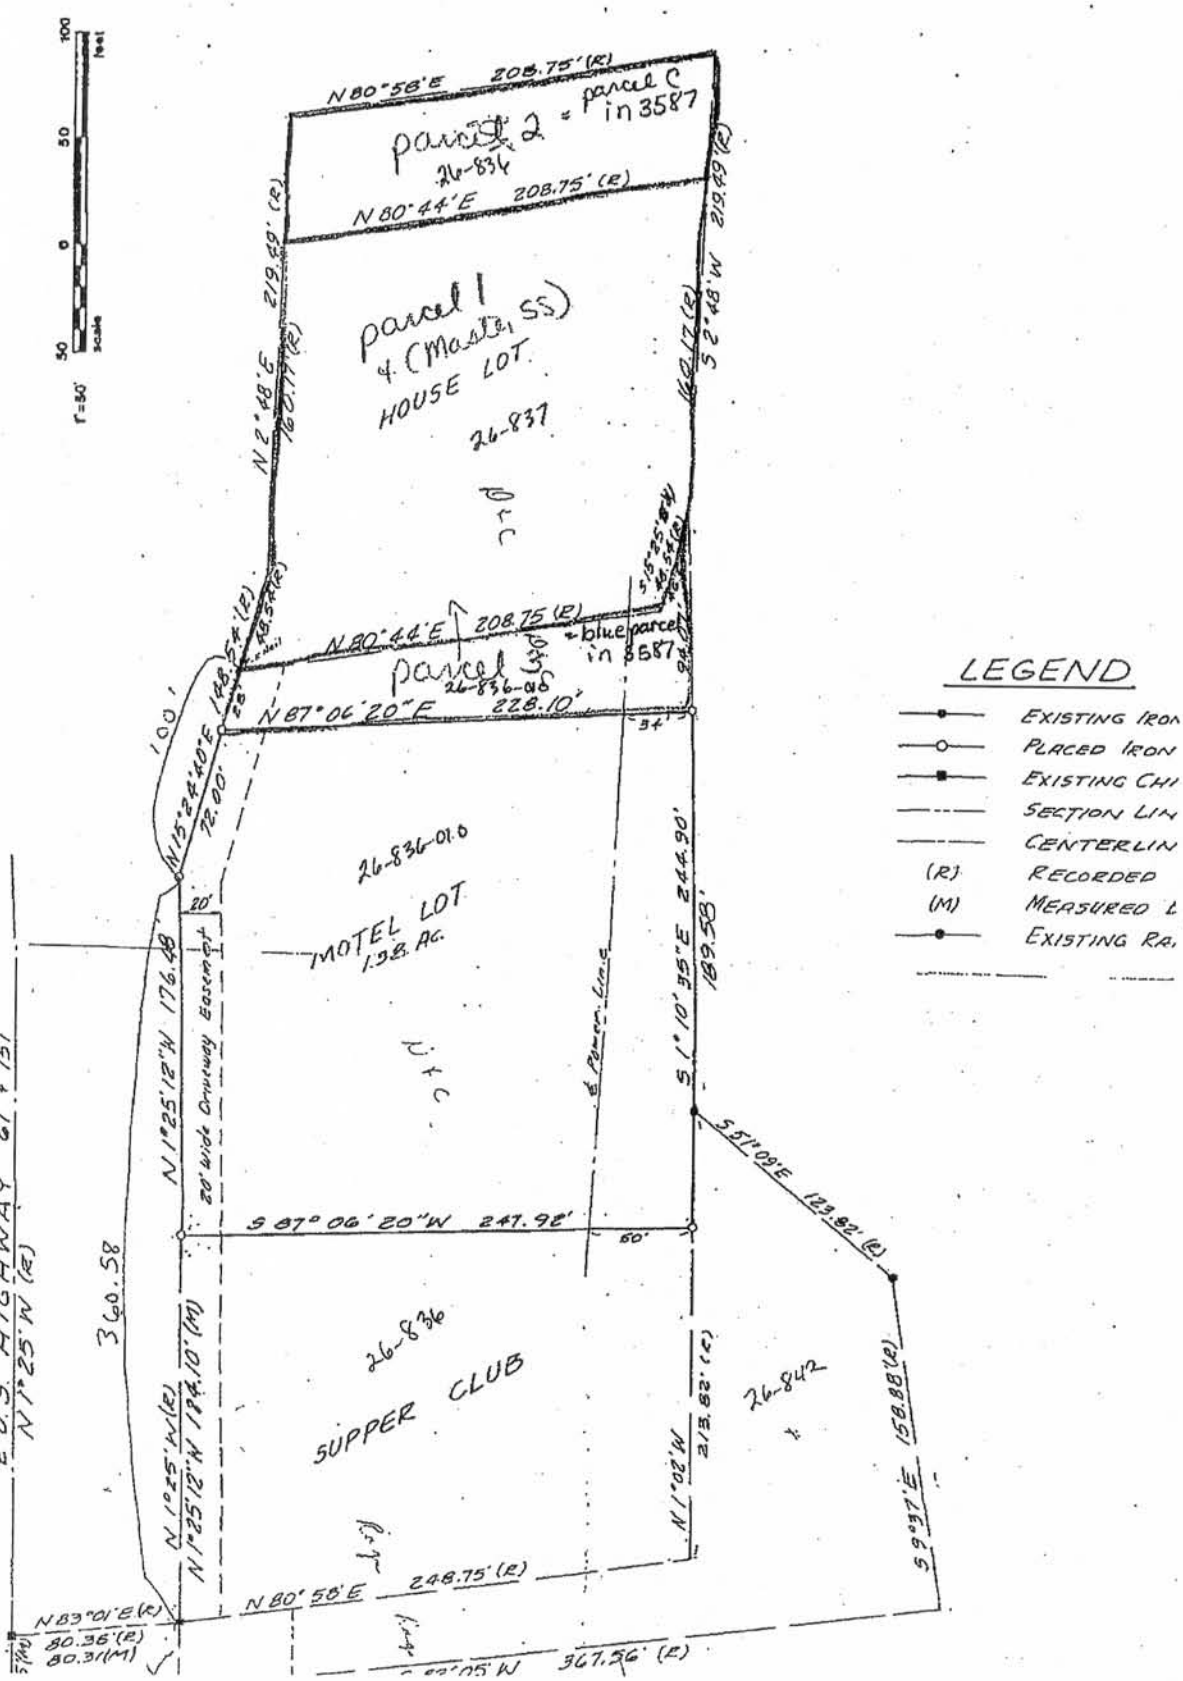
ON 21, T 1N, R2W, 4th P.M. GRANT COUNTY