SECTION 36, TOWN 6 NORTH, RANGE 6 WEST,

Date 5/23/1881 Surveyor J. C. Scott

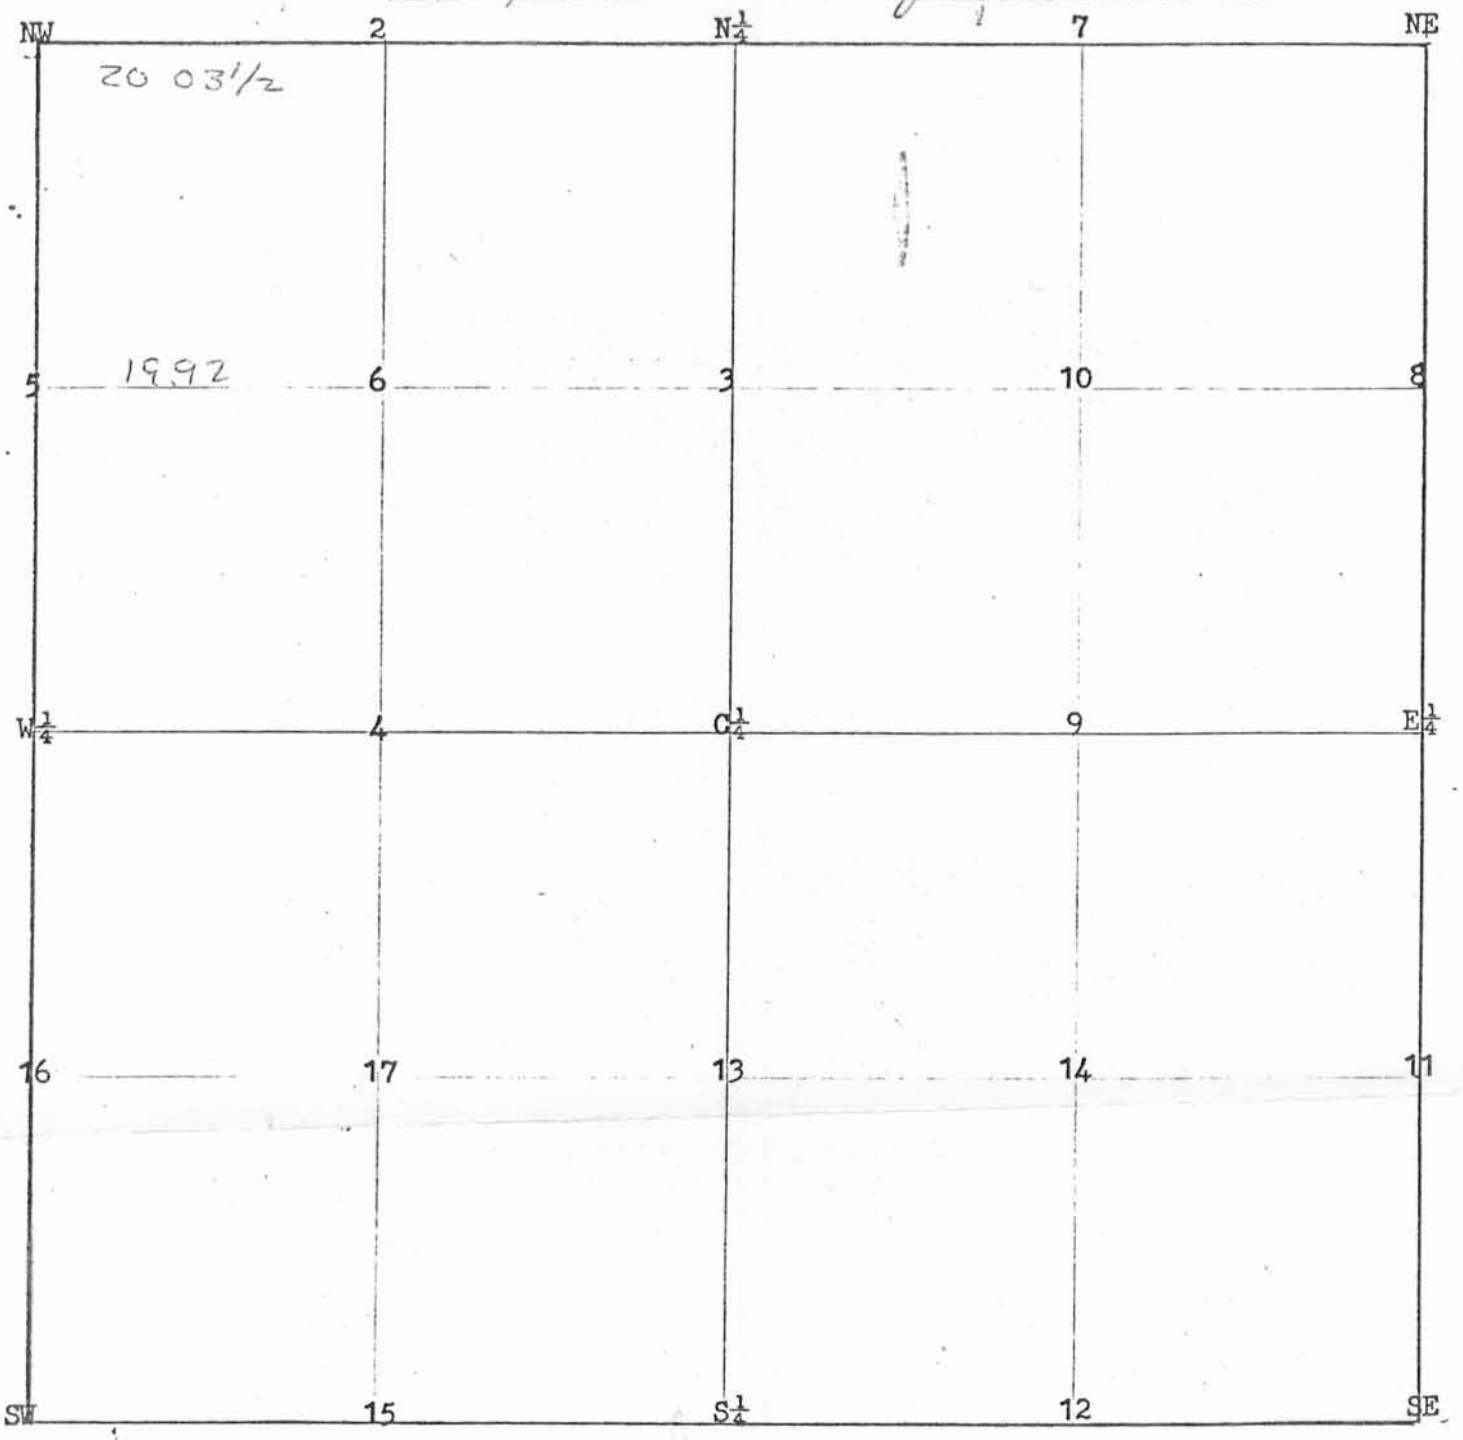

5- Iron rock 8x12x20

6- Woak South 118

NW- Boak 8 S61½W 74½

Woak 7 S62½E 39½

2- Boak 13 N4W 9