HOVELSRUD CONSULTING ASSOCIATES LTD.
ENGINEERING – LAND SURVEYING – PLANNING
BUILDINGS – STRUCTURES – SOIL INVESTIGATIONS
RICHLAND COUNTY BANK BUILDING
RICHLAND CENTER, WISCONSIN 53581

DESCRIPTION FOR: STUART G. URBAN — FEBRUARY 20, 1978

SHEET 3 OF 3

PARCEL LOCATED PARTLY IN THE SW¼ OF THE NE¼ OF SECTION 11, PARTLY IN THE NE¼ OF THE SE¼ OF SECTION 11, PARTLY IN THE NW¼ OF THE SE¼ OF SECTION 11, PARTLY IN THE SW¼ OF THE SE¼ OF SECTION 11, PARTLY IN THE SE¼ OF THE SW¼ OF SECTION 11, PARTLY IN THE SW¼ OF THE SW¼ OF SECTION 11, PARTLY IN GOVERMENT LOT 1 OF FRACTIONAL SECTION 14, PARTLY IN GOVERMENT LOT 2 OF FRACTIONAL SECTION 14, PARTLY IN THE NE¼ OF THE NW¼ OF FRACTIONAL SECTION 14, PARTLY IN THE NW¼ OF THE NE¼ OF FRACTIONAL SECTION 14, PARTLY IN THE NE¼ OF THE NE¼ OF FRACTIONAL SECTION 14, PARTLY IN THE SE¼ OF THE NE¼ OF FRACTIONAL SECTION 14 AND PARTLY IN THE NW¼ OF THE NW¼ OF SECTION 13 ALL IN T 8 N, R 3 W, GRANT COUNTY, WISCONSIN

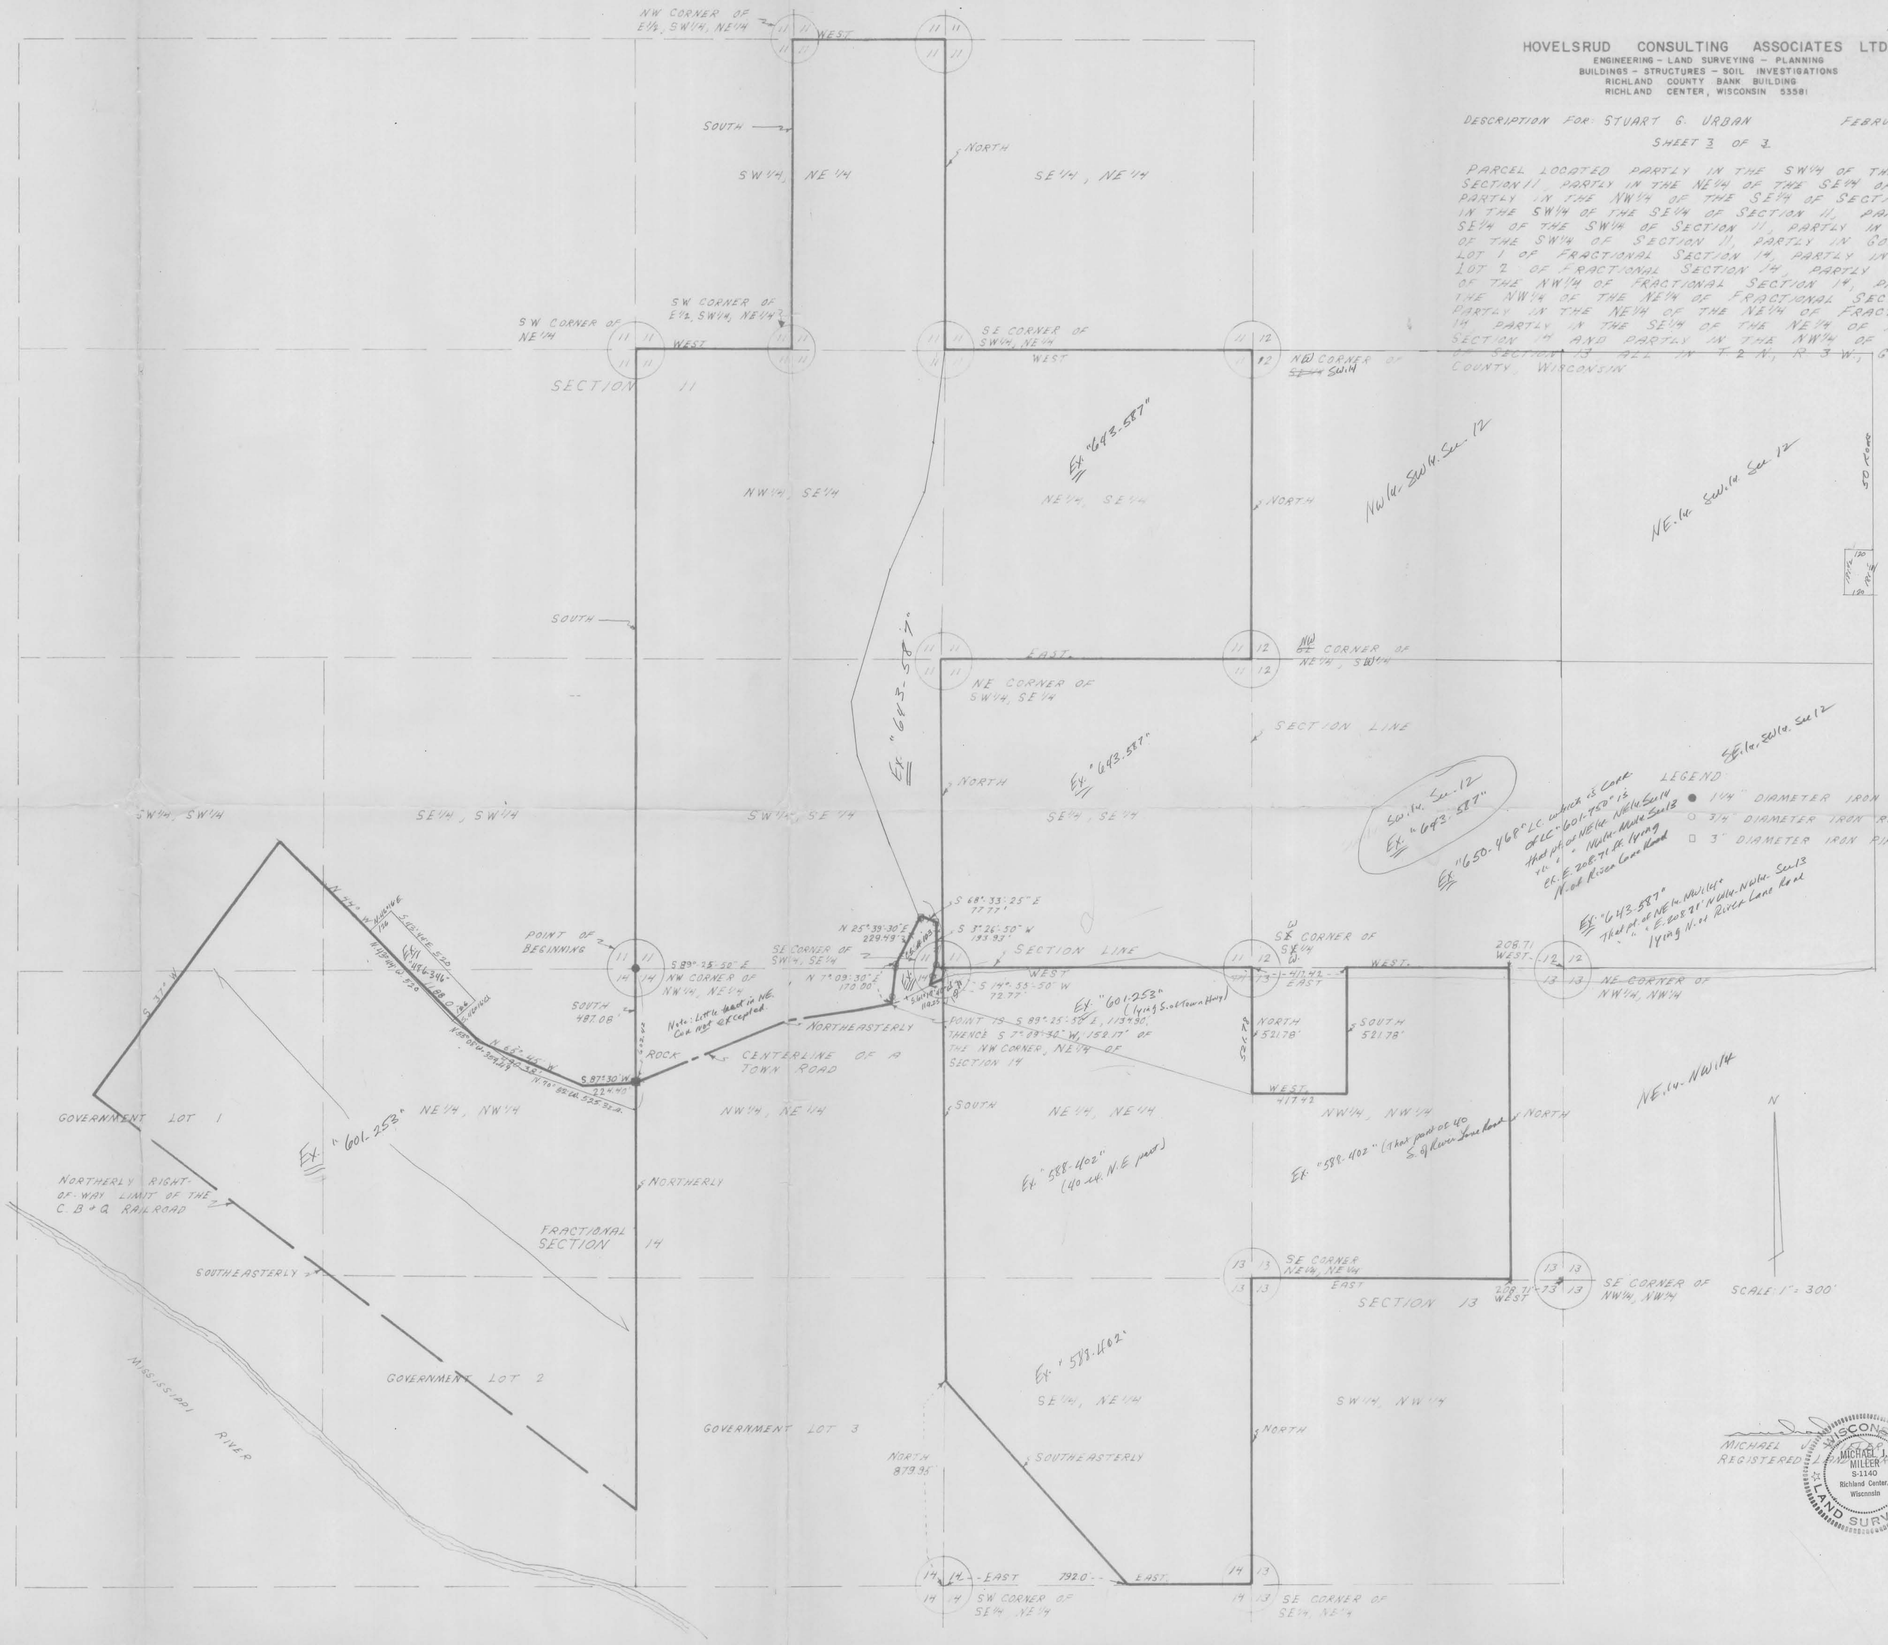

MICHAEL J. MILLER
REGISTERED LAND SURVEYOR S-1140

WISCONSIN MICHAEL J. MILLER S-1140 Richland Center, Wisconsin LAND SURVEYOR

5014.002