EXHIBIT B

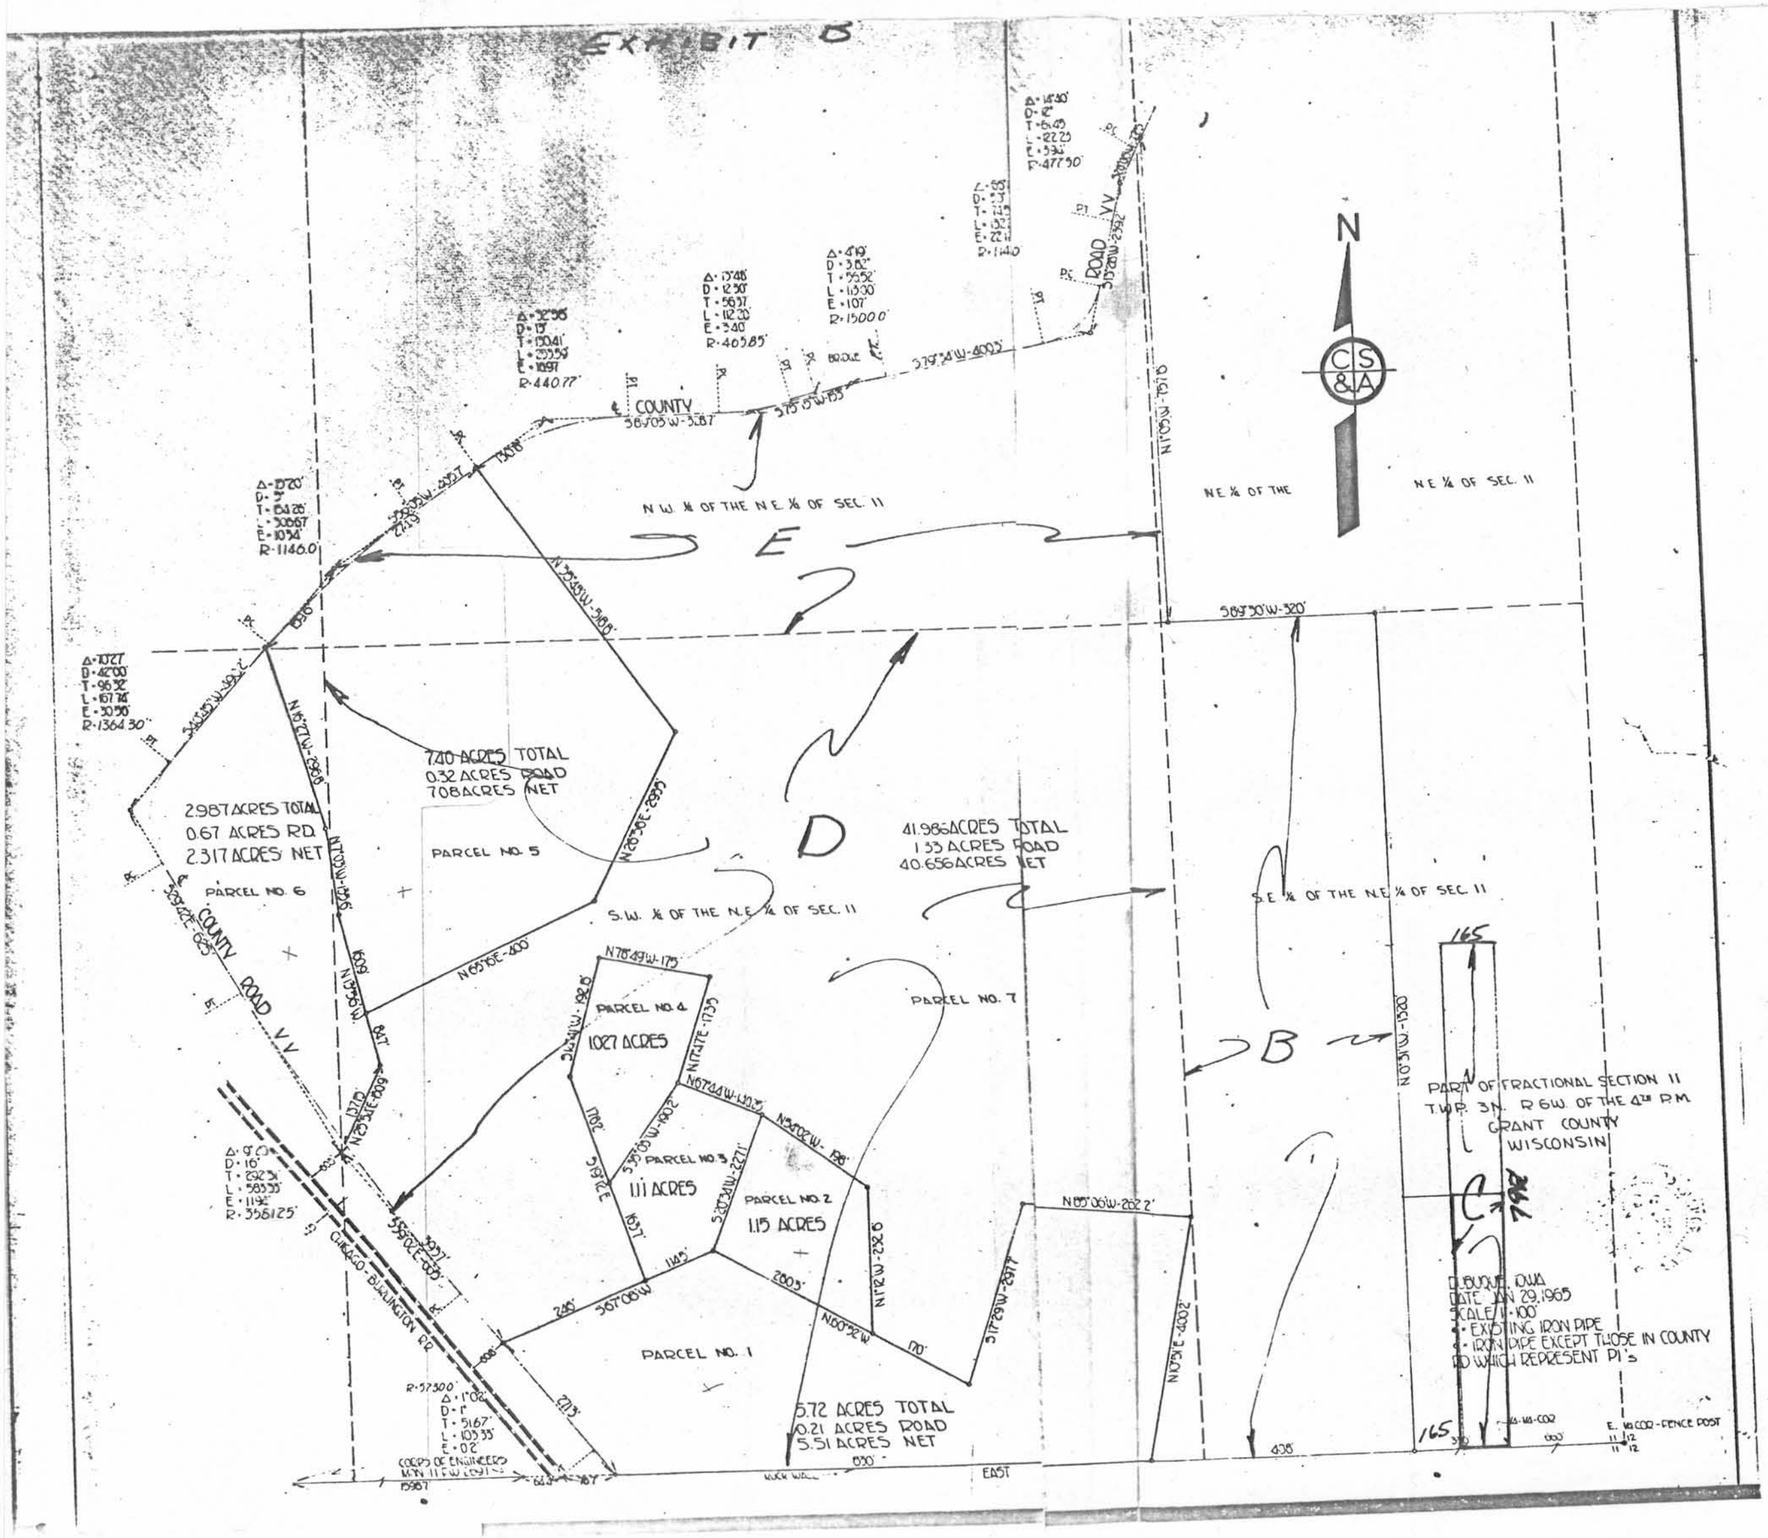
N
CS &A
N.W. ¼ OF THE N.E. ¼ OF SEC. 11
N.E. ¼ OF THE
N.E. ¼ OF SEC. 11
S.W. ¼ OF THE N.E. ¼ OF SEC. 11
S.E. ¼ OF THE N.E. ¼ OF SEC. 11
COUNTY ROAD V.V.
CHICAGO-BURLINGTON & QR
7.40 ACRES TOTAL
0.32 ACRES ROAD
7.08 ACRES NET
2.987 ACRES TOTAL
0.67 ACRES RD.
2.317 ACRES NET
PARCEL NO. 6
PARCEL NO. 5
41.986 ACRES TOTAL
1.33 ACRES ROAD
40.656 ACRES NET
PARCEL NO. 7
PARCEL NO. 4
1.027 ACRES
PARCEL NO. 3
1.11 ACRES
PARCEL NO. 2
1.15 ACRES
PARCEL NO. 1
5.72 ACRES TOTAL
0.21 ACRES ROAD
5.51 ACRES NET
PART OF FRACTIONAL SECTION 11
T.W.P. 3N. R 6W. OF THE 4TH P.M.
GRANT COUNTY
WISCONSIN
DUBUQUE, IOWA
DATE JAN 29, 1965
SCALE 1" = 100'
• EXISTING IRON PIPE
• IRON PIPE EXCEPT THOSE IN COUNTY RD WHICH REPRESENT PI's
EAST
A
B
C
D
E