August 20, 1985

Roger James Property Survey
North Lancaster Twp.
Grant County, Wis.

Commencing at the Center of Sec. 34, T5N, R3W of the 4th P.M., Grant County, Wisconsin; thence East 419.80 ft. to the northeasterly right-of-way line of C.T. Hwy. "K" and the point of beginning; thence N. 48°23' W. 202.82 ft. along the northeasterly right-of-way line of C.T. Hwy. "K"; thence N. 48°40' E. 56.23 ft.; thence N. 04°52' W. 212.52 ft.; thence N. 04°41' W. 601.03 ft.; thence S. 89°59' E. 287.01 ft.; thence S. 16°46' W. 628.11 ft.; thence S. 26°16' E. 152.49 ft.; thence S. 89°54' E. 102.47 ft.; thence S. 02°03' W. 180.59 ft.; thence S. 33°15' W. 76.12 ft. to the South line of the S.W. 1/4 of the N.E. 1/4 of Sec. 34, T5N, R3W of the 4th P.M.; thence West 51.04 ft. along the 1/4 Sec. line to the point of beginning, containing 3.67 acres, more or less, said described tract being located in the S.W. 1/4 of the N.E. 1/4 of Sec. 34, T5N, R3W of the 4th P.M.

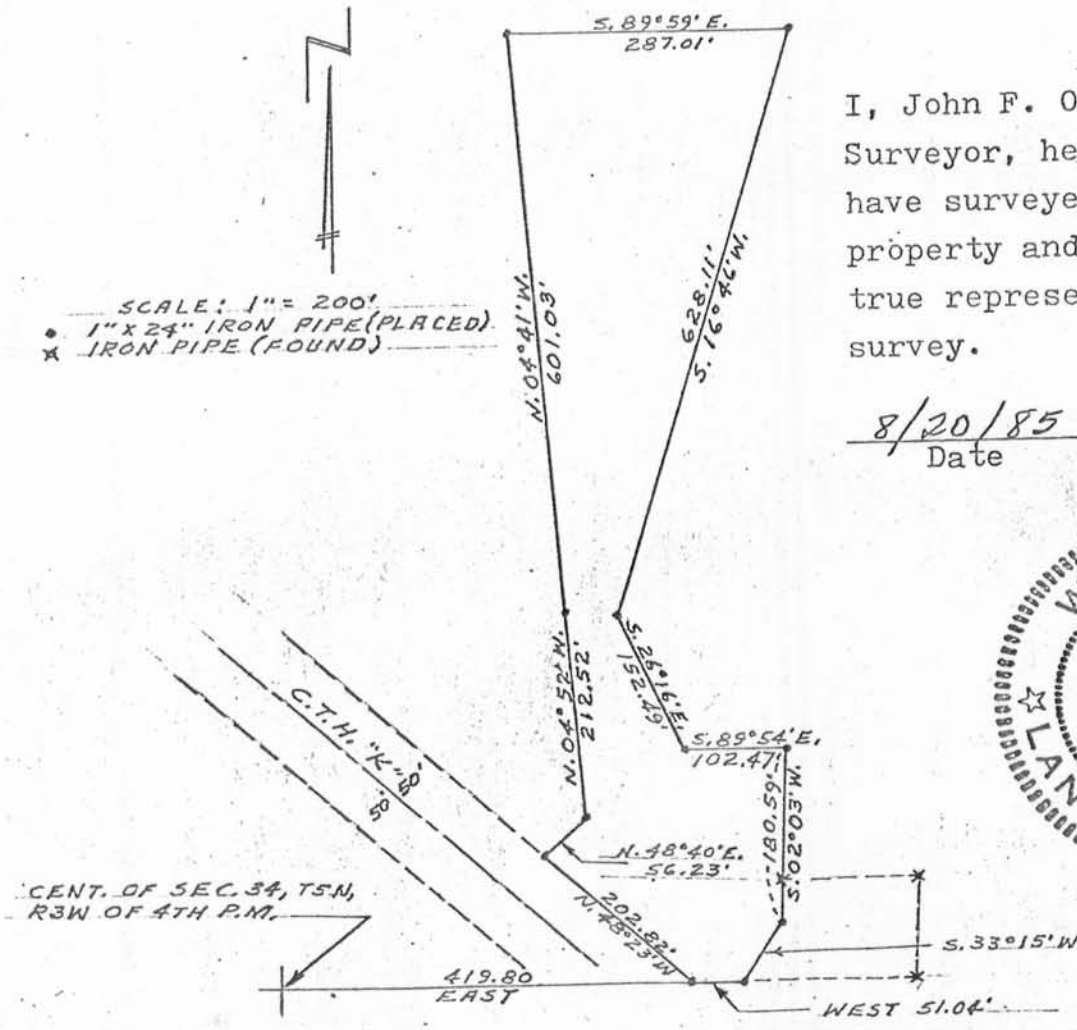

I, John F. Orth, Registered Land Surveyor, hereby certify that I have surveyed the above described property and the plat shown is a true representation of such survey.

8/20/85
Date

John F. Orth
John F. Orth RLS-340

WISCONSIN
JOHN F. ORTH
S-340
PLATTEVILLE, WIS.
LAND SURVEYOR