SURVEY FOR SAND BAR MOTEL - CASSVILLE, WISC.

Home: Thank you for your office's help on this survey!
LCW

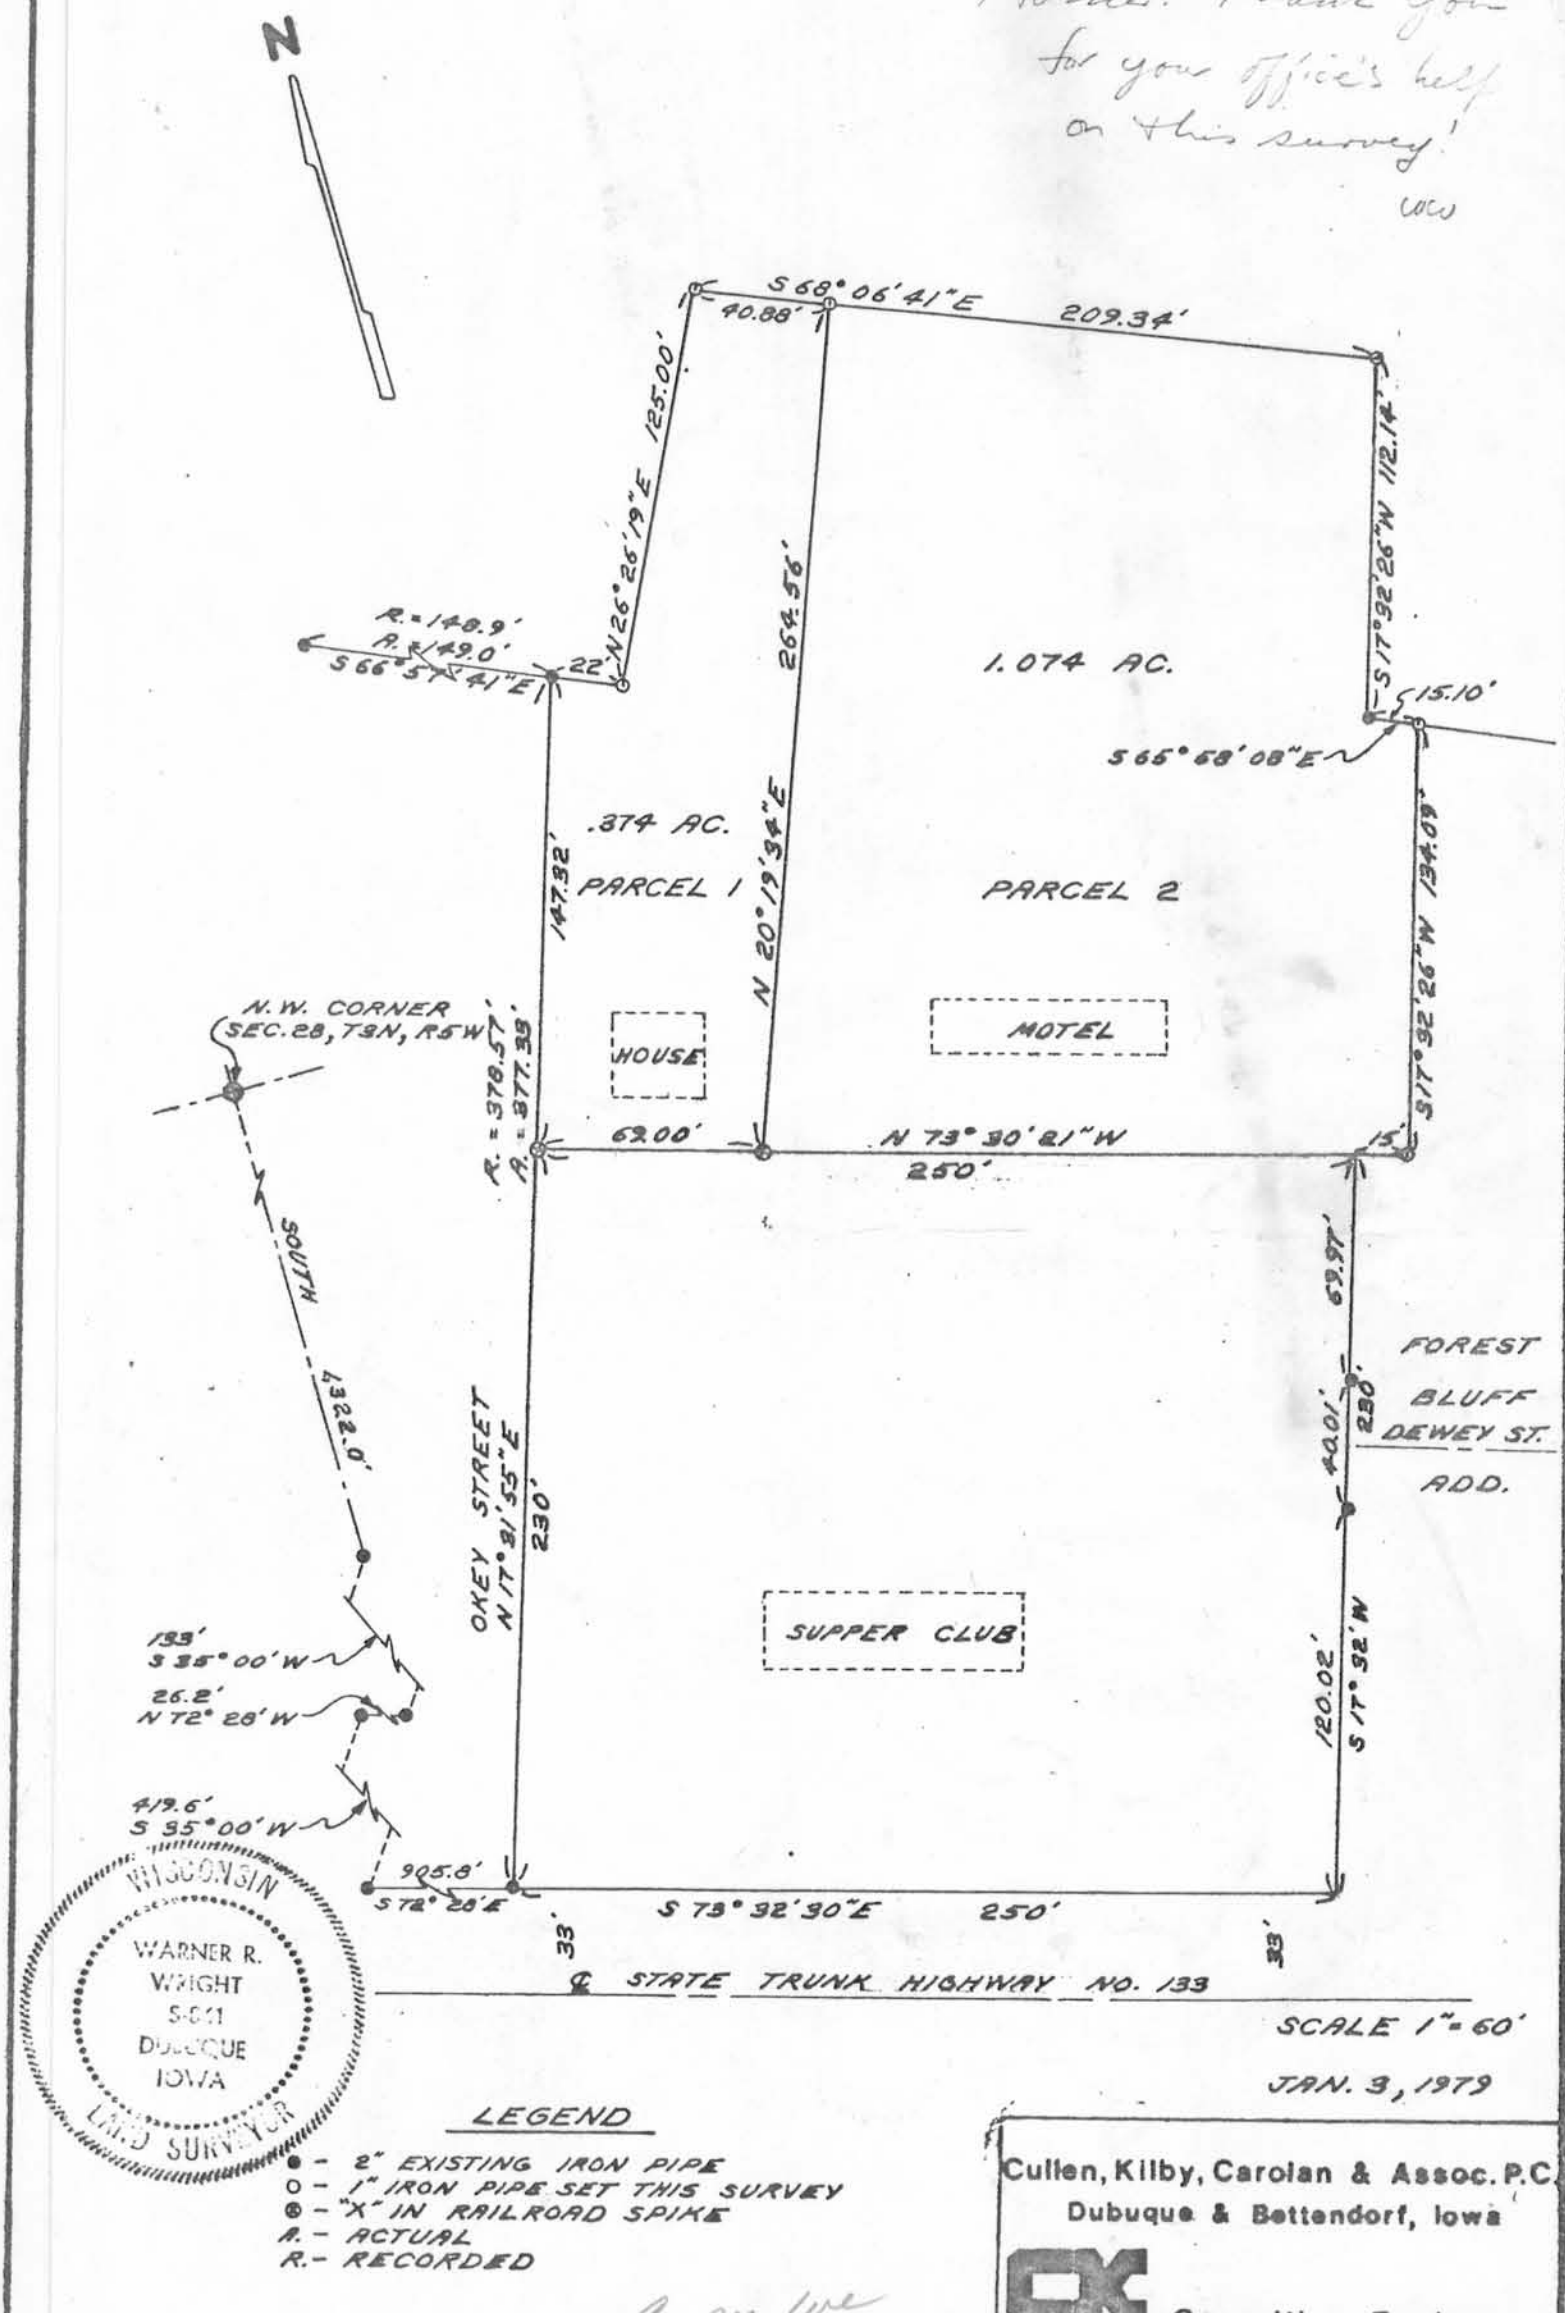

SCALE 1" = 60'

JAN. 3, 1979

LEGEND

- ● - 2" EXISTING IRON PIPE
- o - 1" IRON PIPE SET THIS SURVEY
- ⊗ - "X" IN RAILROAD SPIKE
- A. - ACTUAL
- R. - RECORDED

Copy we had in our files

Cullen, Kilby, Carolan & Assoc. P.C.
Dubuque & Bettendorf, Iowa
Consulting Engineers