PLAT OF SURVEY

ANTHONY THOUSAND
LAND SURVEYOR

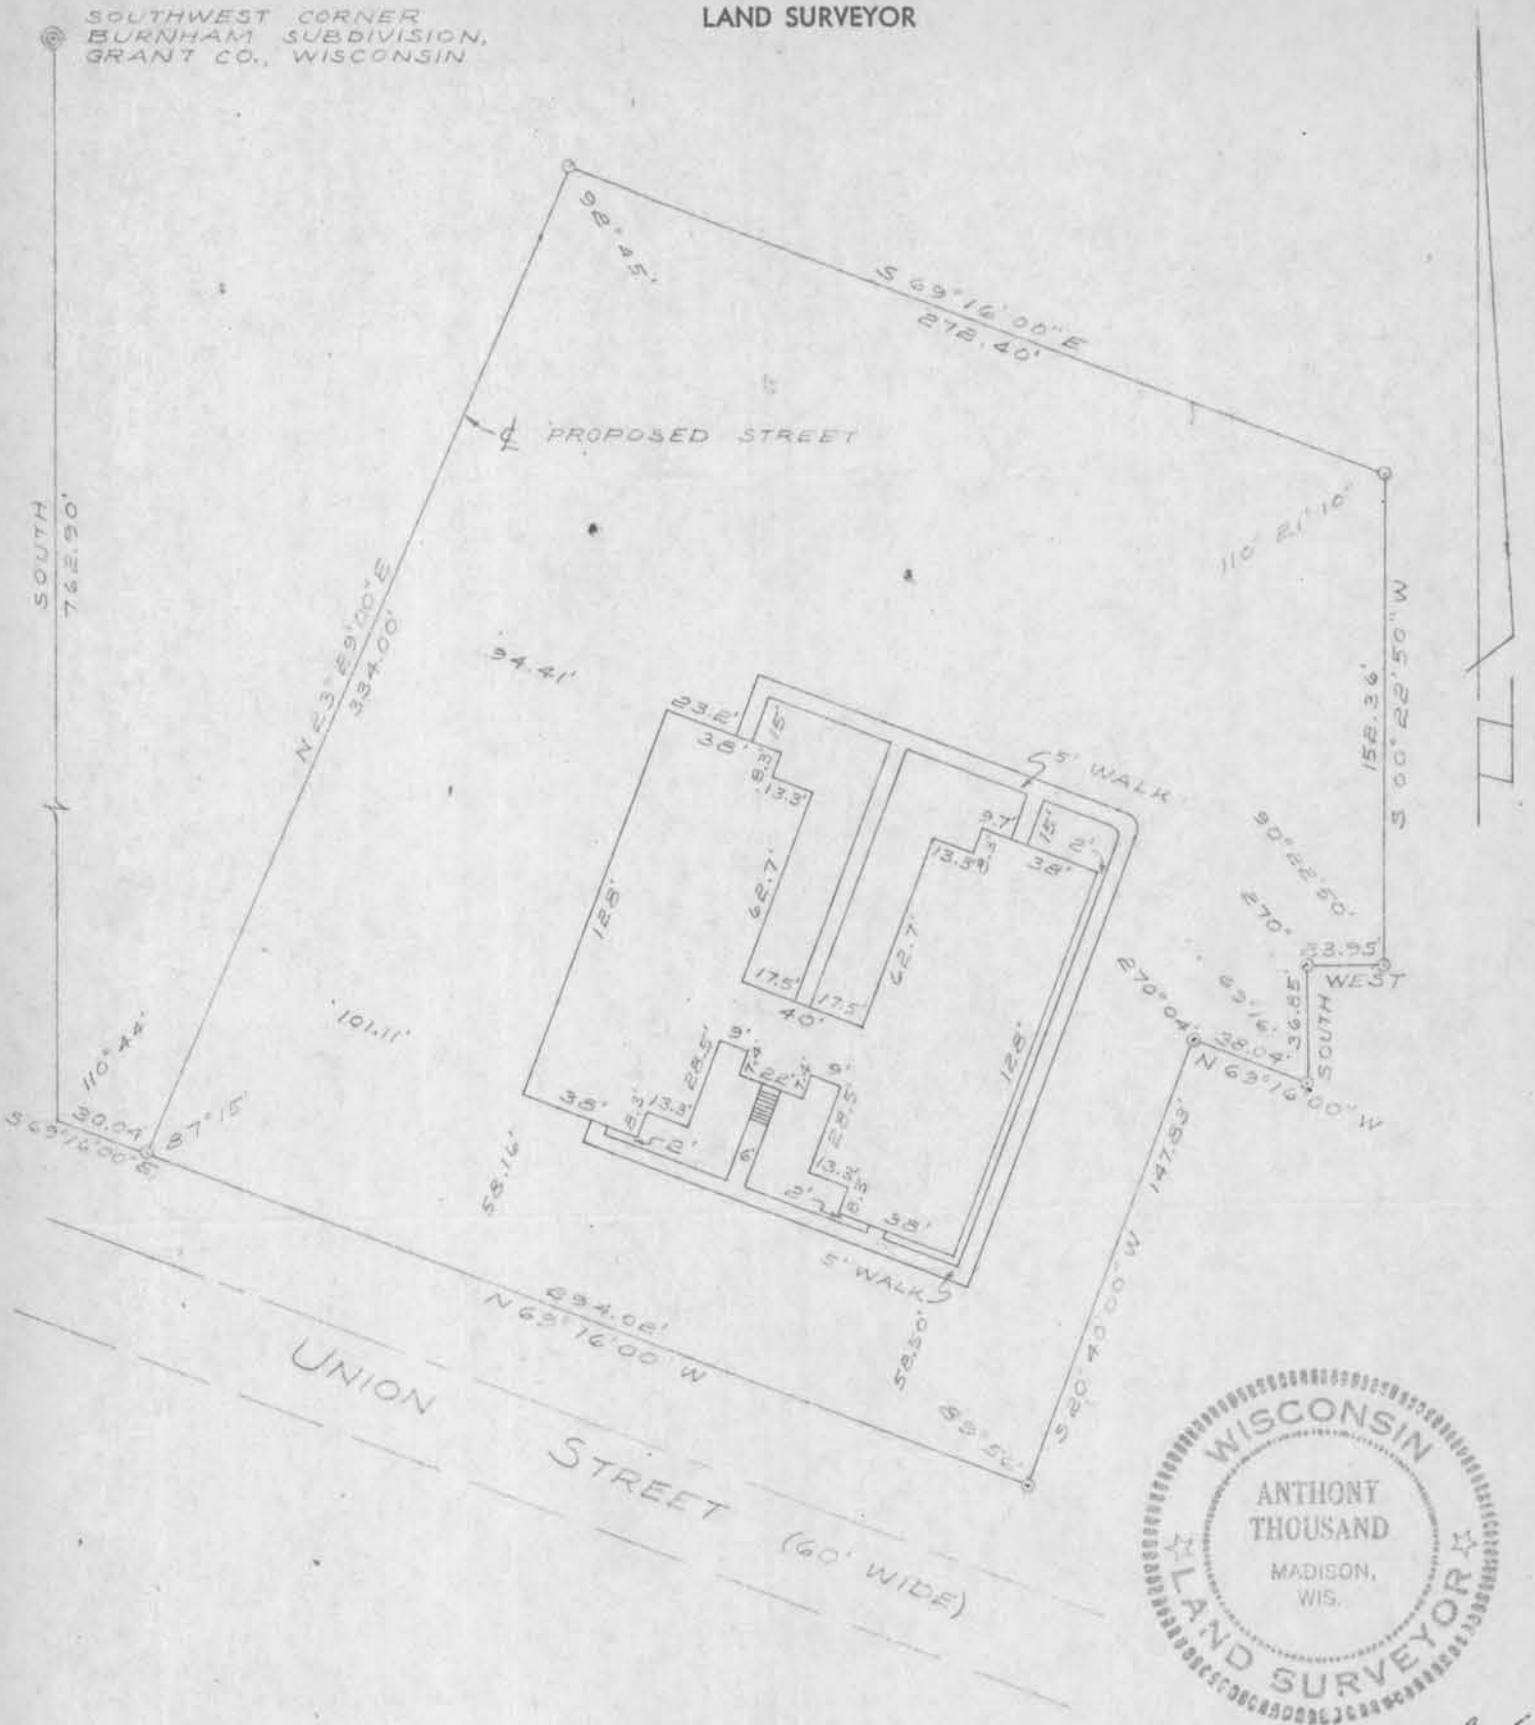

WISCONSIN
ANTHONY THOUSAND
MADISON, WIS.
LAND SURVEYOR

being part of Lots 2 and 3 in Block 61 in assessment Plat of the City of Platteville and

A PARCEL OF LAND LOCATED IN THE ~~SE1/4 OF SECTION 9, T3N, R1W,~~ AND THE NE1/4 OF SECTION 16, T3N, R1W, CITY OF PLATTEVILLE, GRANT COUNTY, WISCONSIN, TO-WIT:

COMMENCING AT THE SOUTHWEST CORNER OF BURNHAM SUBDIVISION, GRANT COUNTY, WISCONSIN; THENCE SOUTH, 762.90 FEET; THENCE S69°16'E, 30.04 FEET TO THE POINT OF BEGINNING; THENCE N23°29'E, 334.00 FEET; THENCE S69°16'E, 272.40 FEET; THENCE S00°22'50"W, 152.36 FEET; THENCE WEST, 23.95 FEET; THENCE SOUTH, 36.85 FEET; THENCE N69°16'W, 38.04 FEET; THENCE S20°40'W, 147.83 FEET; THENCE N69°16'W, 294.02 FEET TO THE POINT OF BEGINNING.

TOWNE REALTY

I HEREBY CERTIFY THAT I HAVE MADE A SURVEY ACCORDING TO THE DESCRIPTION FURNISHED TO ME AND THAT THE PLAT DRAWN ABOVE IS A TRUE REPRESENTATION OF THAT SURVEY.

Anthony Thousand

ANTHONY THOUSAND — MADISON, WISCONSIN

SCALE: 1" = 60'

DATE 8-20-69

● IRON STAKE FOUND
○ IRON STAKE PLACED

NO. 4-4927