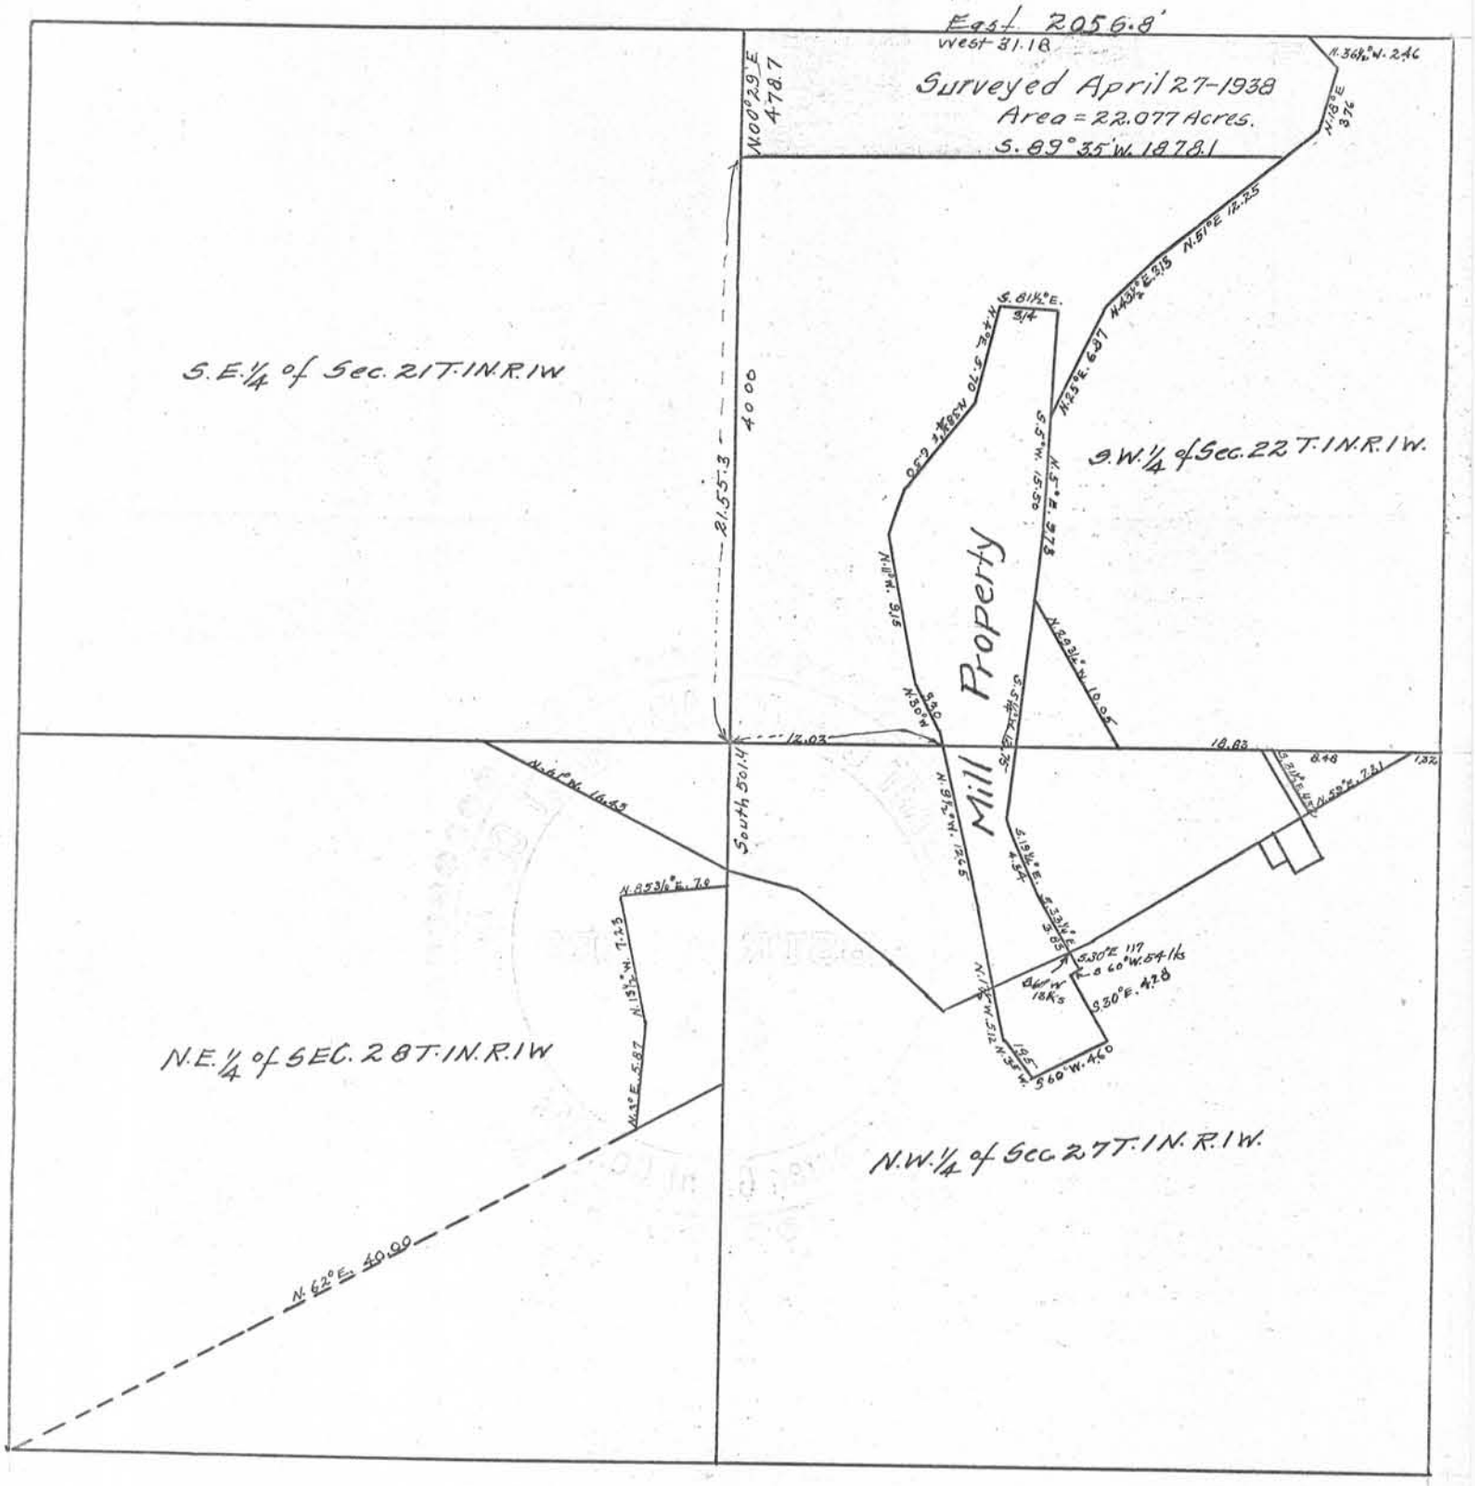

Plat showing the location of the land Abstracted- Shaded Green