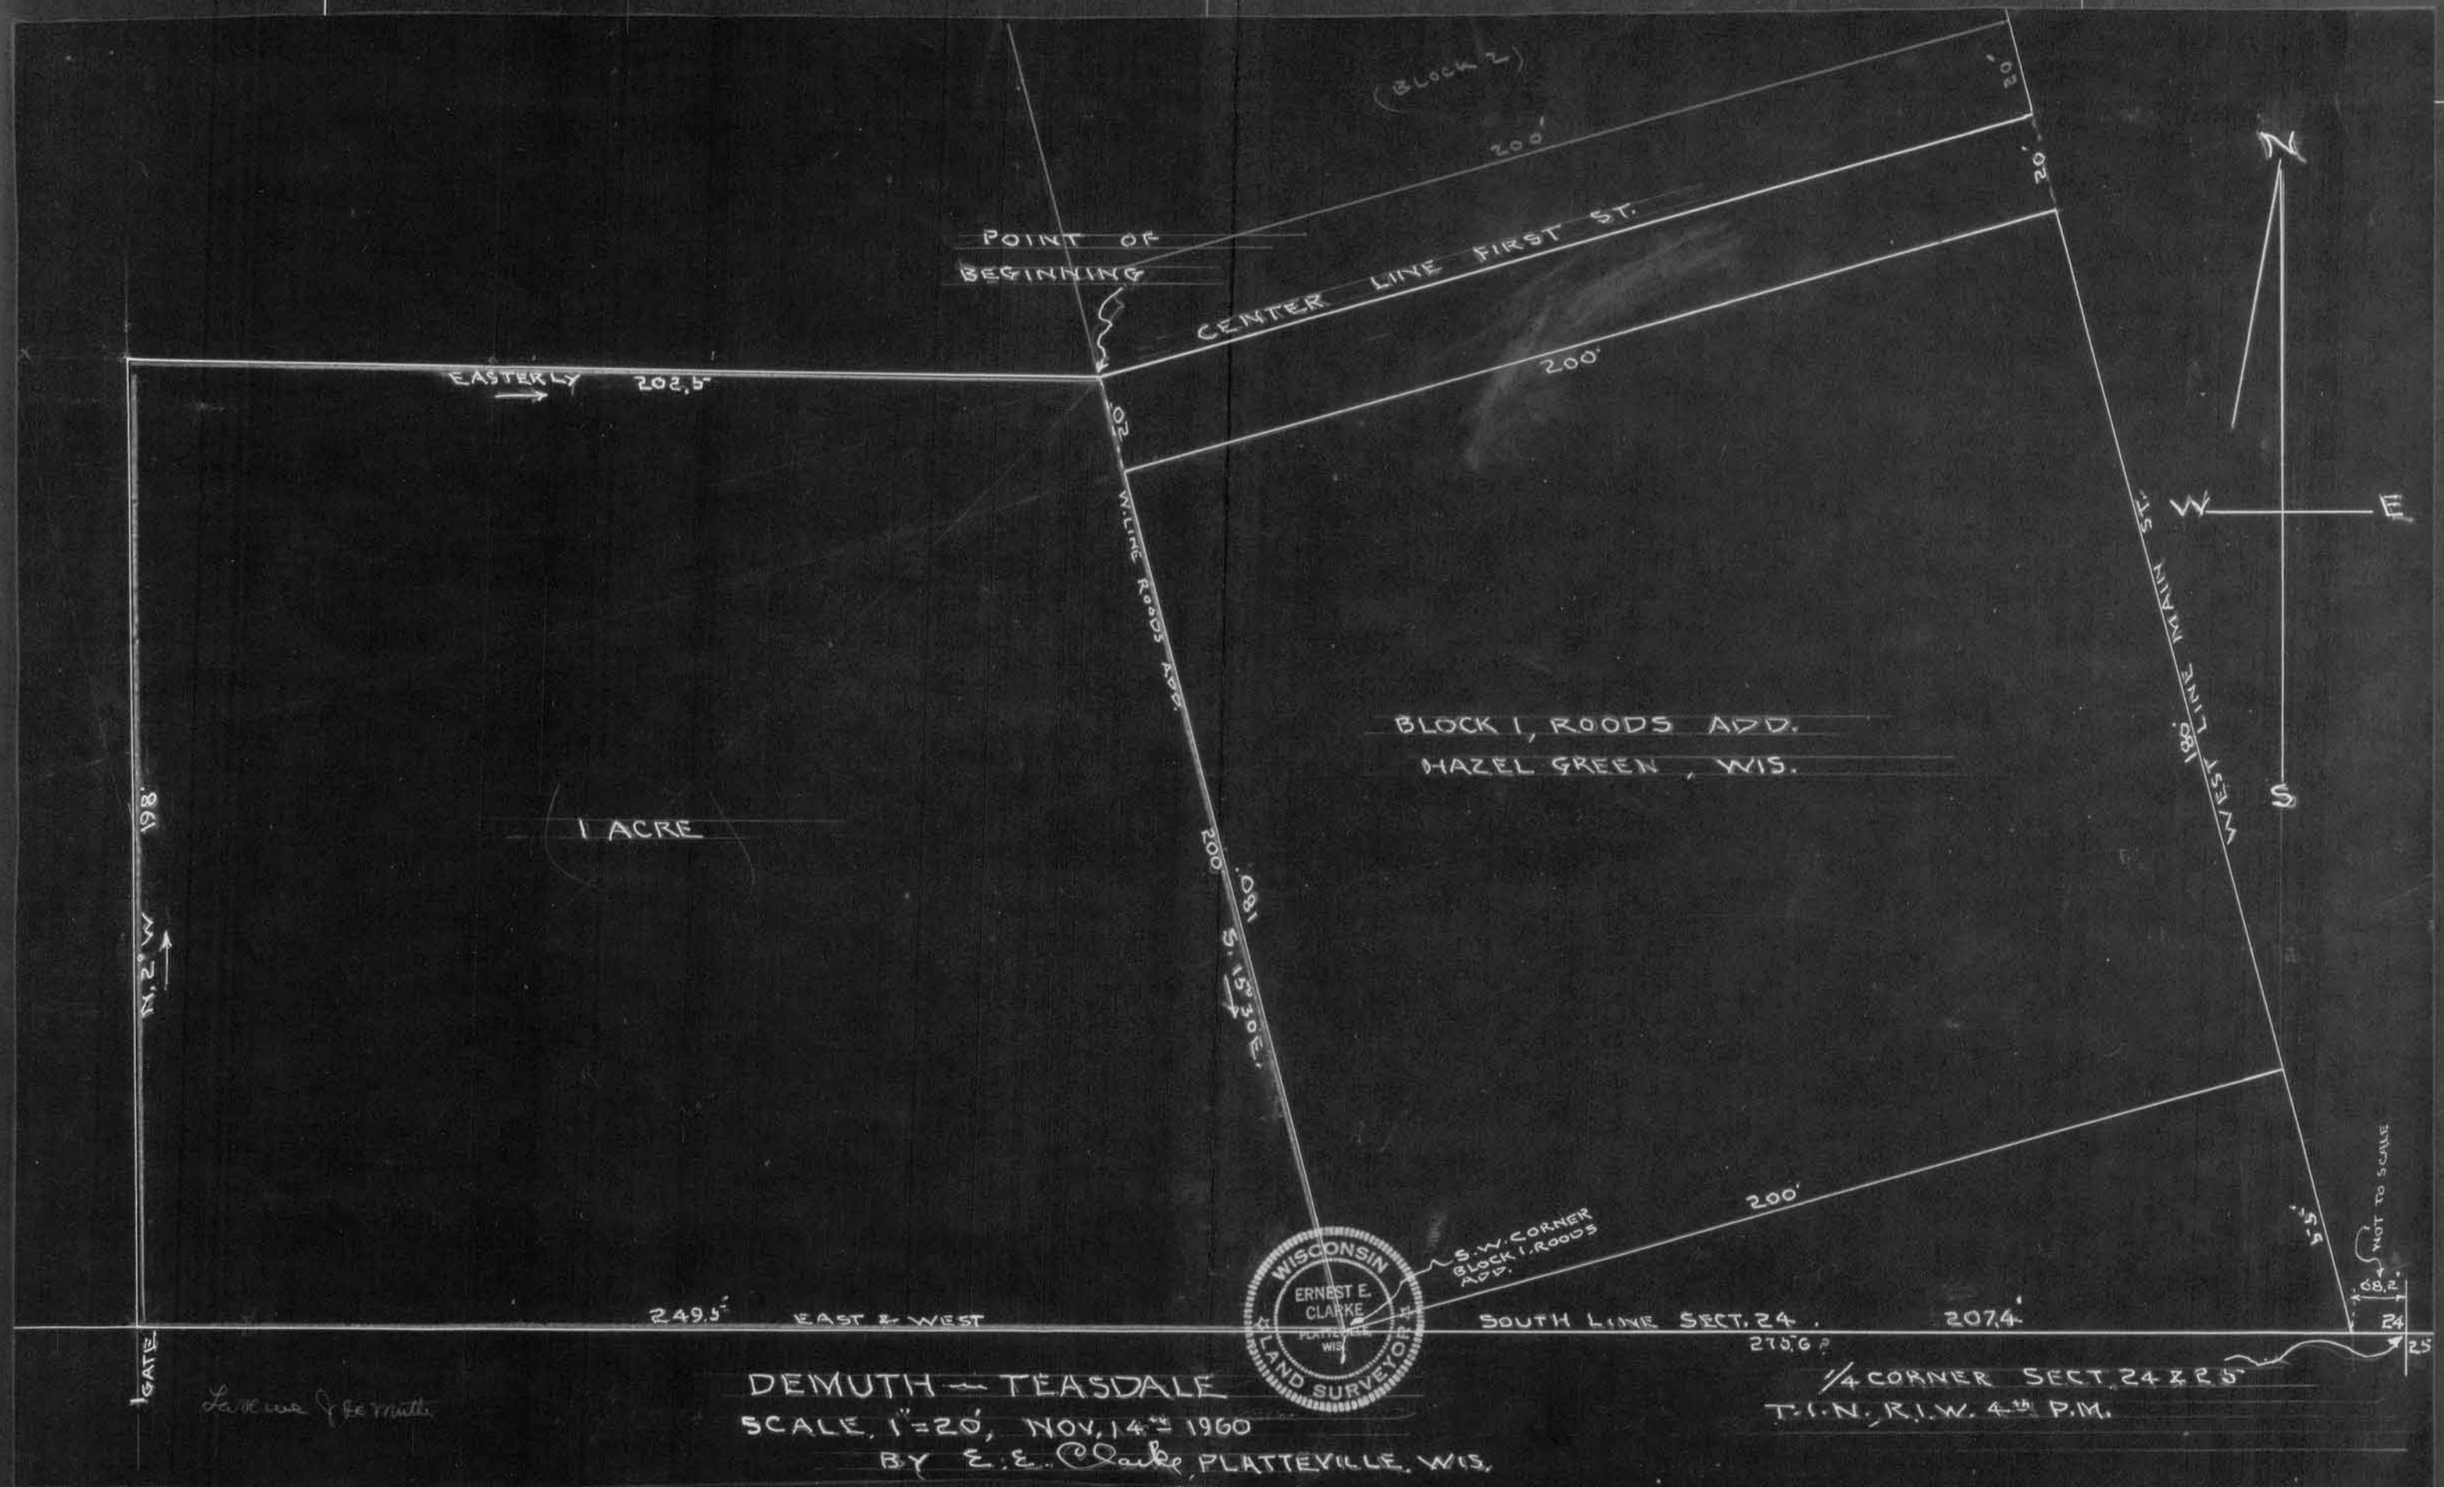

DEMUTH — TEASDALE
SCALE, 1" = 20', NOV. 14th 1960
BY E. E. Clarke, PLATTEVILLE, WIS.