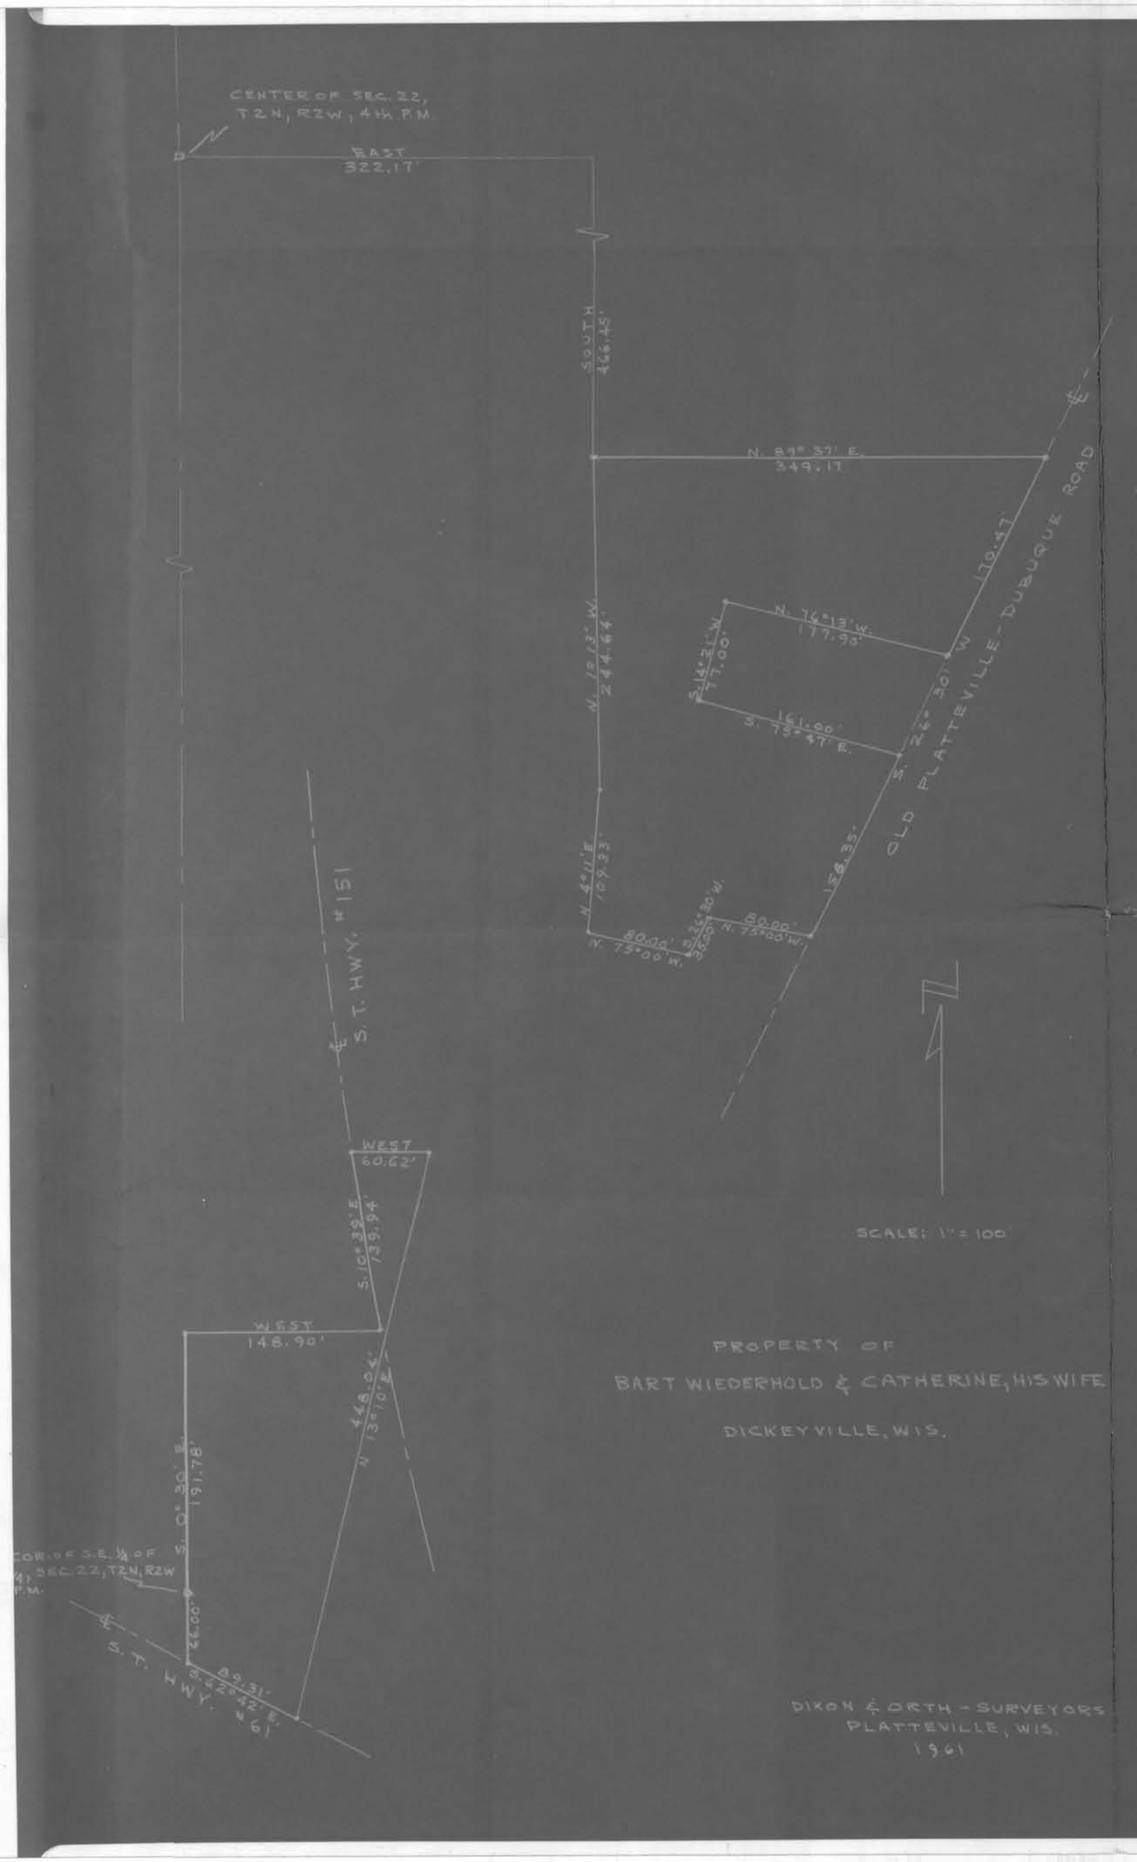

DESCRIPTION OF PROPERTY OF

BART WIEDERHOLD & CATHERINE, HIS WIFE

(1) COMMENCING AT THE N.E. CORNER OF THE S.E. ¼ OF THE S.W. ¼ OF SEC. 22, T2N, R2W, 4th P.M., VILLAGE OF DICKEYVILLE, GRANT COUNTY, WISCONSIN, THENCE S. 0° 30' E. ALONG THE NORTH AND SOUTH QUARTER SECTION LINE OF SEC. 22 66.00' TO THE CENTERLINE OF S.T. HWY. #61, THENCE S. 62° 42' E. ALONG SAID CENTERLINE 89.31', THENCE N. 13° 10' E. 448.04', THENCE WEST 60.62' TO THE CENTERLINE OF S.T. HWY. #151, THENCE S. 10° 39' E. ALONG THE CENTERLINE OF S.T. HWY. #151 139.94', THENCE WEST 148.90' TO THE NORTH AND SOUTH QUARTER SECTION LINE OF SEC. 22, THENCE S. 0° 30' E. ALONG SAID QUARTER SECTION LINE 191. 78' TO THE POINT OF BEGINNING,

(2) ALSO A PARCEL OF LAND DESCRIBED AS

COMMENCING AT A POINT WHICH IS 322.17' EAST AND 466.45' SOUTH OF THE CENTER OF SECTION 22, T2N, R2W, 4th P.M.,VILLAGE OF DICKEYVILLE, GRANT COUNTY, WISCONSIN, THENCE N. 89° 37' E. 349.17' TO THE CENTER-LINE OF THE OLD PLATTEVILLE-DUBUQUE ROAD, THENCE S. 26° 30' W. 170.47' ALONG THE CENTERLINE OF SAID ROAD, THENCE N. 76° 13' W. 177.90', THENCE S. 14° 21' W. 77.00', THENCE S. 75° 47' E. 161.00', THENCE S. 26° 30' W. ALONG THE CENTERLINE OF SAID ROAD 158.35', THENCE N. 75° 00' W. 80.00', THENCE S. 26° 30' W. 35.00', THENCE N. 75° 00' W. 80.00', THENCE N. 4° 11' E. 109.33', THENCE N. 1° 13' W. 244.64' TO THE POINT OF BEGINNING.

D.C. DIXON & J.F. ORTH
REGISTERED SURVEYORS
PLATTEVILLE, WISCONSIN

AUGUST 5, 1961