DEAN R. KNETTER — SURVEY

DESCRIPTION:

PART OF LOTS 10 AND 11, BLOCK 3, OF SIEMERS ADDITION TO THE CITY OF PLATTEVILLE, GRANT COUNTY, WISCONSIN, ACCORDING TO THE RECORDED MAP OR PLAT THEREOF, DESCRIBED AS FOLLOWS TO-WIT:

BEGIN AT A 1 INCH DIAMETER IRON PIPE AT THE NORTHWEST CORNER OF SAID LOT 10; THENCE SOUTH 73°00' EAST 164.00 FEET ALONG THE NORTHERN BOUNDARIES OF SAID LOTS 10 AND 11 TO A 1 INCH DIAMETER IRON PIPE AT THE NORTHEAST CORNER OF SAID LOT 11; THENCE SOUTH 17°00' WEST 37.50 FEET ALONG THE EASTERN BOUNDARY OF SAID LOT 11, TO A 1INCH DIAMETER IRON PIPE; THENCE NORTH 77°16' WEST 164.46 FEET TO A 1 INCH DIAMETER IRON PIPE ON THE WESTERN BOUNDARY OF SAID LOT 10; THENCE NORTH 17°00' EAST 49.75 FEET ALONG THE WESTERN BOUNDARY OF SAID LOT 10 TO THE POINT OF BEGINNING.

I CERTIFY THAT I HAVE SURVEYED THE ABOVE DESCRIBED PARCEL OF LAND AND THAT THE ATTACHED OR ACCOMPANYING PLAT IS AN ACCURATE SURVEY AND TRUE REPRESENTATION THEREOF AND CORRECTLY SHOWS THE EXTERIOR BOUNDARY LINES OF SAID PARCEL AND THE CORRECT MEASUREMENTS THEREOF.

DATED THIS 21st DAY OF APRIL 1977.

David K. Krohn

DAVID K. KROHN
REG. NO. 1309
4/16/77 - 4/21/77

WISCONSIN ☆ DAVID K. KROHN S-1309 LANCASTER, WIS. ☆ LAND SURVEYOR

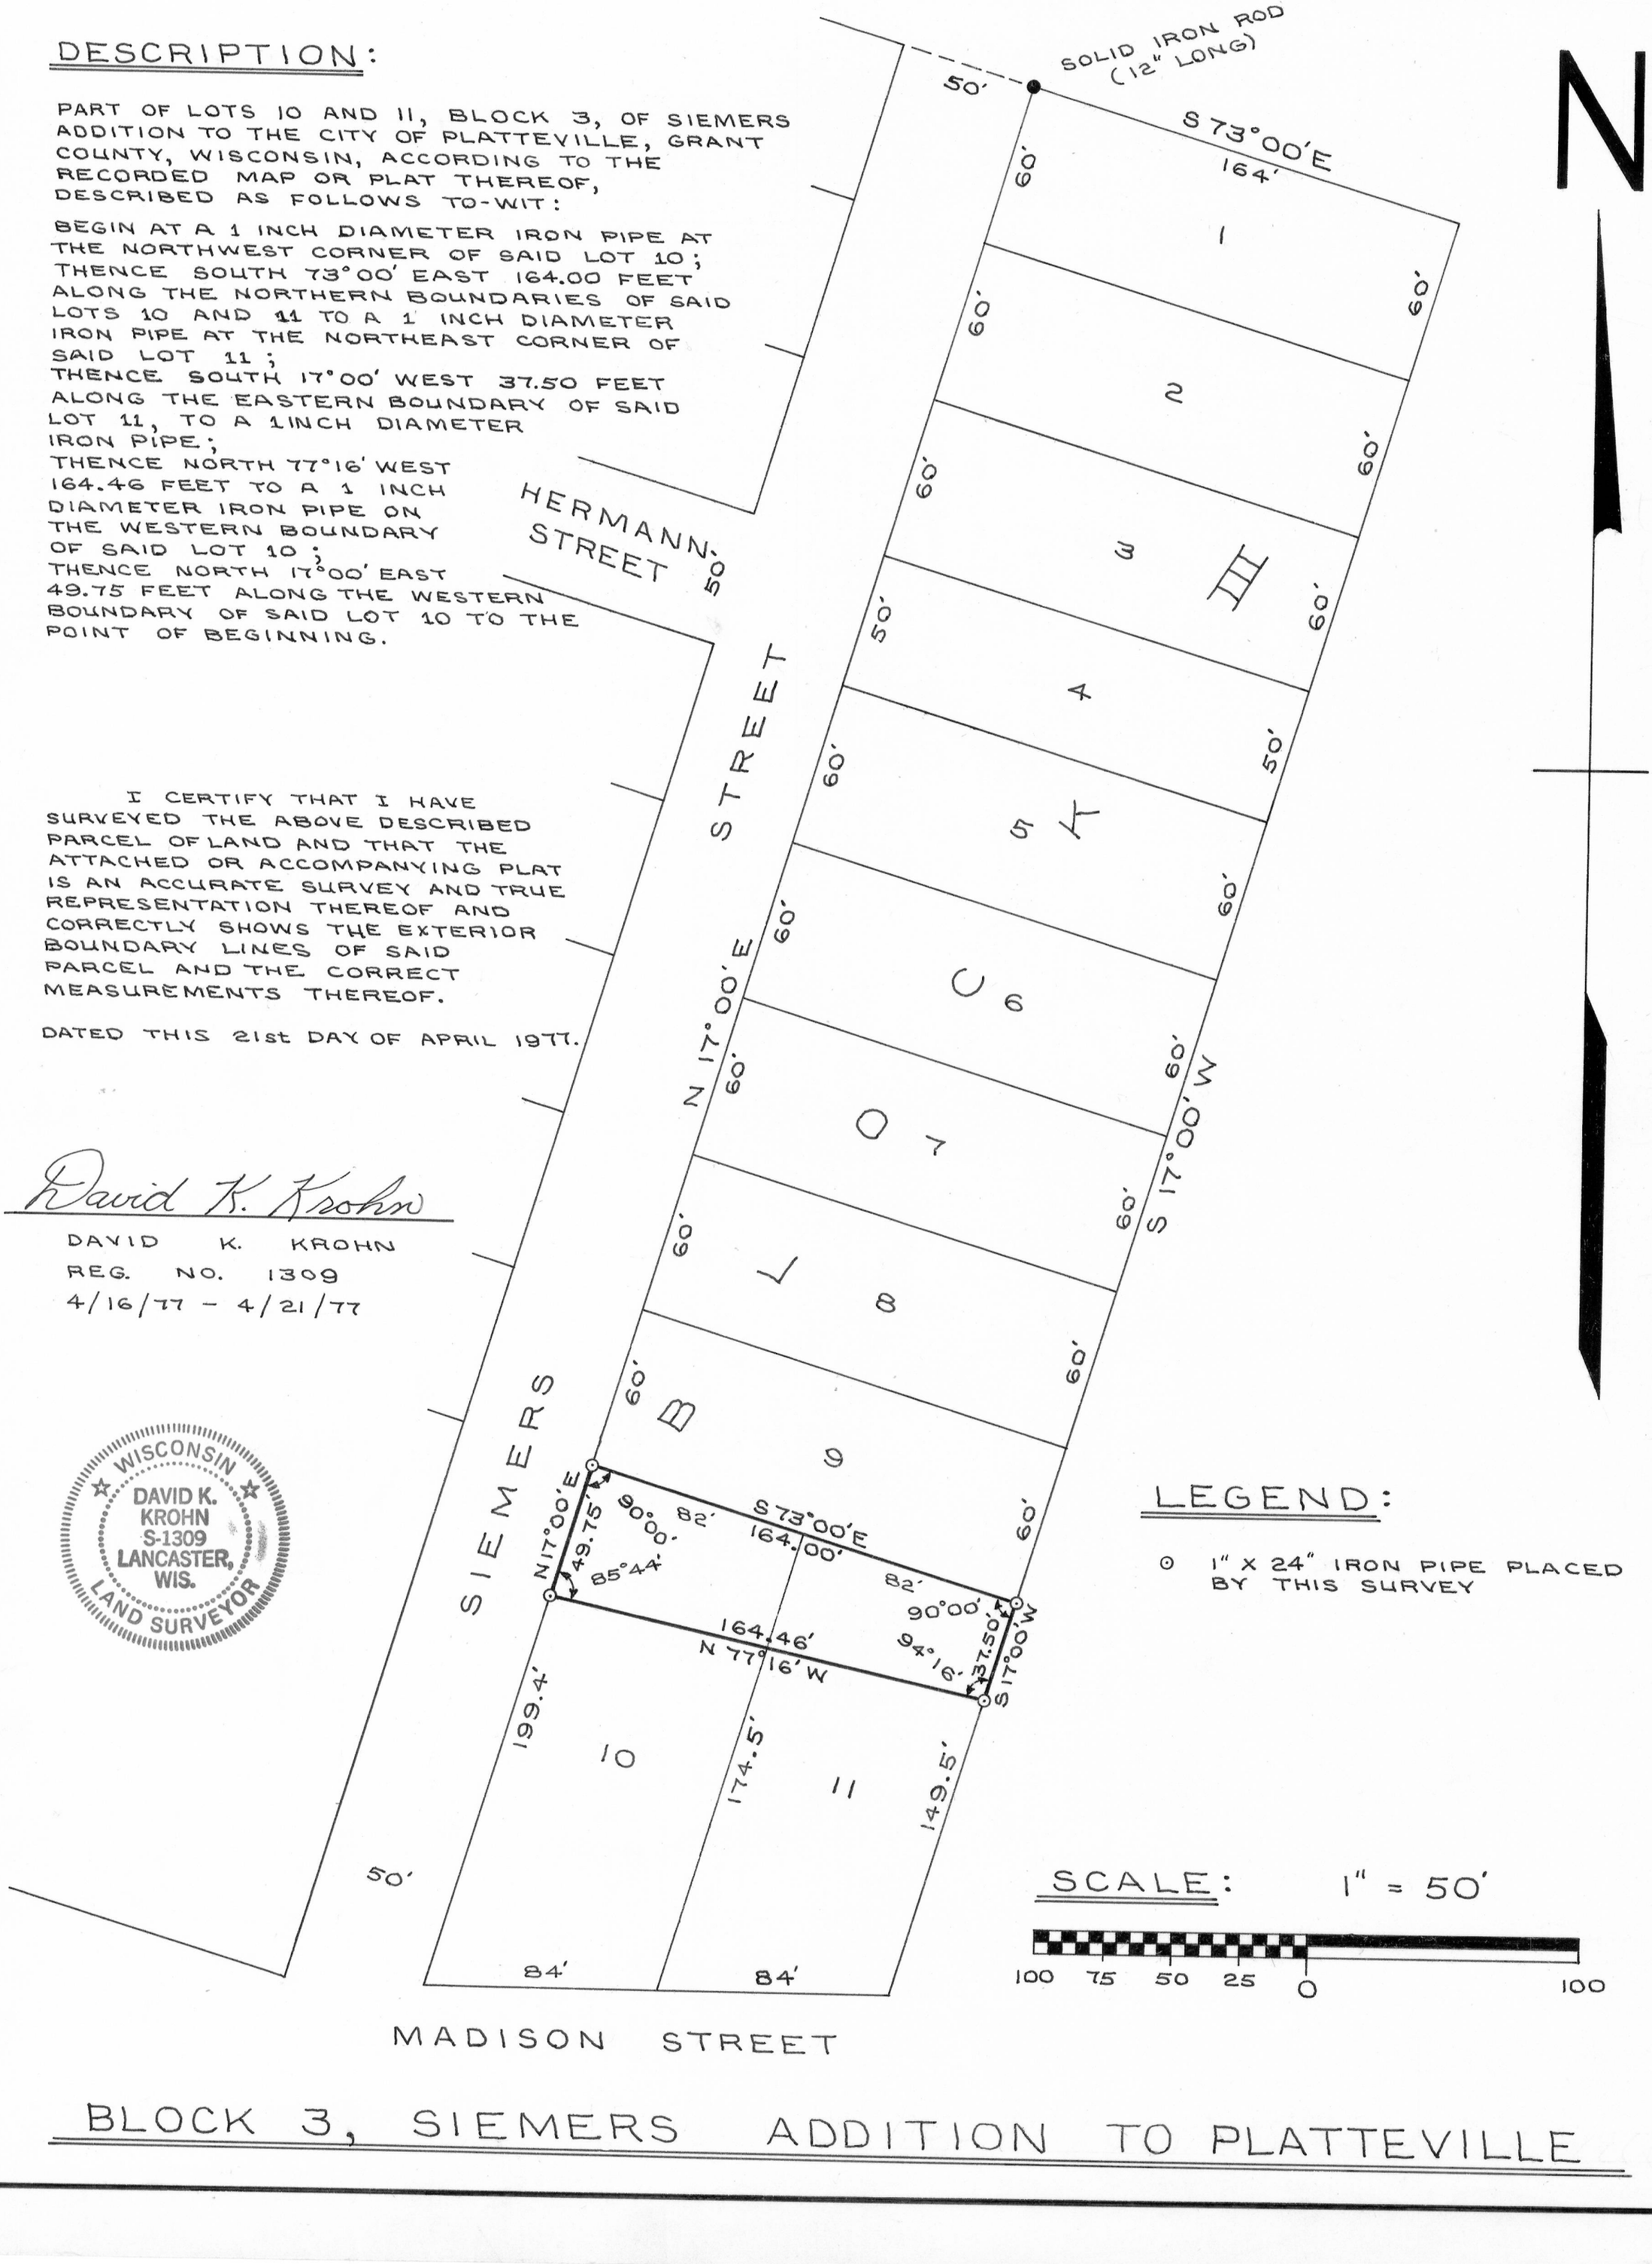

LEGEND:

⊙ 1" X 24" IRON PIPE PLACED BY THIS SURVEY

SCALE: 1" = 50'

100 75 50 25 0 100

BLOCK 3, SIEMERS ADDITION TO PLATTEVILLE

27