PLAT OF SURVEY

For: Roger Bark

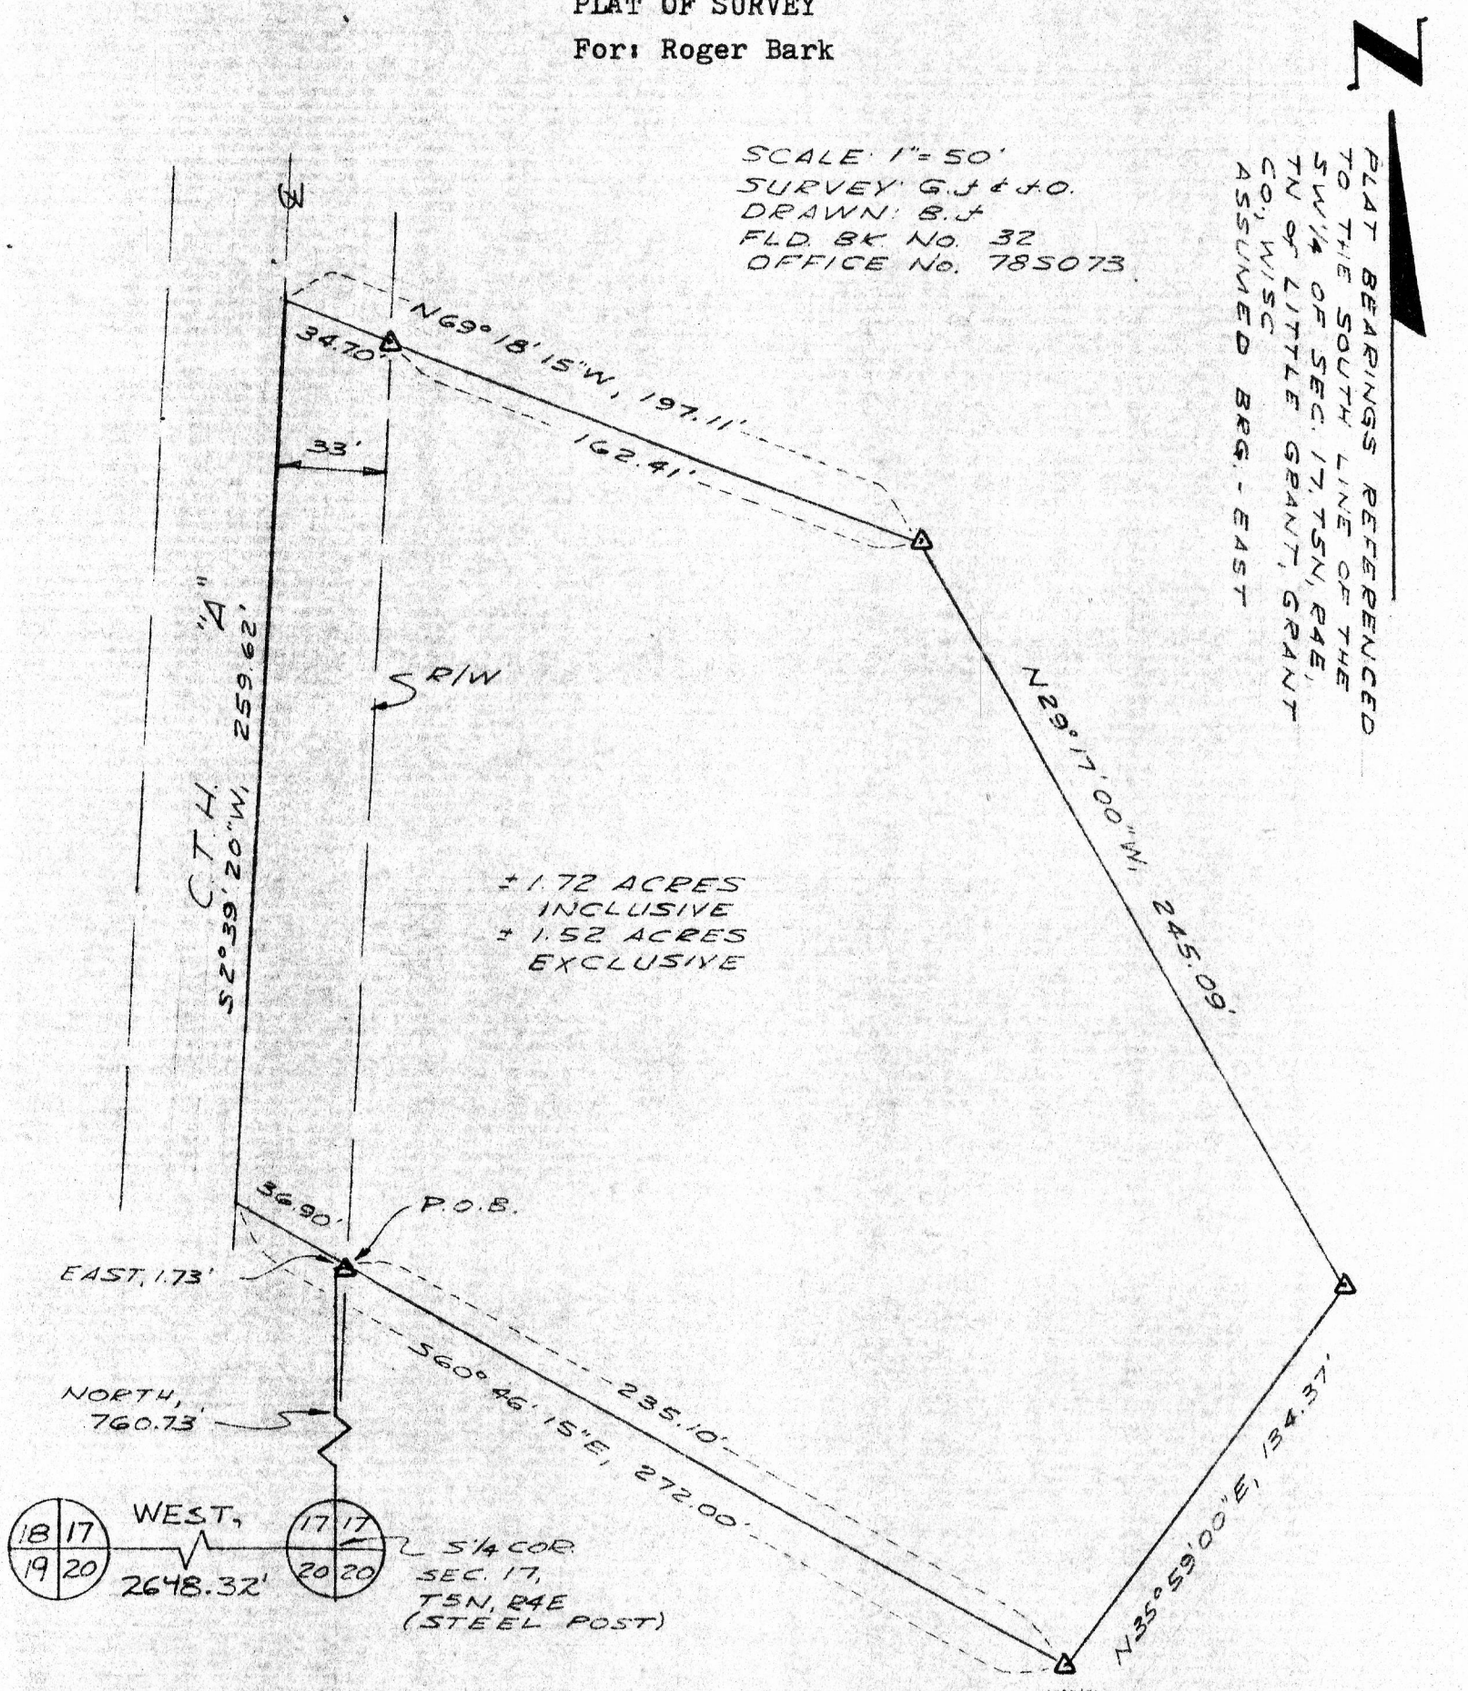

LEGEND

△ 24"x1" MIN. DIA. IRON PIPE SET 1.13 lb./lin. ft. min. wgt.

WISCONSIN
LAURENCE E. SCHMIT
S-1312
Dodgeville
Wis.
LAND SURVEYOR

Laurence E. Schmit
8-18-78

SHEET 1 of 2 SHEETS