Sec 6, T6, R3W

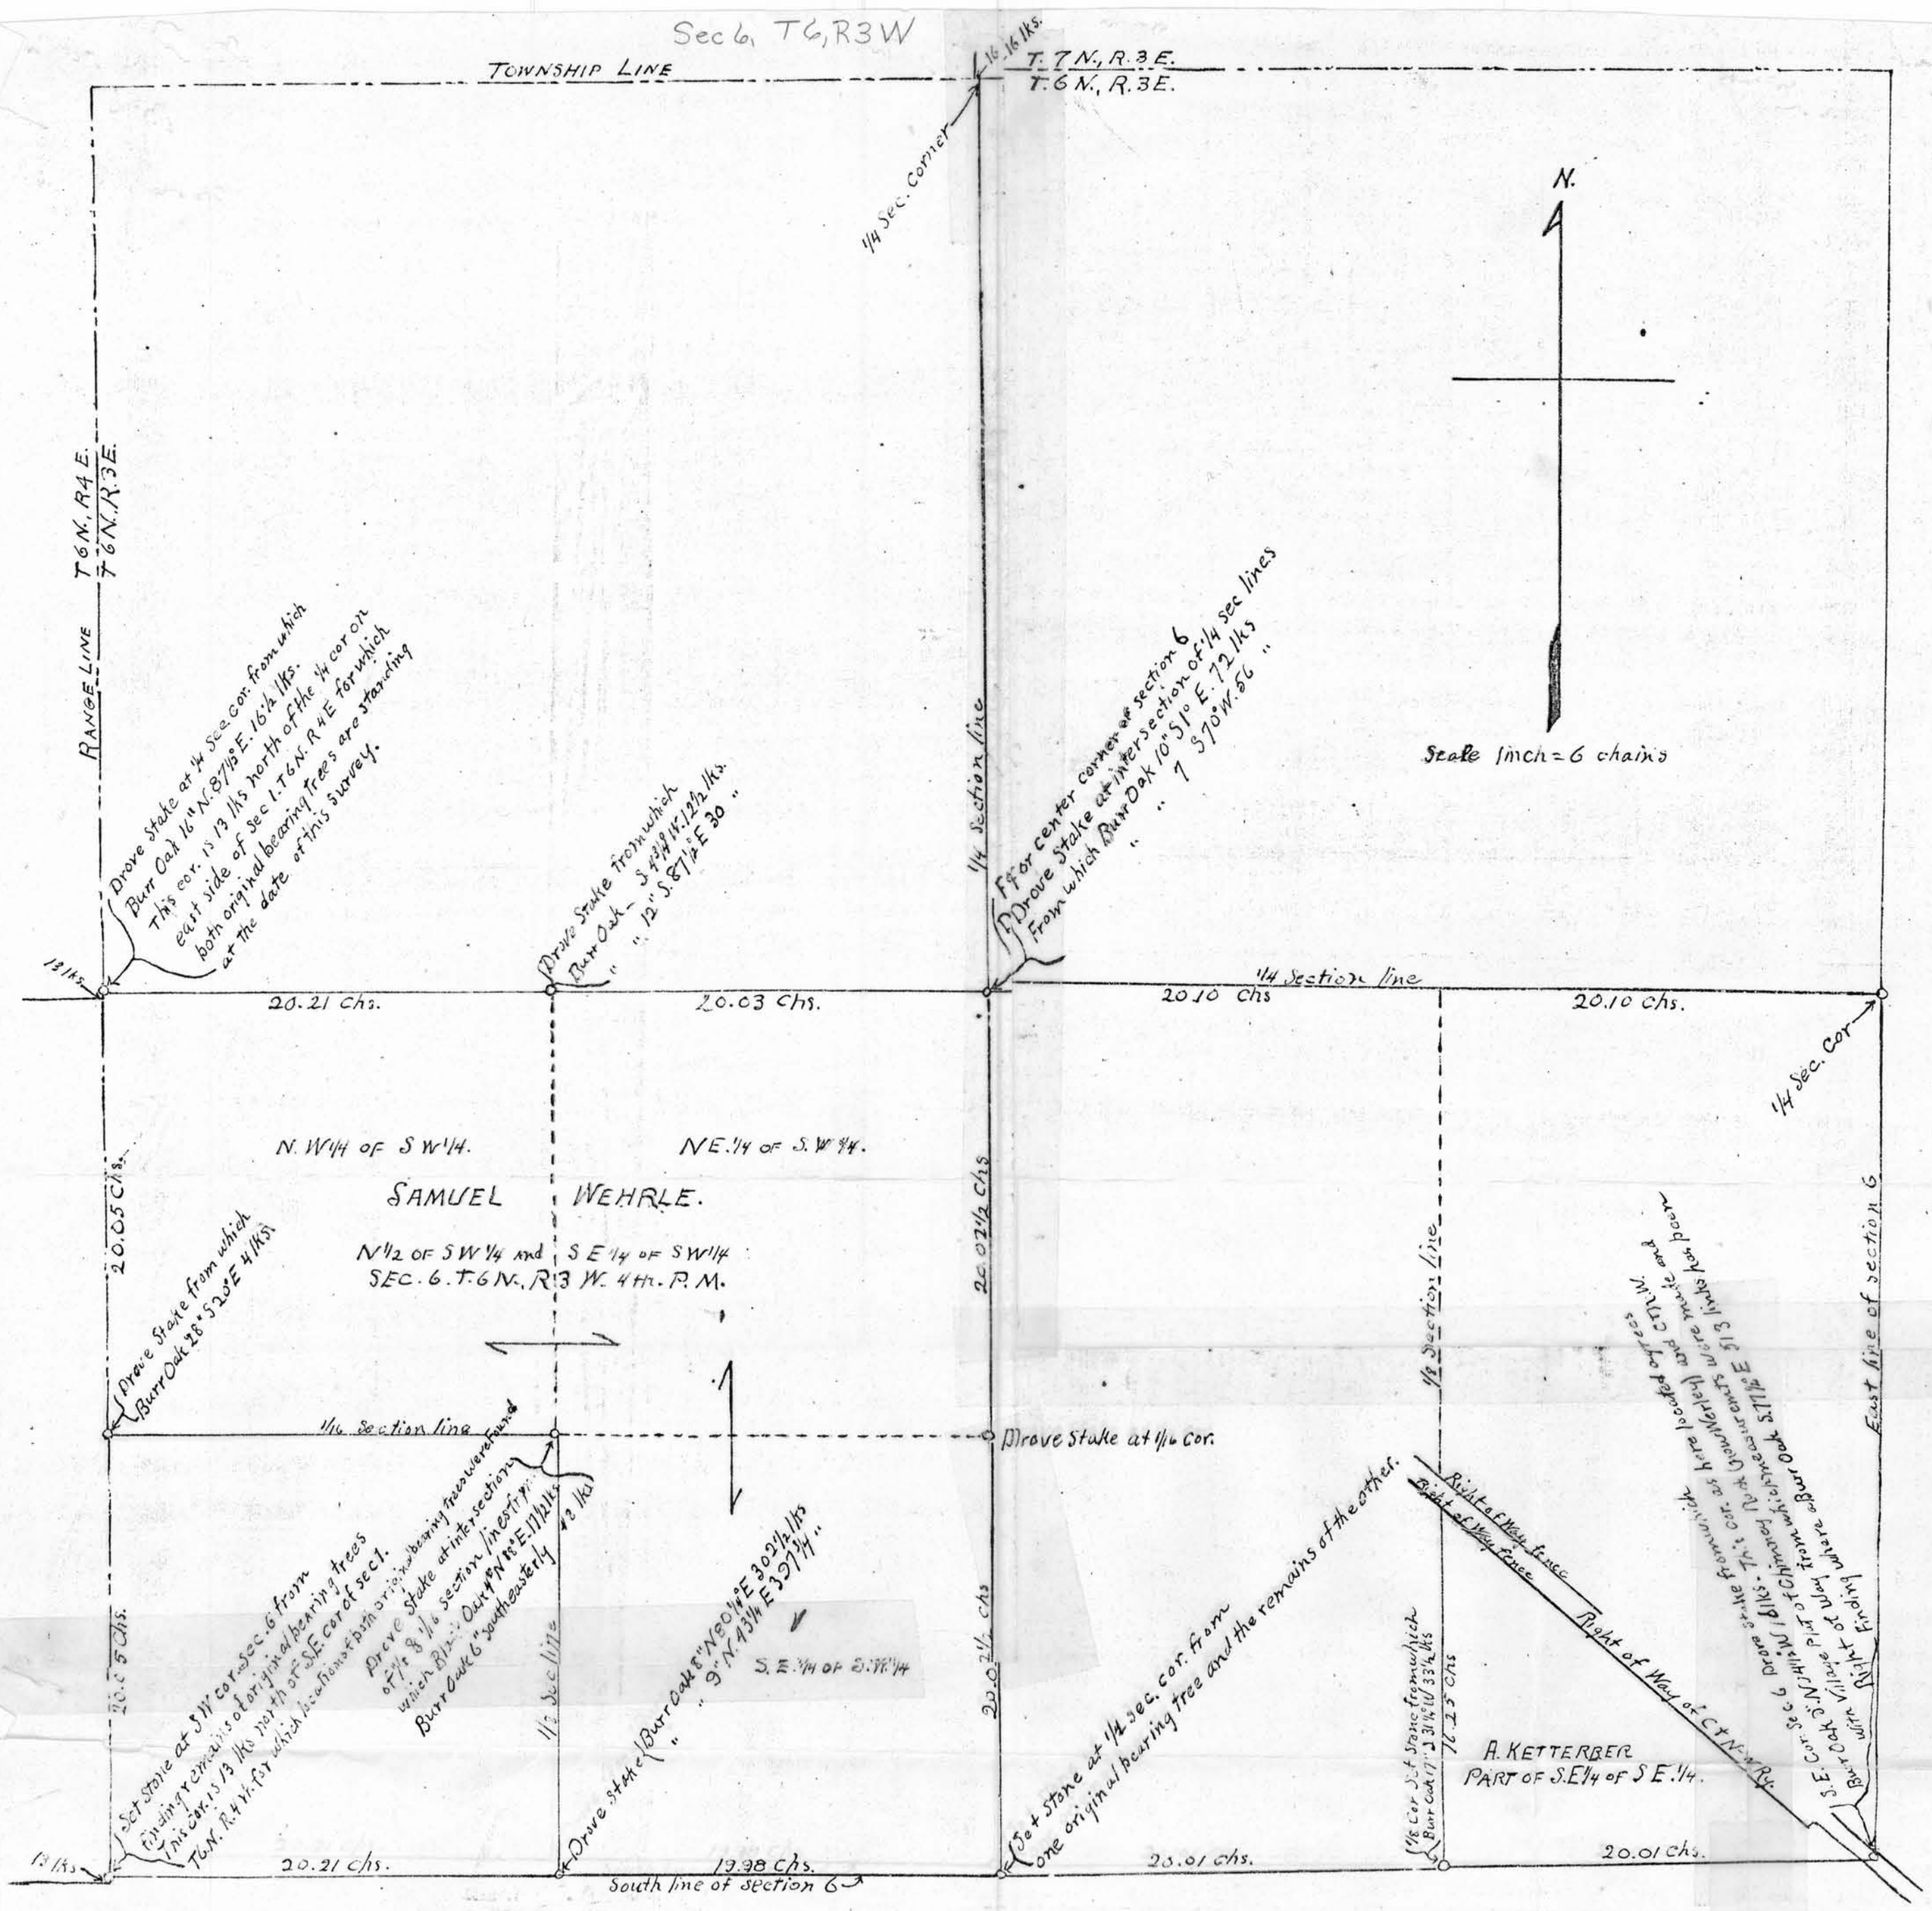
TOWNSHIP LINE
T. 7 N., R. 3 E.
T. 6 N., R. 3 E.
16.16 lks.
1/4 Sec. Corner
RANGE LINE
T 6 N., R 4 E.
T 6 N., R 3 E.
N.
Scale 1 inch = 6 chains
Drove Stake at 1/4 Sec. cor. from which Burr Oak 16" N. 87½° E. 16½ lks. This cor. is 13 lks north of the 1/4 cor on east side of Sec 1. T6N. R4E for which both original bearing trees are standing at the date of this survey.
13 lks.
Drove Stake from which Burr Oak - S. 4¾° W. 12½ lks. " " 12" S. 87½° E 30 "
1/4 Section line
For center corner of section 6
Drove Stake at intersection of 1/4 sec lines
From which Burr Oak 10" S 1° E. 72 lks
" " 7 S 70° W. 56 "
20.21 chs.
20.03 chs.
20.10 chs
20.10 chs.
1/4 Sec. Cor
N. W 1/4 of S W 1/4.
NE. 1/4 of S. W 1/4.
SAMUEL WEHRLE.
N 1/2 OF S W 1/4 and S E 1/4 OF S W 1/4
SEC. 6. T. 6 N., R. 3 W. 4 TH. P. M.
20.05 chs.
20.02½ chs
Drove Stake from which Burr Oak 28" S 20° E 4 lks.
1/16 Section line
Drove Stake at 1/16 Cor.
1/8 Section line
East line of section 6
Set stone at S W cor sec. 6 from finding remains of original bearing trees. This cor. is 13 lks north of SE cor of sect. T6N. R4W. for which locations both original bearing trees were found
Drove Stake at intersection of 1/8 & 1/16 section lines
which Black Oak 4° N 88° E. 17½ lks
Burr Oak 6" southeasterly
13 lks
1/8 Sec. Line
Drove Stake {Burr Oak 8" N 80½° E 30½ lks " 9" N. 43¼ E 32¾ "
S. E. 1/4 of S. W. 1/4
20.02½ chs
Set stone at 1/4 sec. cor. from one original bearing tree and the remains of the other.
Right of Way fence
Right of Way fence
1/8 Cor Set Stone from which Burr Oak 17" S 31½° W 33½ lks
16.25 chs
A. KETTERBER
PART OF S.E 1/4 of S E. 1/4.
