RECEIVED

DEC 21 1984

95

SURVEY PLAT

Sec 34, T3N, R3W

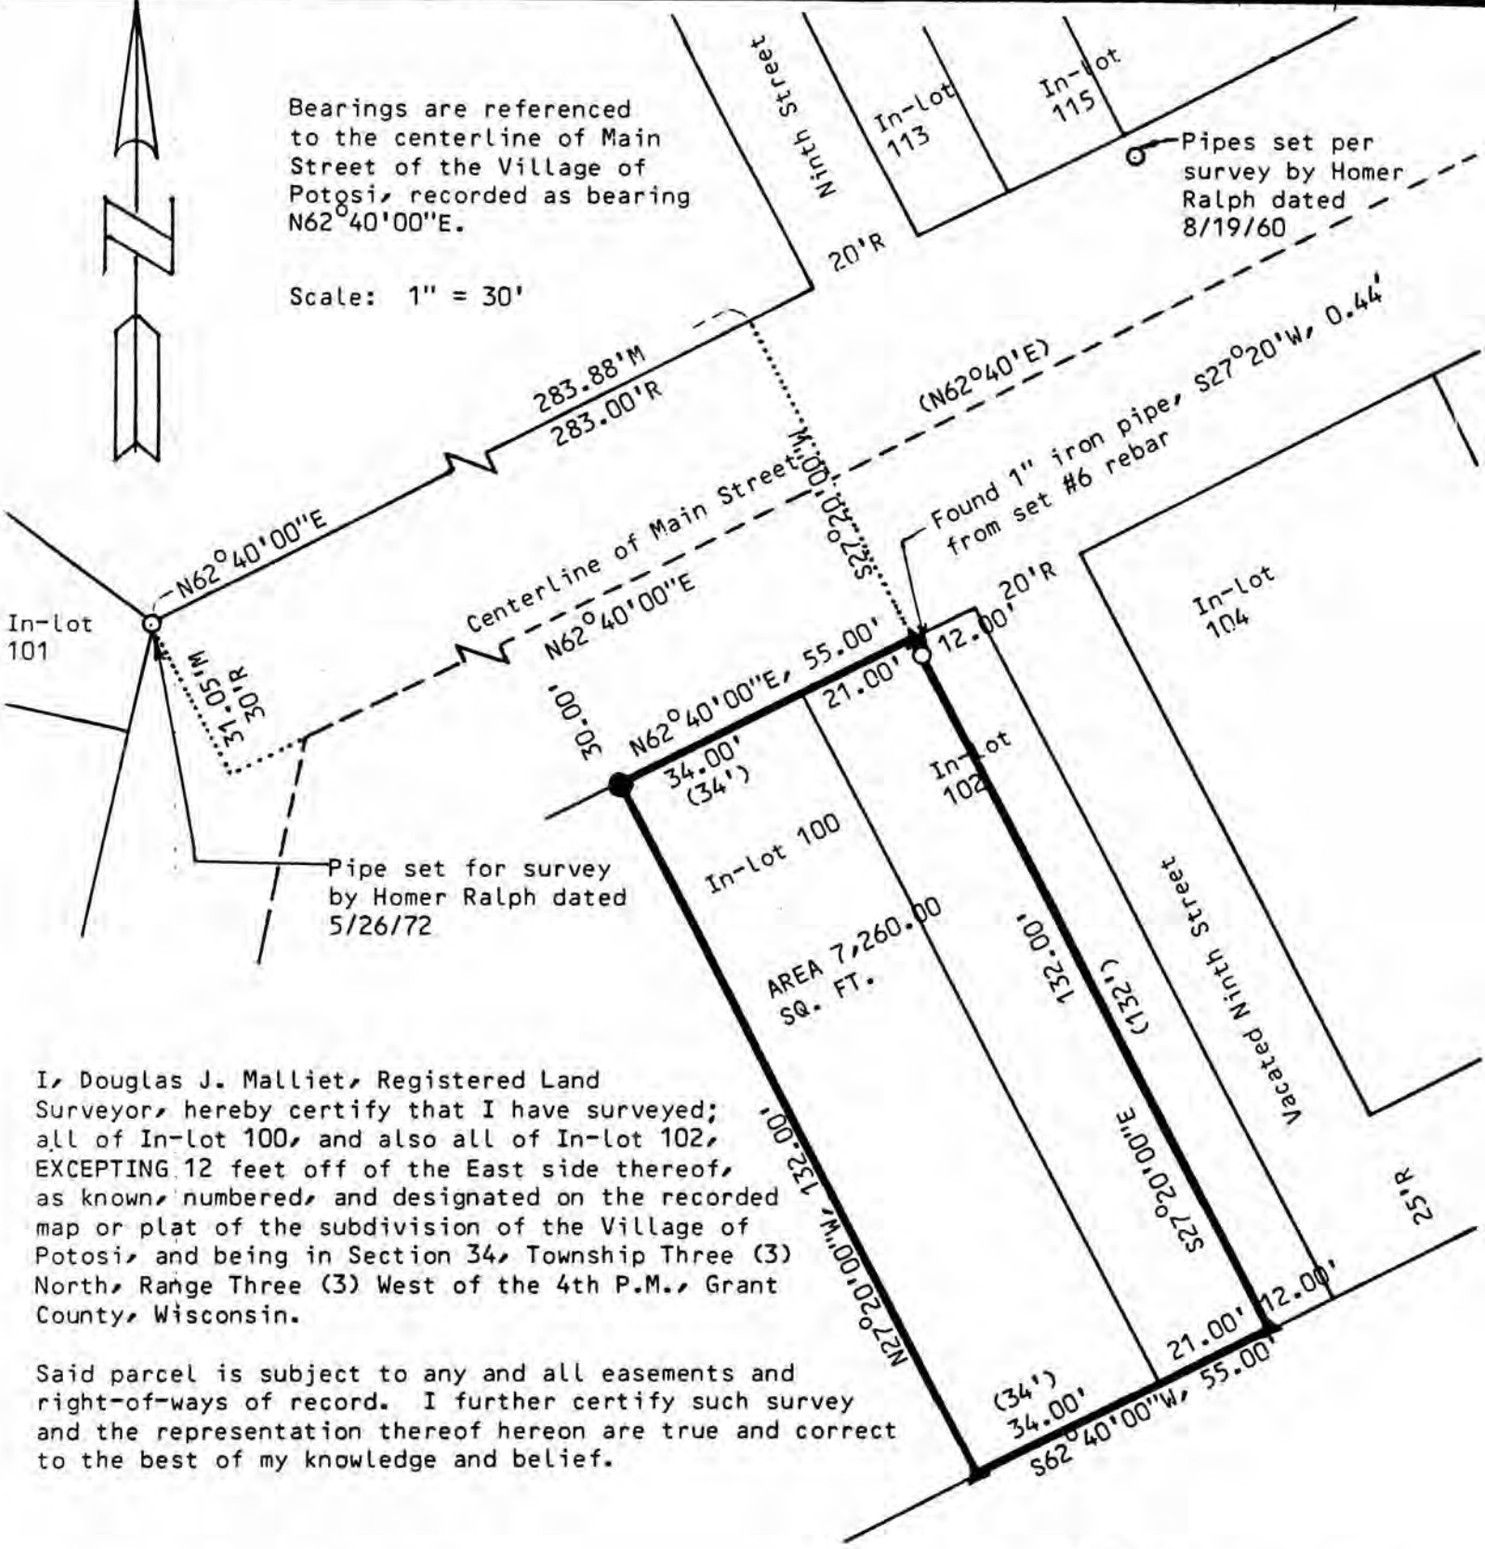

I, Douglas J. Malliet, Registered Land Surveyor, hereby certify that I have surveyed; all of In-lot 100, and also all of In-lot 102, EXCEPTING 12 feet off of the East side thereof, as known, numbered, and designated on the recorded map or plat of the subdivision of the Village of Potosi, and being in Section 34, Township Three (3) North, Range Three (3) West of the 4th P.M., Grant County, Wisconsin.

Said parcel is subject to any and all easements and right-of-ways of record. I further certify such survey and the representation thereof hereon are true and correct to the best of my knowledge and belief.

Douglas J. Malliet

Douglas J. Malliet, S-1266
Registered Land Surveyor
March 9, 1985

WISCONSIN
DOUGLAS J. MALLIET
S-1266
PLATTEVILLE
WIS.
LAND SURVEYOR

LEGEND

▲ = Set 3/4" x 24" round iron bar; min. wt. = 1.50 lbs./lin. ft.

● Set 1/2" drill hole in concrete

O = Found 1" iron pipe

( ) or R = Recorded

Surveyed for:

Potosi State Bank
Potosi, Wisconsin

D. F. BURBACH MUNICIPAL & CIVIL ENGINEERS

BOX 96B, HIGHWAY 80 SOUTH • PLATTEVILLE, WISCONSIN 53818 • (608) 348-3262