City of Platteville | Lots 13, 14, 15 & Jones Addition

SURVEY PLAT

REC'D JAN 24 1994

73

U.W.P— PLANNING DEPT.
(JAY ST. PARKING LOT)

DESCRIPTION PROVIDED:

LOTS, 13, 14, AND 15 OF JONES' ADDITION, CITY OF PLATTEVILLE, GRANT COUNTY, WISCONSIN.

SURVEYORS CERTIFICATE: I, LARRY L. AUSTIN, REGISTERED WISCONSIN LAND SURVEYOR, DO HEREBY CERTIFY THAT I HAVE SURVEYED, MAPPED AND MONUMENTED THAT PROPERTY SHOWN HEREON IN ACCORDANCE WITH THE INSTRUCTIONS OF PLANNING DEPT., U.W. OF WISCONSIN, PLATTEVILLE, AND TO THE BEST OF MY KNOWLEDGE AND BELIEF, THIS PLAT IS AN ACCURATE REPRESENTATION THEREOF.

Larry L. Austin — 6/22/93

LARRY L. AUSTIN RLS 1903 — DATE

LARRY AUSTIN ENGINEERING
RT. 2
LANCASTER, WI. 53813
PHONE: (608) 723-6363

BEARING REFERENCE: FOR PURPOSES OF THIS SURVEY, BEARINGS ARE REFERENCED TO THE EAST LINE OF JAY STREET, WHICH IS ASSUMED TO BEAR N 01°55'09" W.

WISCONSIN
LARRY L. AUSTIN
S-1903
LANCASTER
WI
LAND SURVEYOR
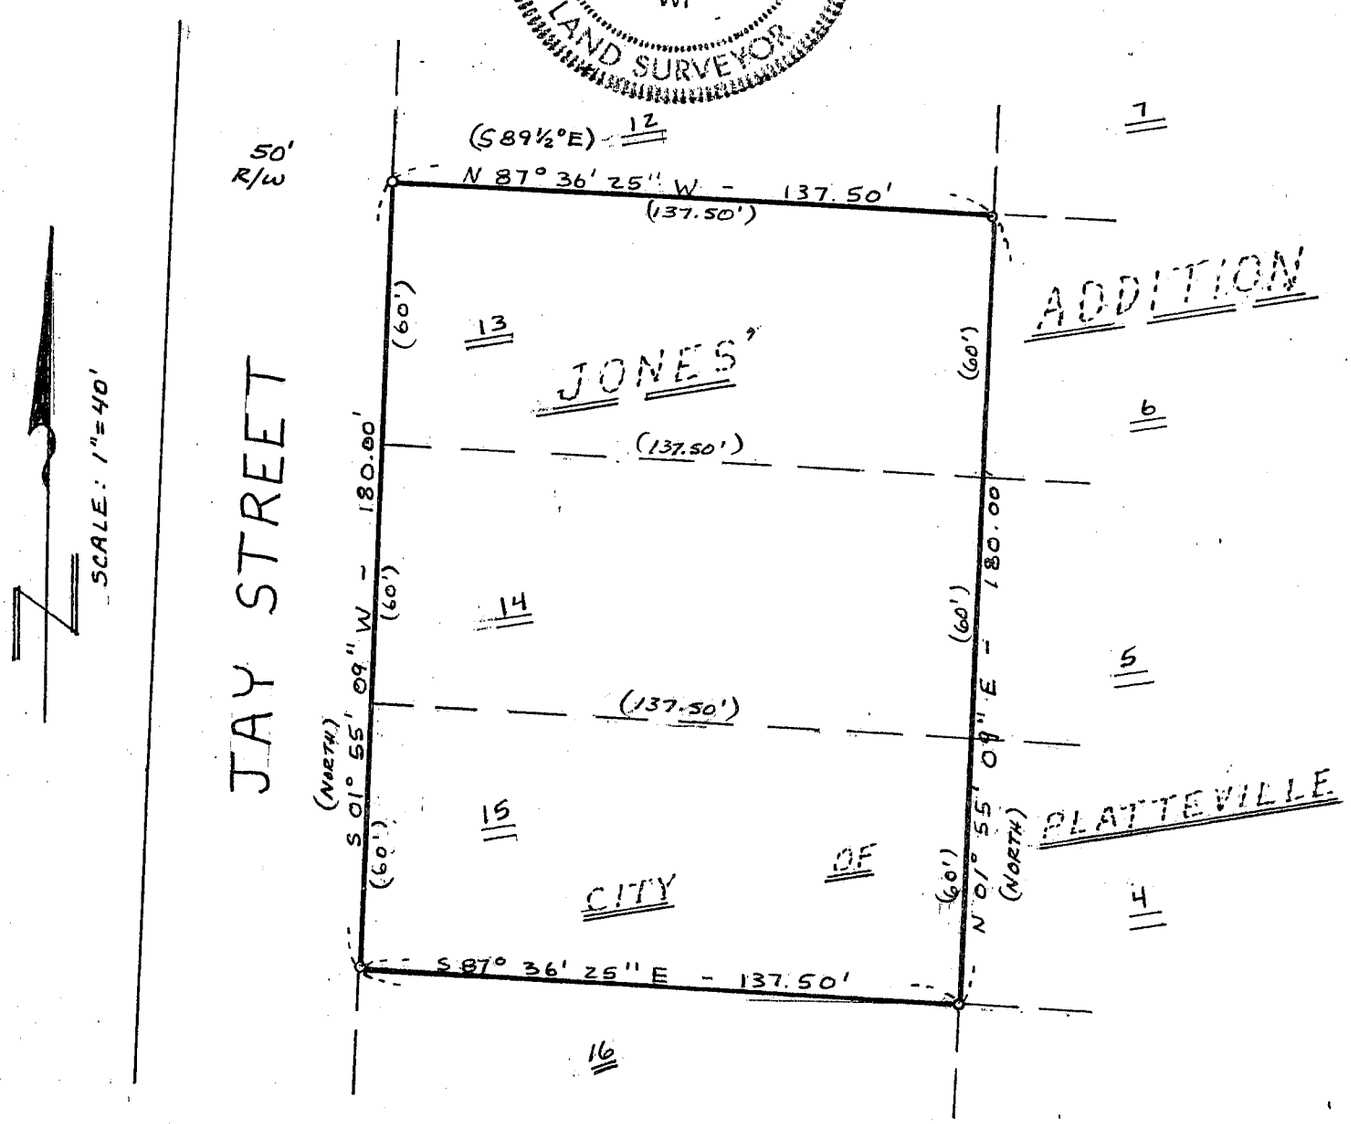
LEGEND
o 3/4"X24" RD BAR SET