SURVEY PLAT

SHEET 1 OF 1

RON JAACKS

2

REC'D JUL 5 1994

LEGEND

- ▲ 3/4" IRON BAR FOUND
- ● 1" IRON PIPE FOUND
- ○ 1" x 24" IRON PIPE SET
- ( ) REC. BRGS./DISTS.

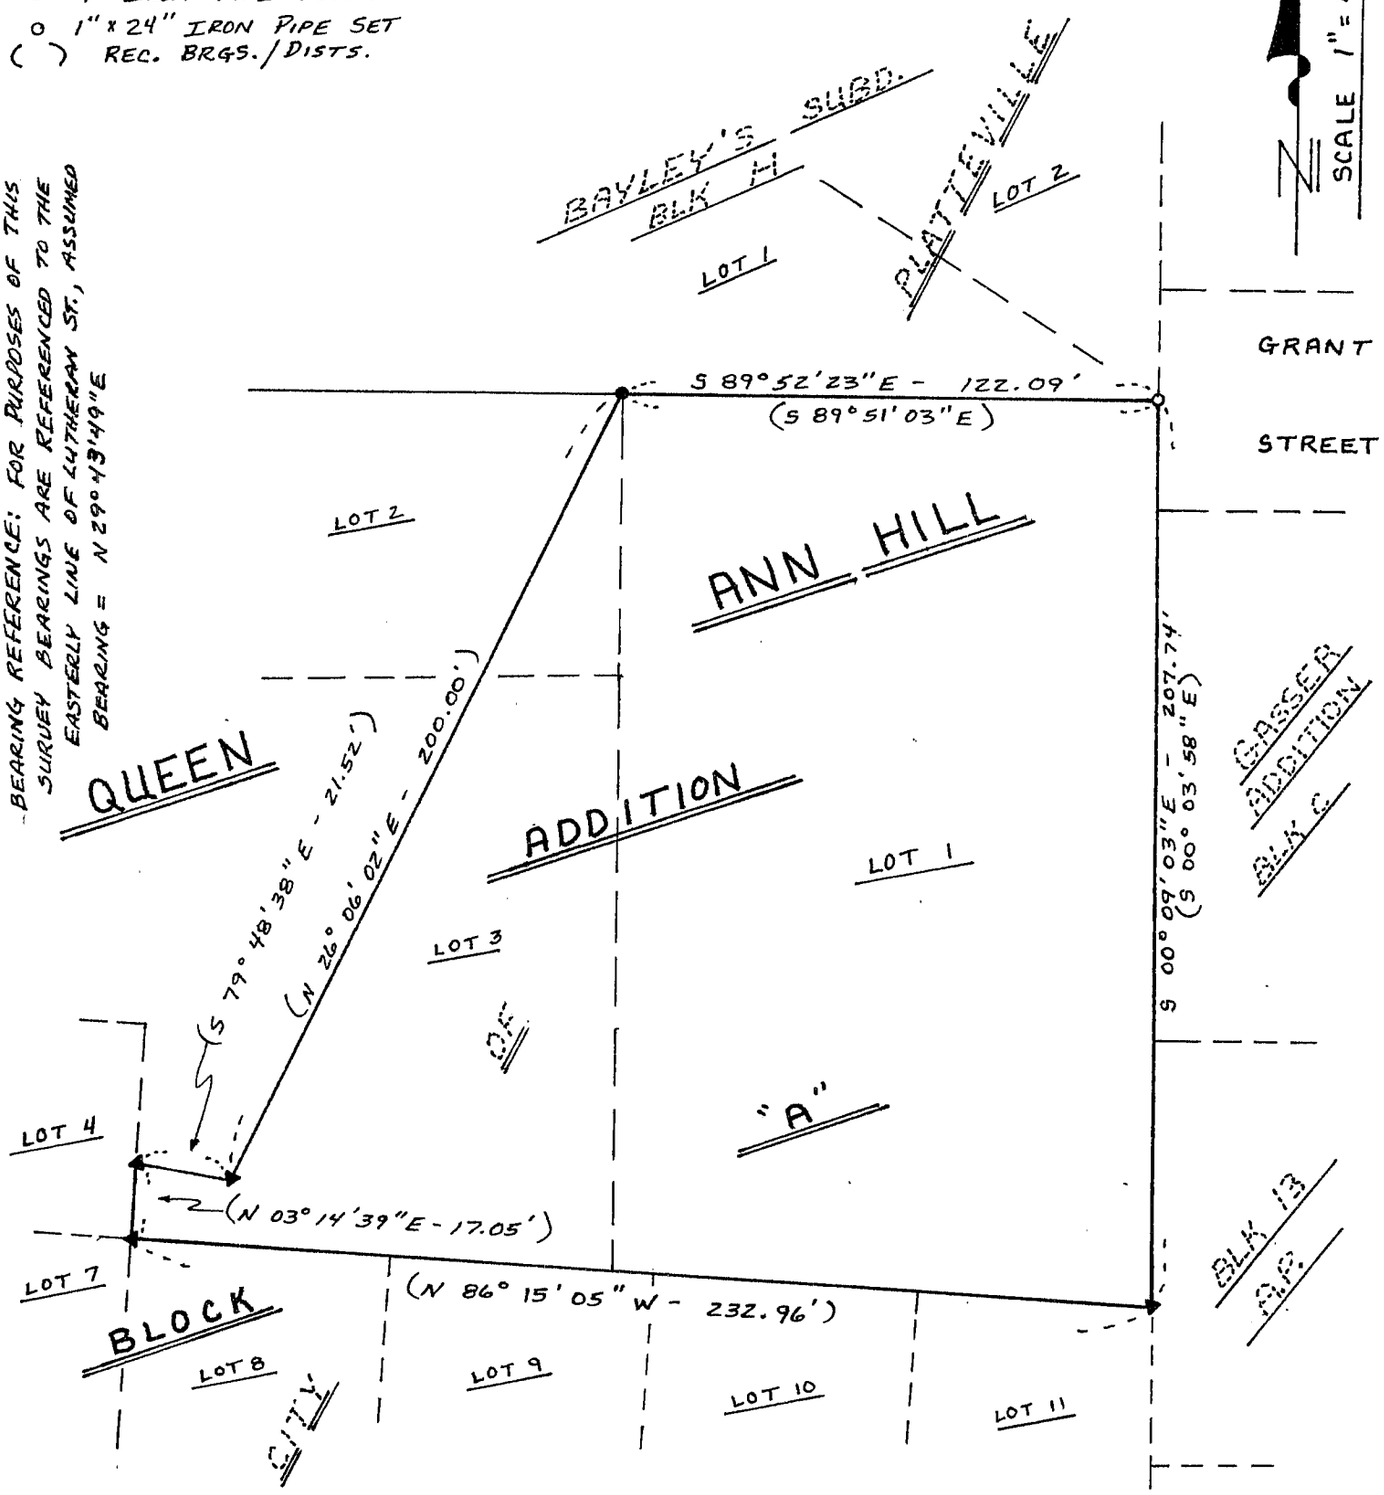

OF THE RE-ESTABLISHMENT OF THE NE CORNER OF THAT PARCEL SURVEYED BY DOUG MALLIET IN 1985 FOR VIOLA WEBSTER AND DEVONA SPINK.

SURVEYOR'S CERTIFICATE: I, LARRY L. AUSTIN, REGISTERED WISCONSIN LAND SURVEYOR, DO HEREBY CERTIFY THAT THIS RETRACEMENT SURVEY WAS PERFORMED BY ME OR UNDER MY DIRECT SUPERVISION, UNDER THE DIRECTION OF RON JAACKS OF PLATTEVILLE, AND TO THE BEST OF MY KNOWLEDGE AND BELIEF THIS PLAT IS AN ACCURATE REPRESENTATION THEREOF.

Larry L. Austin

LARRY L. AUSTIN RLS 1903
LARRY AUSTIN ENGINEERING
RT. 2
LANCASTER, WI. 53813
PHONE: (608) 723-6363

WISCONSIN LARRY L. AUSTIN S-1903 LANCASTER WI LAND SURVEYOR

2/14/1995
DATE