NF 30

[illegible] PROPERTY
2/28/75

Commencing at the NE corner of the SE¼ of the NE¼ of Sec. 15, T5N, R3W, 4th P.M. Grant County, Wisconsin; thence S 00°09'W, 625.64 ft. along the East section line of Sec. 15 to the centerline of the town road; thence S 39°46 W, 1031.94 ft. along said centerline; thence S 41°35'W, 1072.91 ft. along said centerline to the point of beginning; thence S 41°35'W, 589.24 ft. along said centerline to the South line of the NW¼ of the SE¼ of Sec. 15.; thence N 89°30'W, 910.46 ft. along said South line to the SW corner of the NW¼ of the SE¼ of Sec. 15; thence North, 720.00 ft. to the centerline of the creek; thence N 52°15'E, 388.55 ft. along the centerline of the creek; thence S 62°02'E, 1125.72 ft. to the centerline of the town road, the point of beginning, containing 20 acres, more or less.

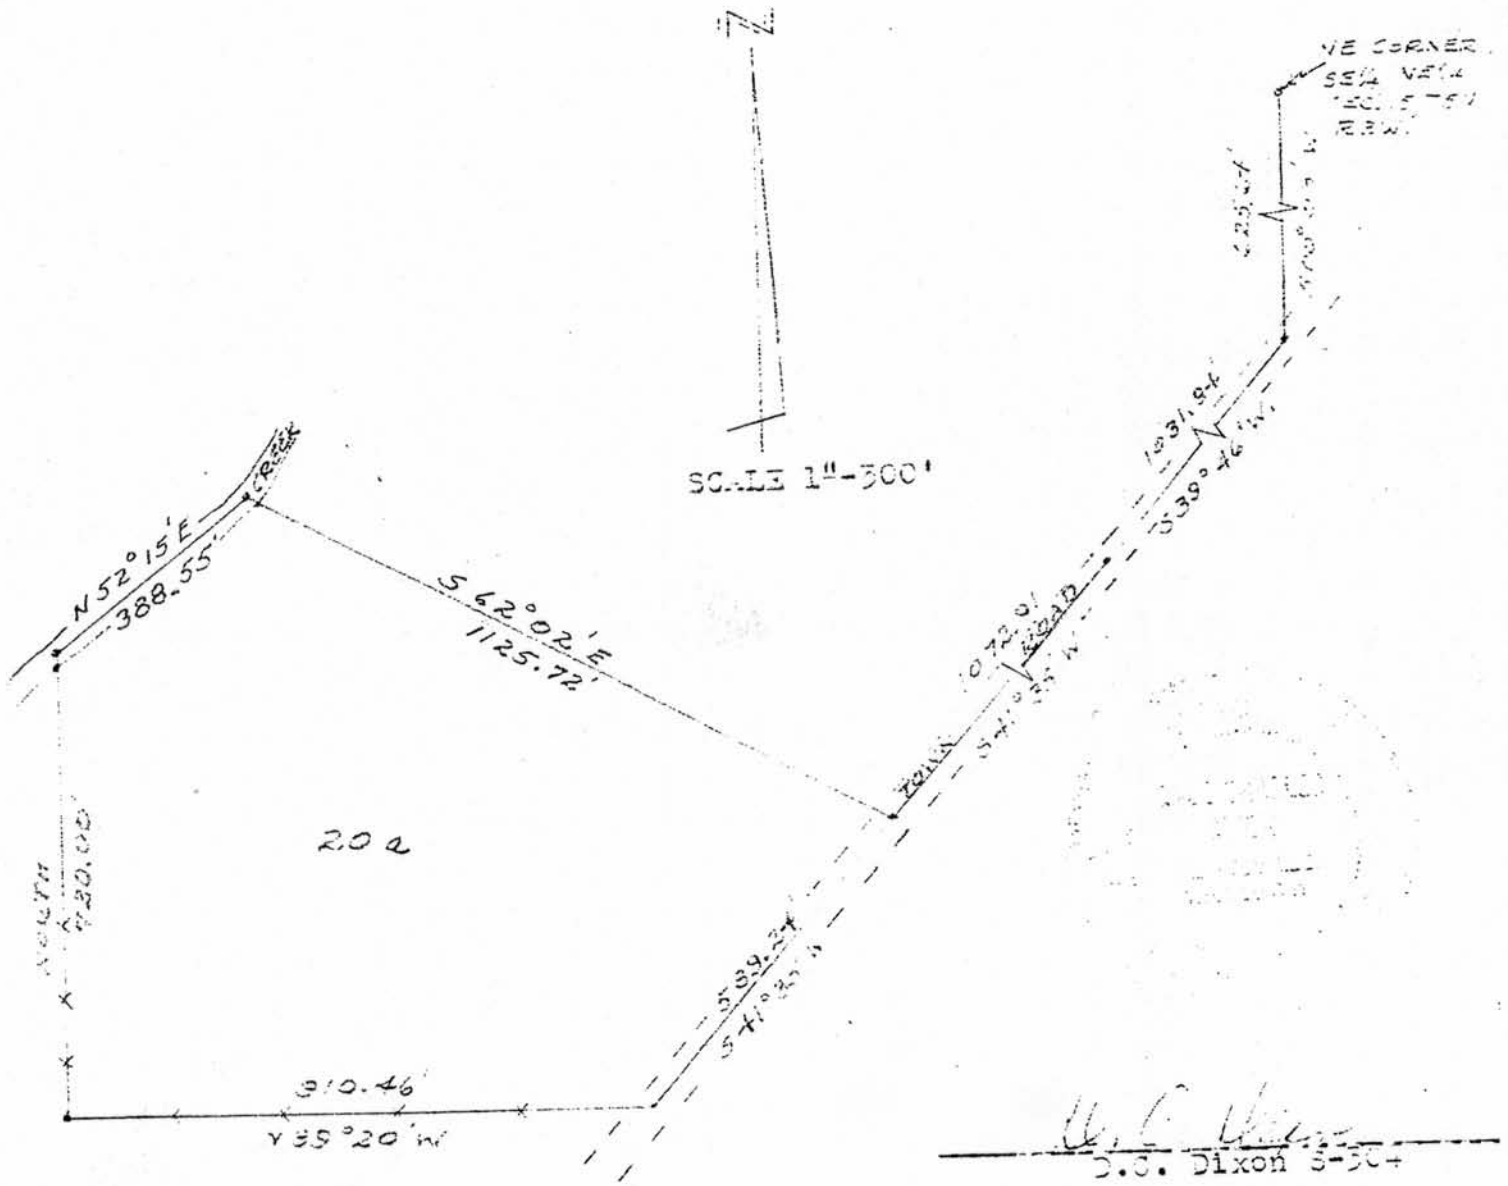


Sec 15
T5N R3W

Mr Brooks C Ott
11041 Mount Ridge Rd