GRANT COUNTY

POTOSI

Section Summary

5 - 2 North - 3 West

SECTION TOWN RANGE

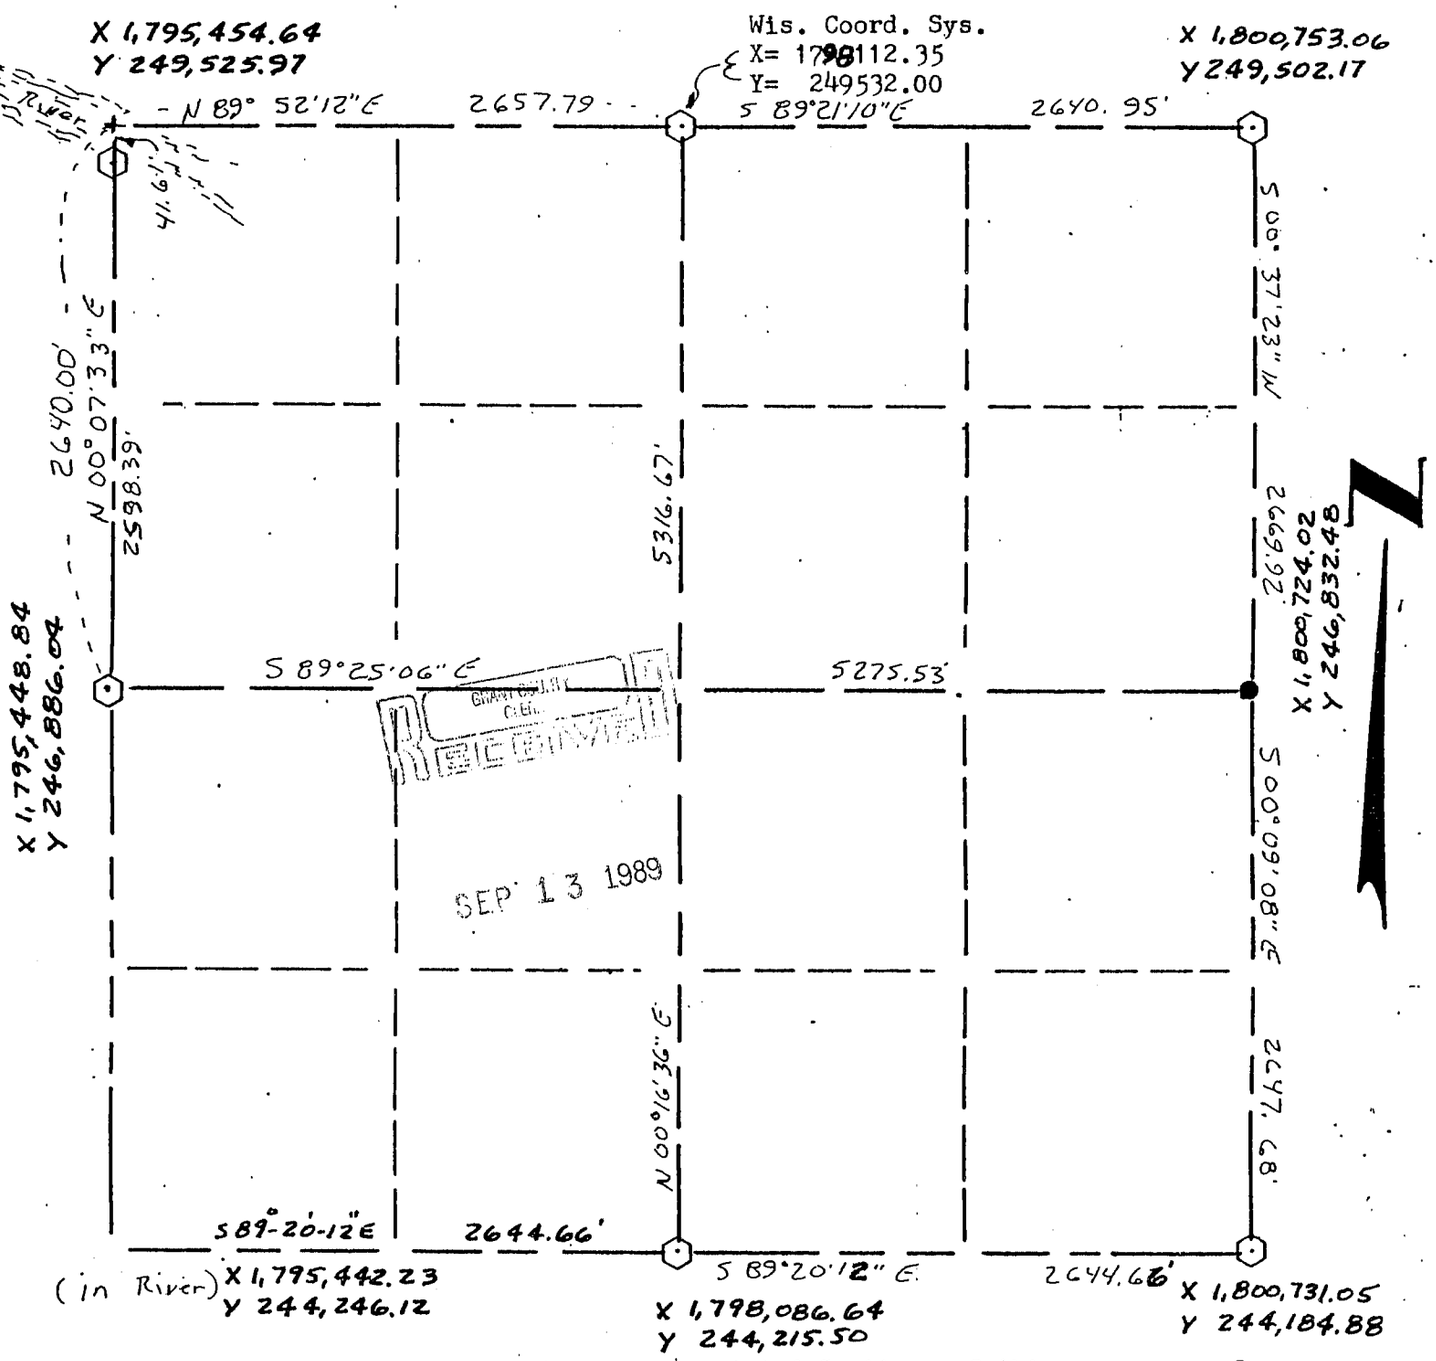

Note: in referring to coordinates on related Sections of this survey, scale factor of .9999739 used.

LEGEND

- △ COUNTY MONUMENT
- □ STONE OR CONCRETE MONUMENT
- ● OTHER (specify) 1" Iron Pipe (found)
- ⊙ Wis. Dept. of Transportation 2" X 30" Aluminum Monument w/cap (set)

NOTE:

Relationships of all section corners to other section corners shall be shown hereon by bearing and distance or grid coordinates

Show or describe bearing reference
Wis. coordinate system, South Zone

F. Curtis Crook RLS #1292
(Readstown Wi., 54652)
608-629-5429

FORM LC 103 F. Curtis Crook 5-25-89

WISCONSIN F. CURTIS CROOK S-1292 READSTOWN WIS. LAND SURVEYOR