GRANT COUNTY

Potosi Twp

Section Summary

SEP 13 1989

6	- 2 North	- 3 West
SECTION	TOWN	RANGE

Wis. Coord. Sys.
X= 1790151.56
Y= 249680.92

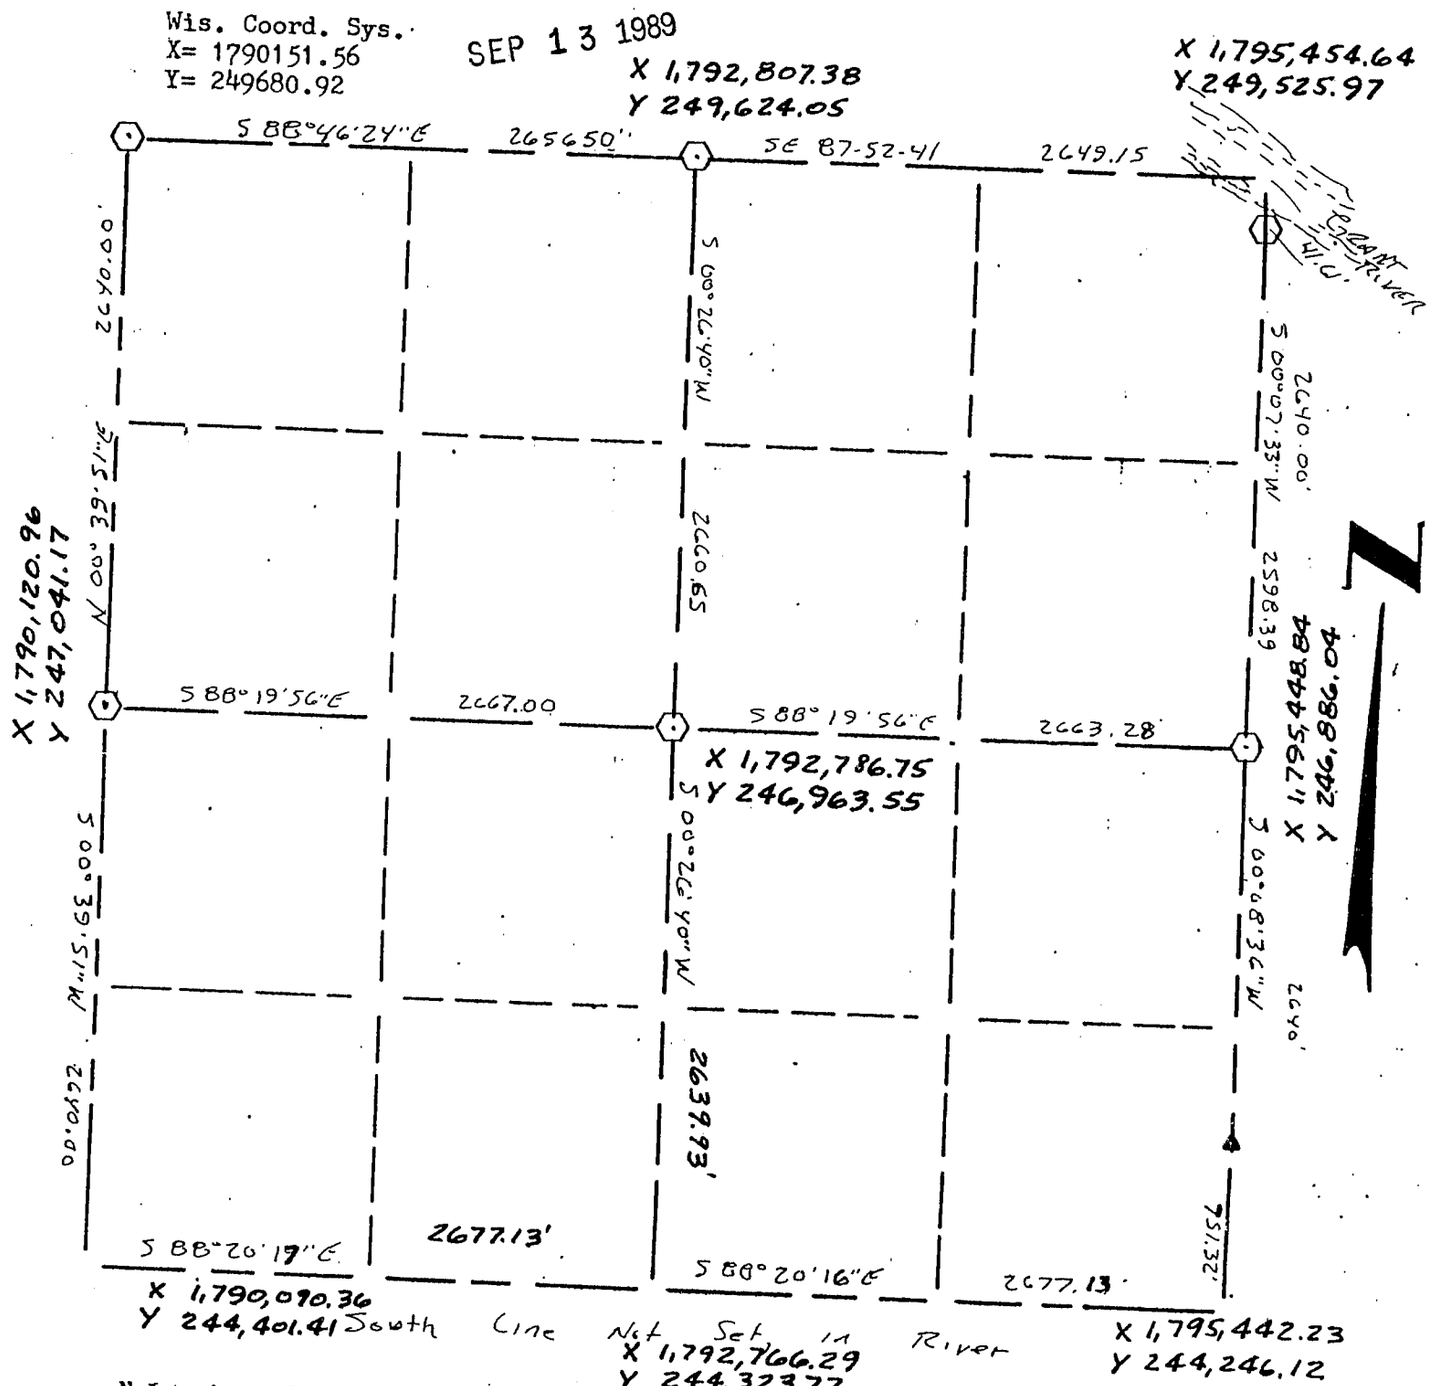

Note: in referring to coordinates on related Sections of this survey, scale factor of .9999739 used.

LEGEND

- ▲ ~~CORNER~~ MONUMENT, Corps of Engineers (found)
- □ STONE OR CONCRETE MONUMENT
- ○ OTHER (specify) _____

Wis. Dept. of Transportation
2" X 30" Aluminum Monument w/cap (set)

NOTE:

Relationships of all section corners to other section corners shall be shown hereon by bearing and distance or grid coordinates

Show or describe bearing reference
Wis. coordinate system, South Zone

F. Curtis Crook RLS #1292
(Readstown Wi., 54652)
608-629-5429

F. Curtis Crook
5-24-89

WISCONSIN F. CURTIS CROOK S-1292 READSTOWN WIS. LAND SURVEYOR

FORM LC 103