GRANT COUNTY

Survey Monument Record

CORNER NO. 97
SECTION 28
TOWN 3 N
RANGE 1 W
E 1/4 COR.

TYPE OF MONUMENT 3/4" x 24" IRON BAR
STATE PLANE COORDINATES: N —
E —
ELEVATION — M.S.L. DATUM: —
THETA ANGLE: —
FIELD BOOK: 9404
PAGE 6

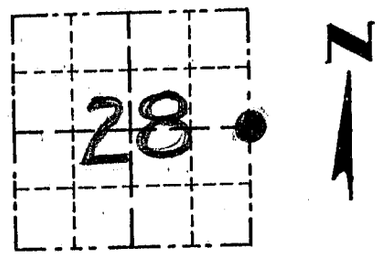

LOCATION
(Indicated by "●")

BASIS FOR MONUMENT LOCATION

(Use reverse side if necessary)

Show info such as: History of corner, with reference to Vol. and pg., dates, surveyor; exact description of monument replaced; if location computed, by taped or EDM traverse; landowner, remarks, etc.

CORNER ORIGINALLY SET BY LUCIUS LYON IN 1832; ONLY RECORD FOUND OF CORNER SINCE ORIGINAL SURVEYS IS ON 1968 D.O.T. PROJ 50207.(3) - C.T.H. "D" PLANS. I SET THE CORNER AT ℄ C.T.H. "D" & MIDWAY BETWEEN NE COR & SE CORNER OF THE SECTION; VERIFIED BY EDM TRAVERSE OF THE AREA.

SEAL:

WISCONSIN
LARRY L. AUSTIN
S-1903
LANCASTER
WI
LAND SURVEYOR

CERTIFIED CORRECT
Larry L. Austin
Registered Land Surveyor
DATE: 2/6/95

TIE SKETCH

Show at least three (3) ties and monument

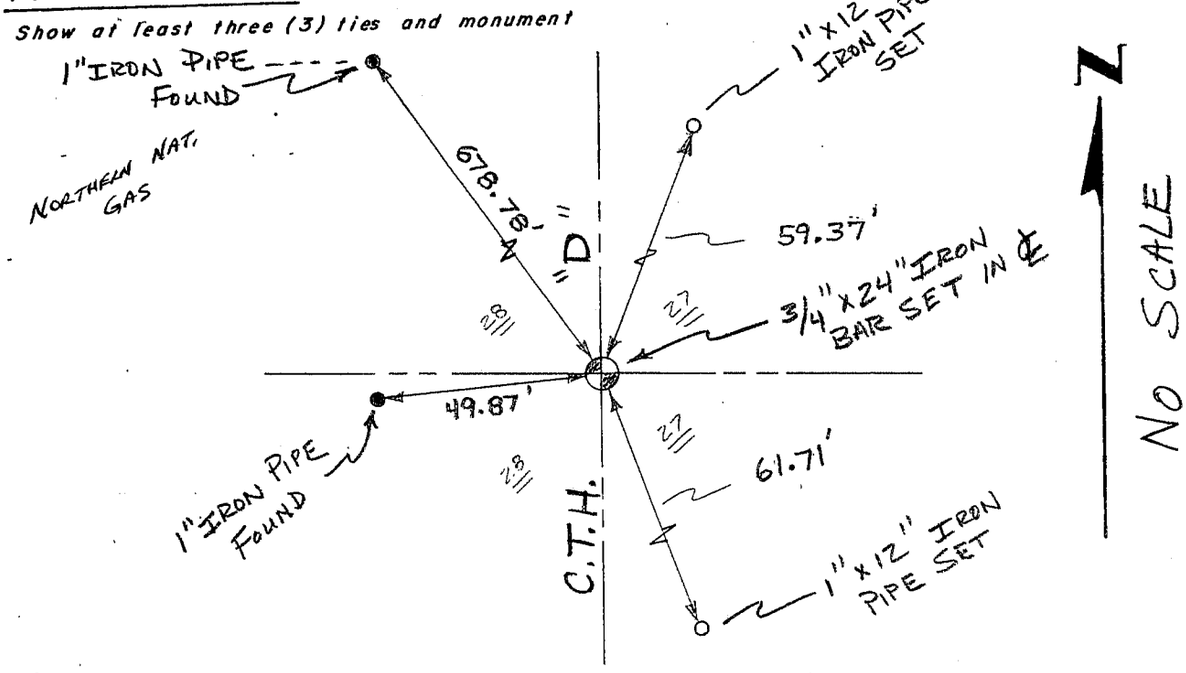

97

FORM LC 102