GRANT COUNTY
CERTIFIED LAND CORNER

CORNER NUMBER 60

CERTIFICATE:

I, Larry L. Austin, do hereby certify that on the 16th day of March, 2000, I found evidence of the East 1/4 corner of Section 13, Town 3 North, Range 2 West, of the 4th Principal Meridian, and I re-established said corner according to the Wisconsin statutes as shown and described hereon.

Dated this 16th day of April, 2000

Larry L. Austin S-1903

WISCONSIN
LARRY L.
AUSTIN
S-1903
LANCASTER
WI
LAND SURVEYOR
SEAL

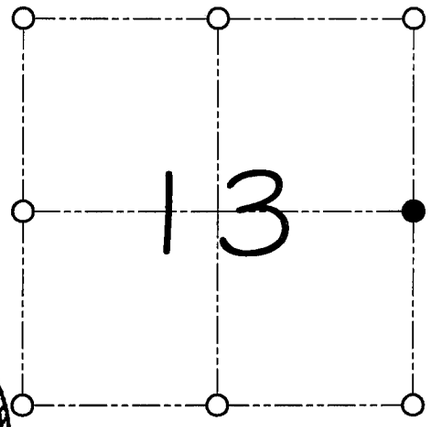

● = CORNER LOCATION

EAST 1/4 CORNER OF
SECTION 13, T 3 N R 2 W
TOWN OF HARRISON

HISTORY OF ORIGINAL CORNER ESTABLISHMENT:

Corner was originally set in 1832 by Lucius Lyon.
In 1898 Sampson found substantial evidence of the corner.

DESCRIPTION OF CORNER EVIDENCE FOUND:

I found an existing 1" iron pipe at this location and did not accept it's location. I reset the corner based on proportioned offset from the West 1/4 of Section 18. Verified this location using E.D.M. & G.P.S. methods.

DESCRIPTION OF CORNER AND WITNESS MONUMENTS, references and accessories used to perpetuate the original or re-established location of this corner

WITNESS TO THE CORNER LOCATION: BOBBY SEDGWICK & SHELBY BLINDERT
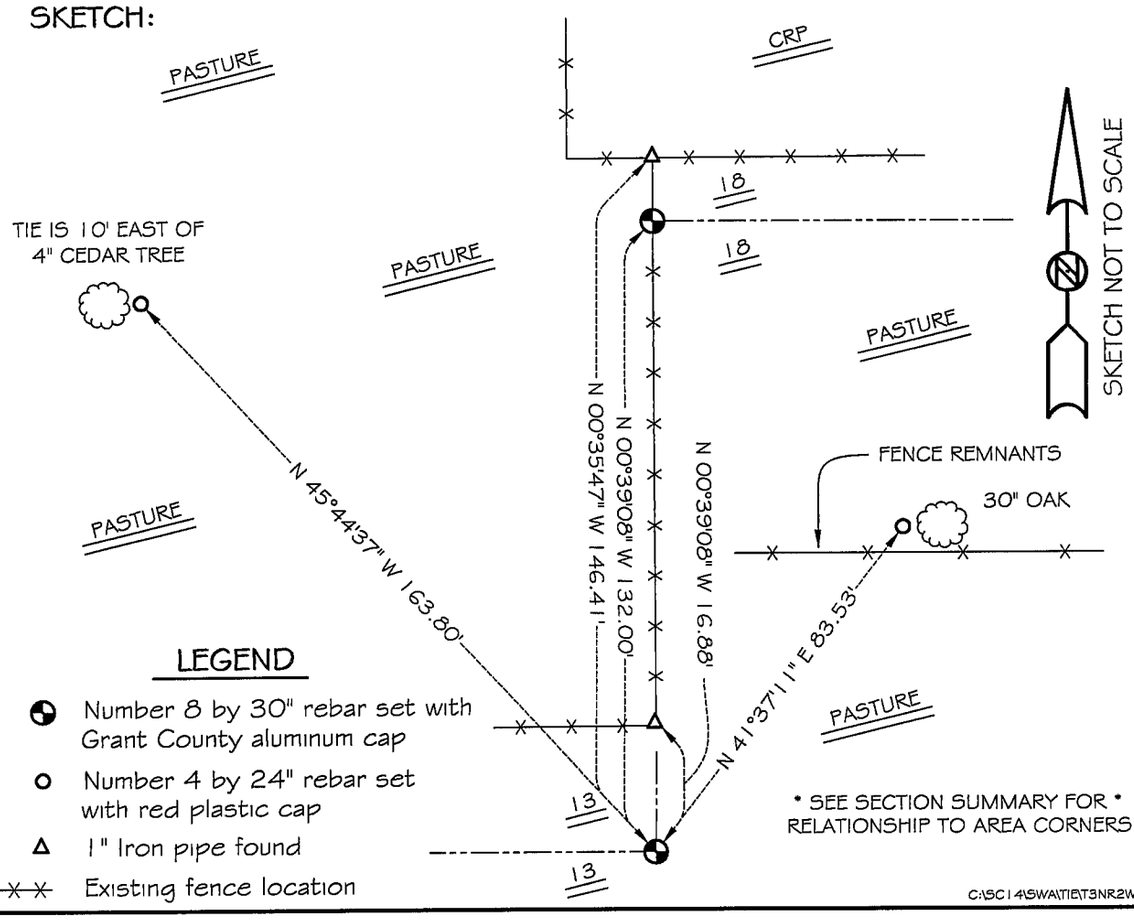
SKETCH: