SECTION CORNER TIE SHEET INDEX

T. 3 N., R. 3 W

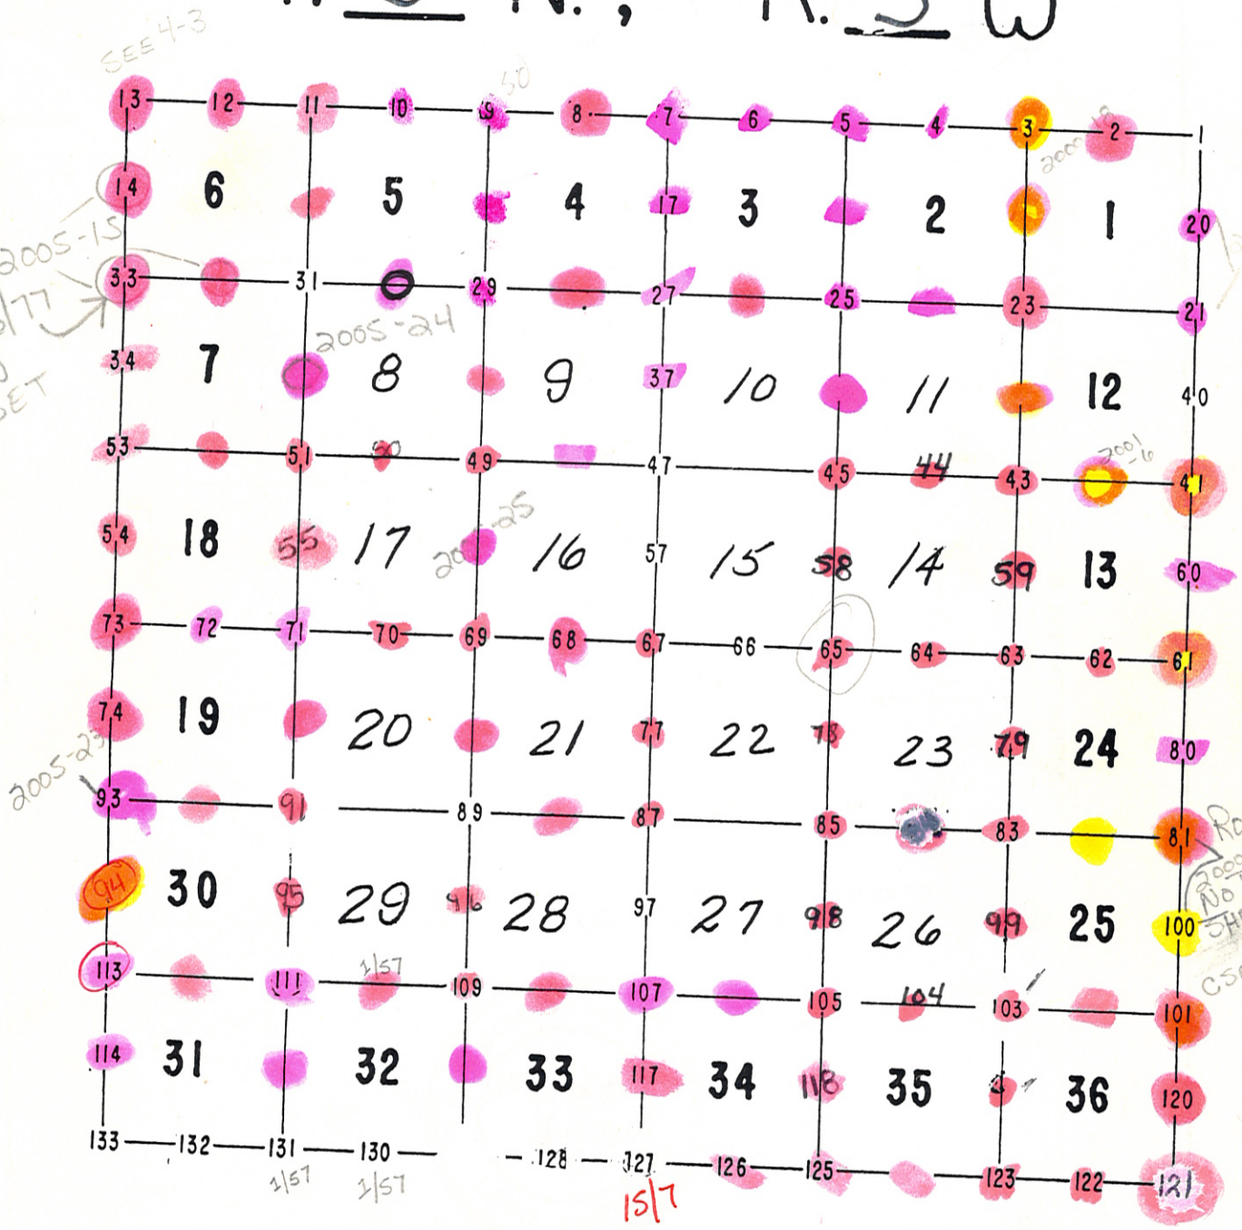

89-1-06

CEN 30 IP ?

Page #
"A"